


File Name: P:\2010\20100195\Drawings\Bldg 3\3Sheet\95F.03.2c.dwg Last Plotted: 2010/11/01 @ 12:23 PM By: jdd


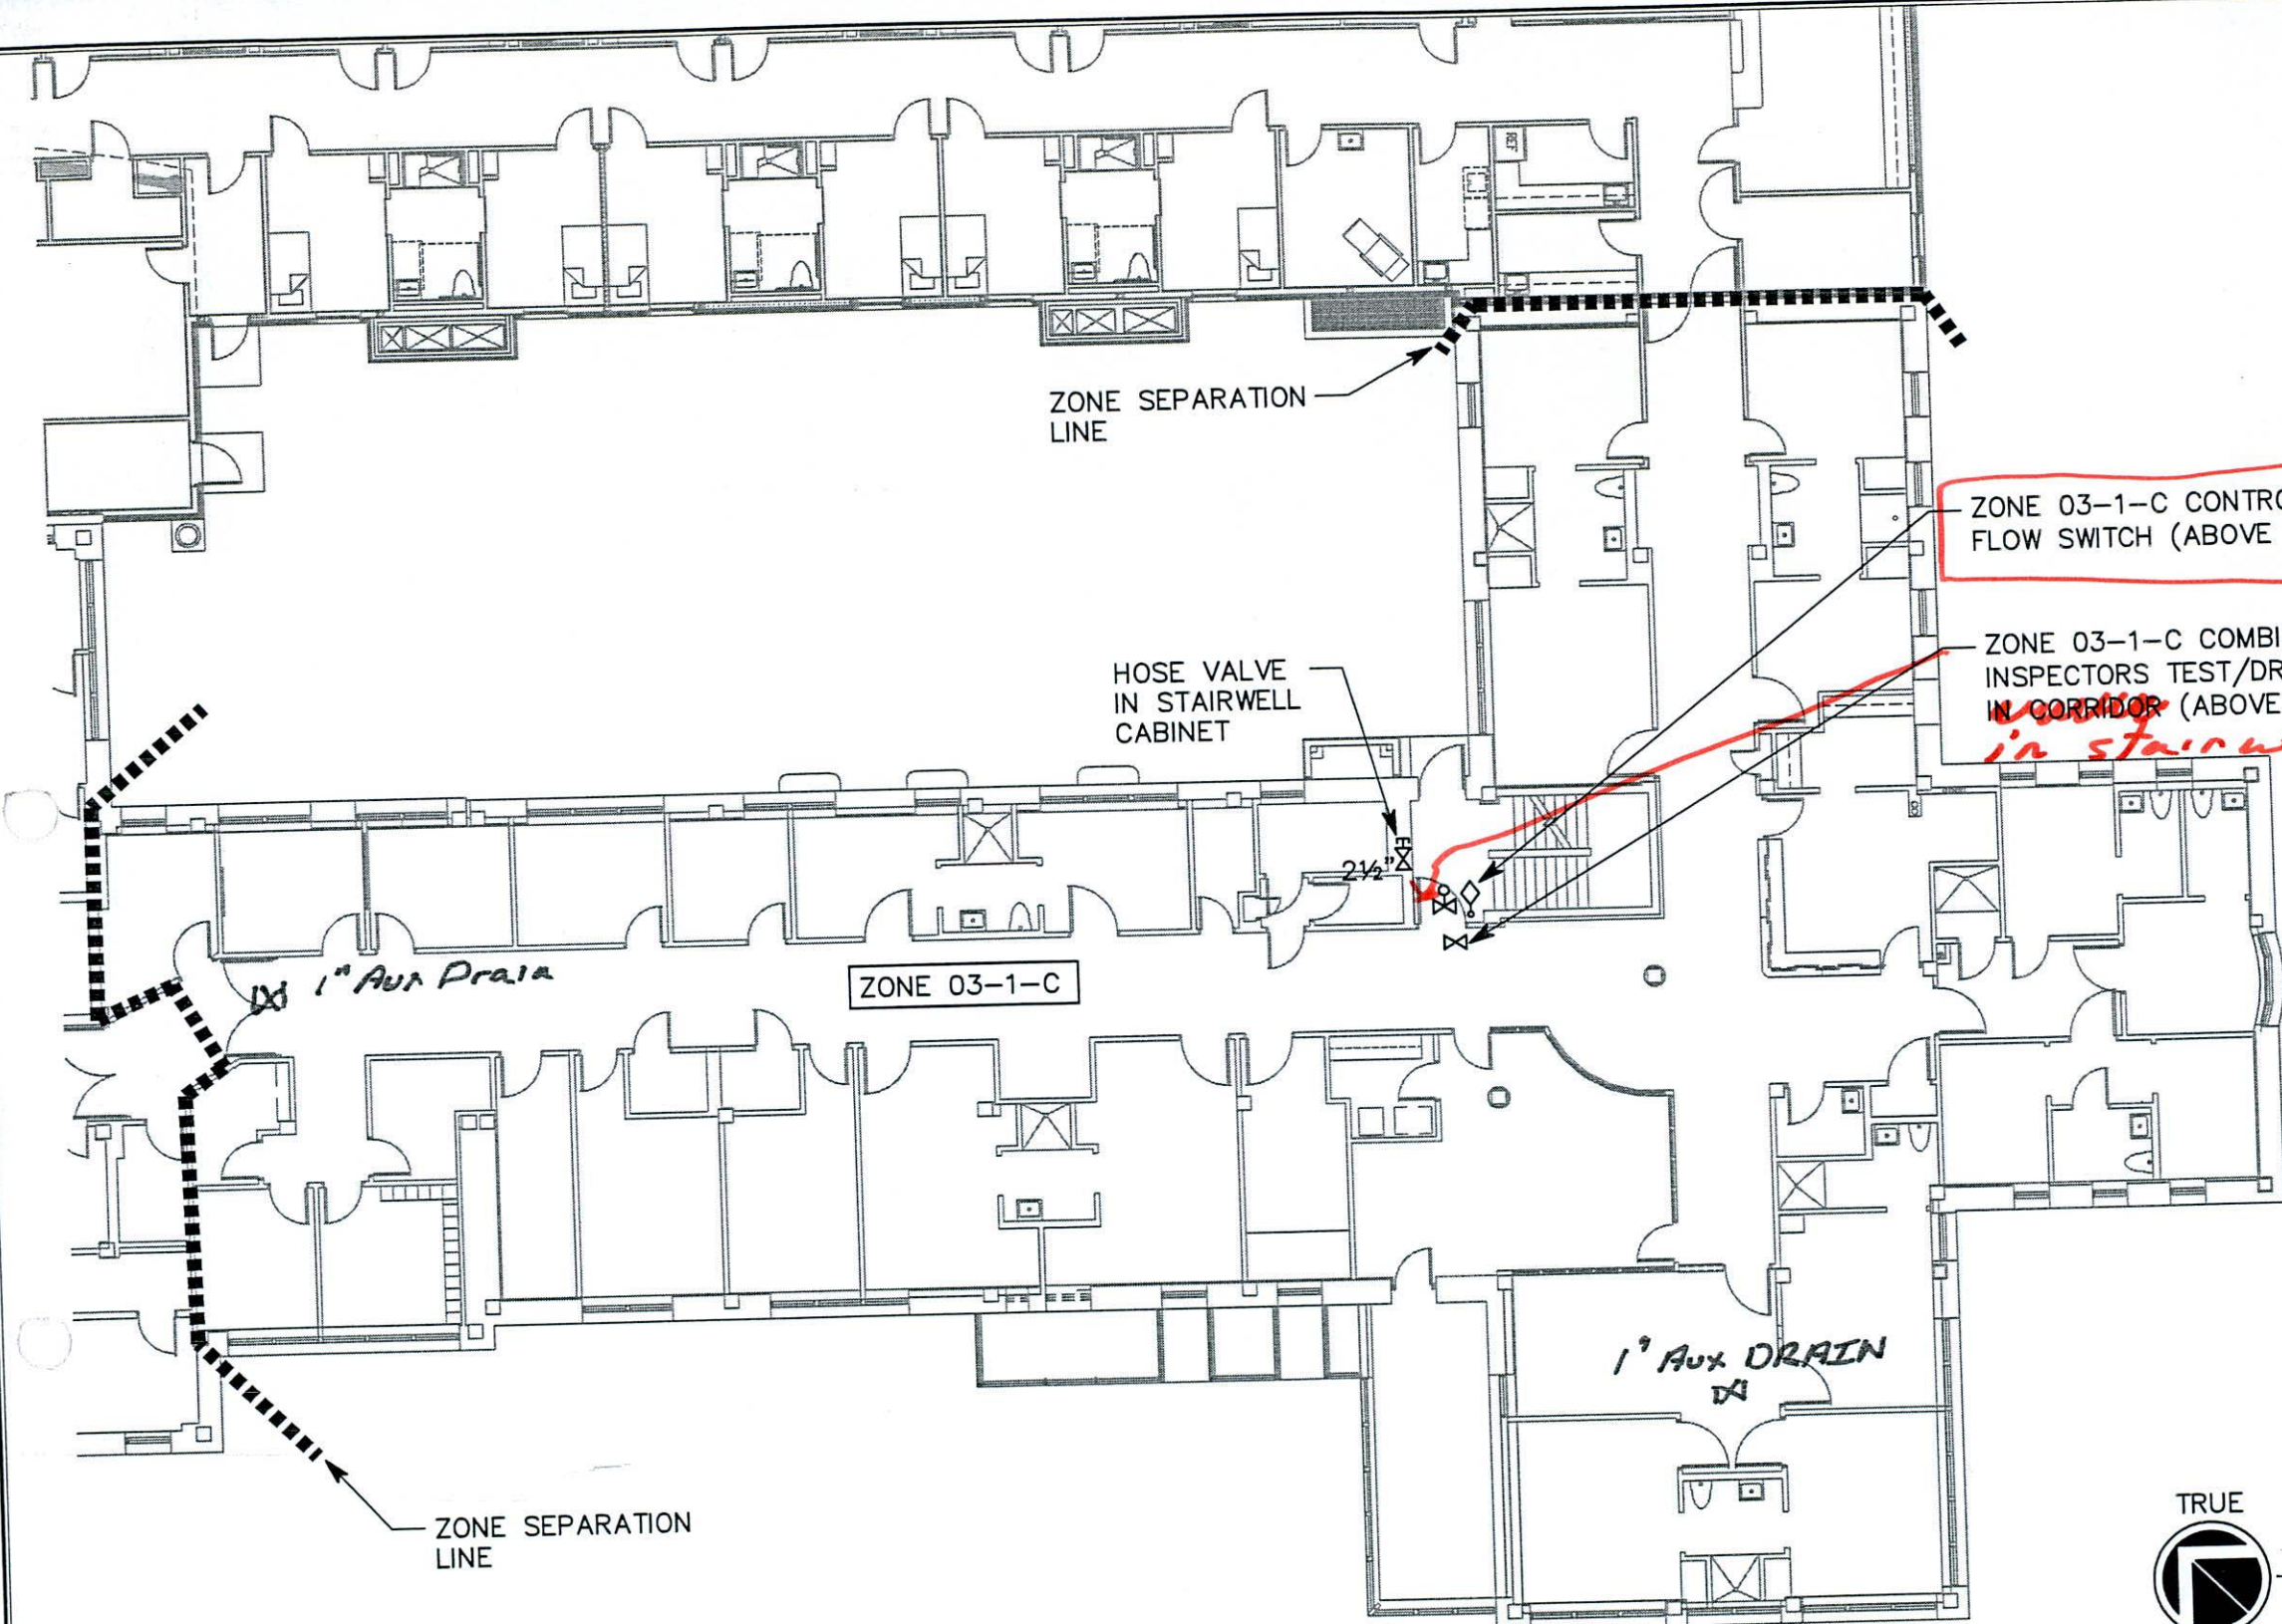


ZONE 03-1-C CONTROL VALVE AND
FLOW SWITCH (ABOVE CEILING)

ZONE 03-1-C COMBINATION
INSPECTORS TEST/DRAIN
IN CORRIDOR (ABOVE CEILING)

in stairway 5-20-15

LEGEND	
	CONTROL VALVE
	FLOW SWITCH
	IT AND/OR DRAIN VALVE
	HOSE VALVE
	IT AND/OR DRAIN OUTLET
	POST INDICATOR VALVE

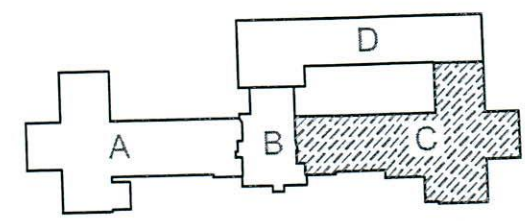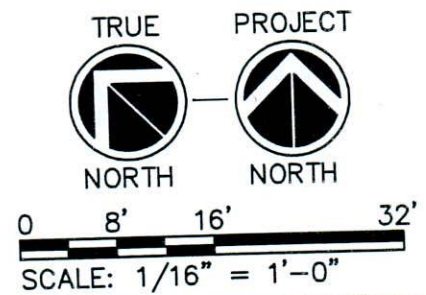

KEY PLAN

Revisions	Date

Consultant

**SPECTRUM
ENGINEERS**
324 South State Street, Suite 400
Salt Lake City, Utah 84111
801.328.5151
800.678.7077
FAX 801.328.5155
www.spectrum-engineers.com

Project Title CAMPUS WIDE FIRE SPRINKLING TEST STATION MODIFICATION AND DEFICIENCIES STUDY	
Consultant Project No. 20100195	
Drawn BXW	Checked JDD

Drawing Title BUILDING 3 LEVEL 1 ZONE C	Date 08.03.2010	DRAWING No. F.03.2C Dep. of XX
	Project No. 660-10-110	
	Building No. 3	