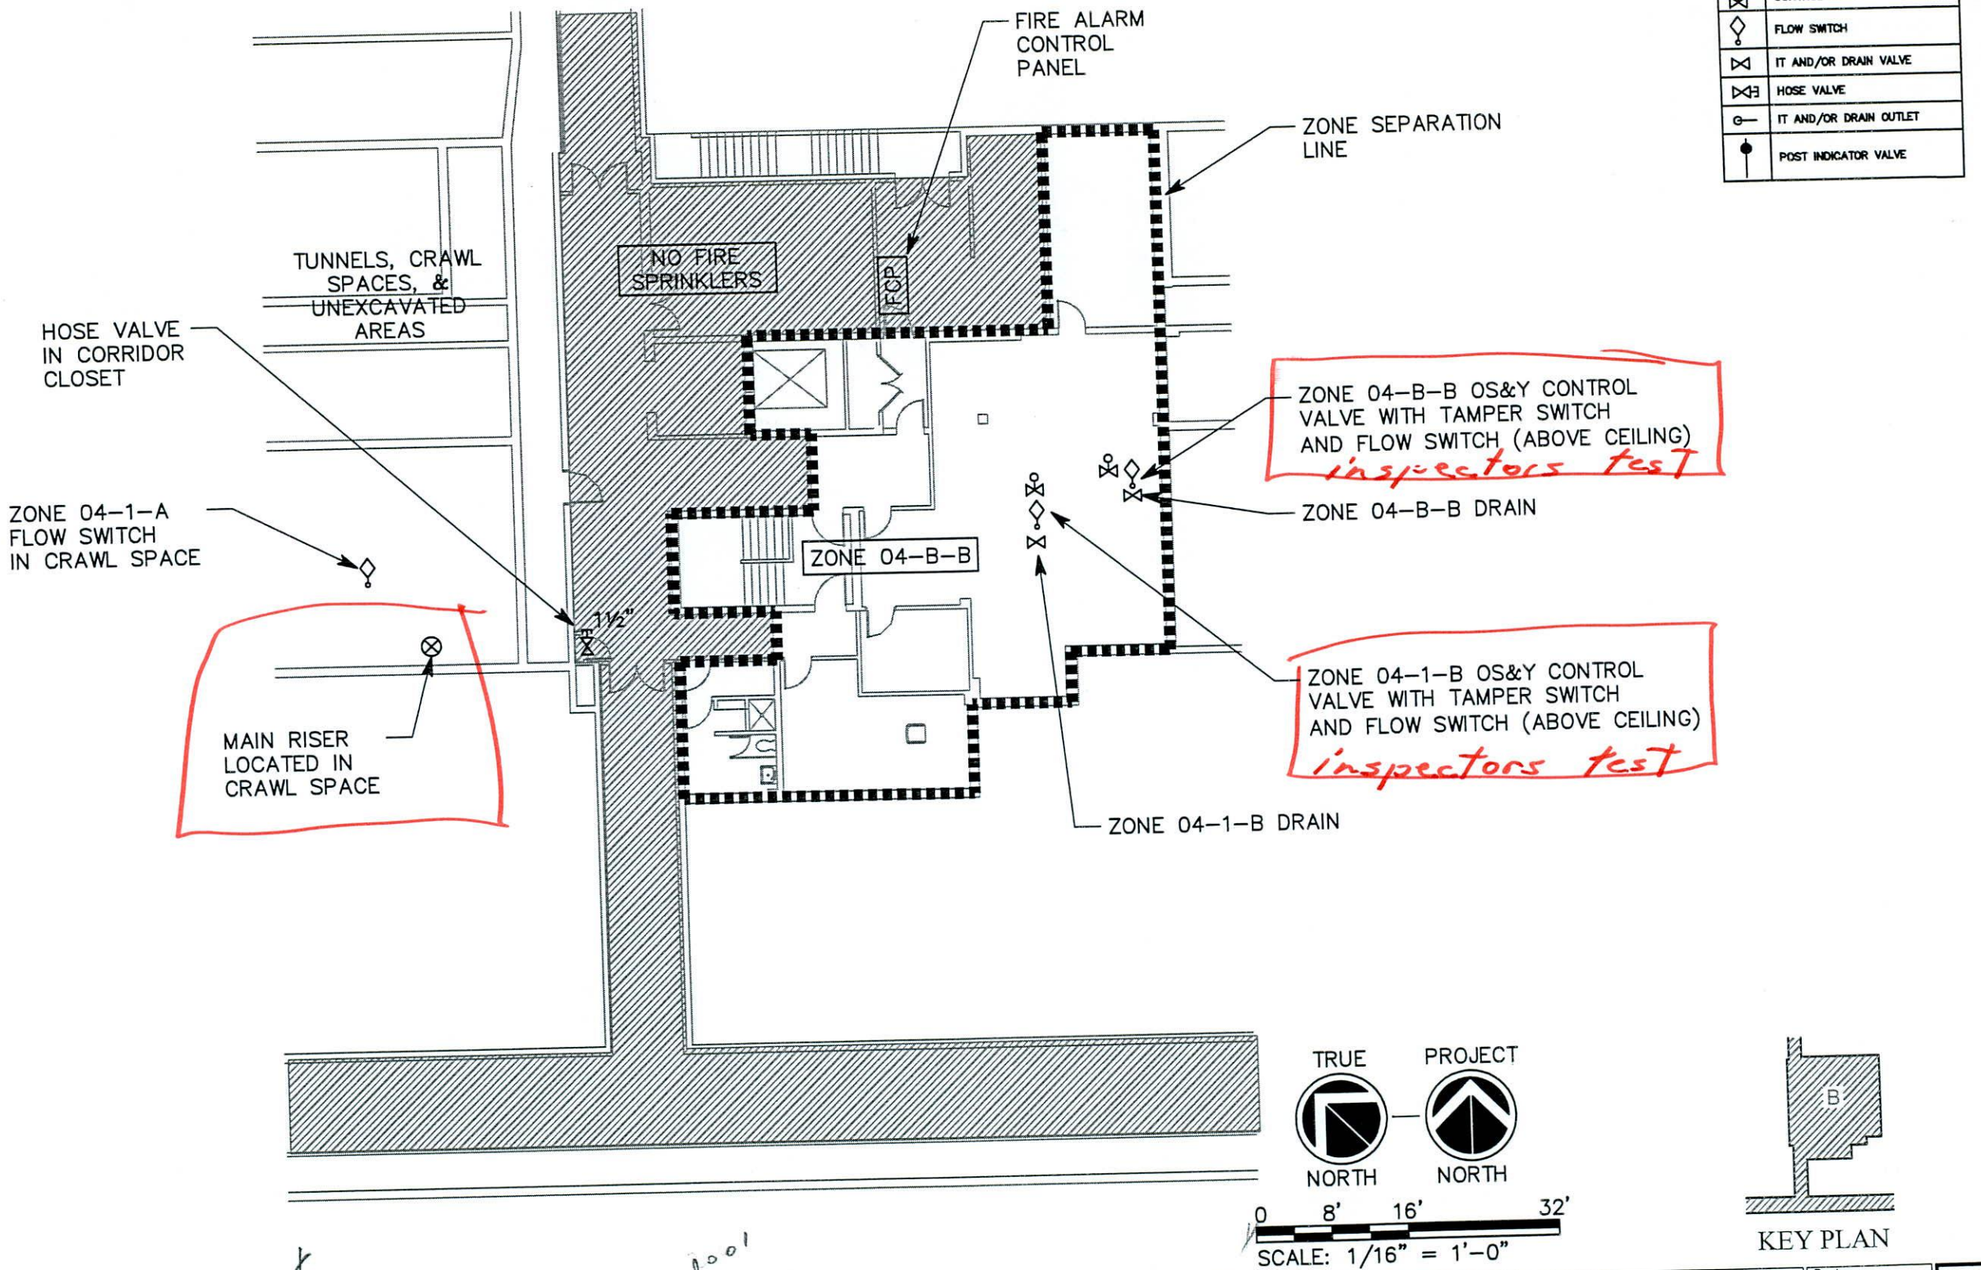

LEGEND	
	CONTROL VALVE
	FLOW SWITCH
	IT AND/OR DRAIN VALVE
	HOSE VALVE
G—	IT AND/OR DRAIN OUTLET
	POST INDICATOR VALVE

AS-BUILT RECORD DRAWINGS

Department of VAMC

Revisions	Date
	Date

Consultant
SPECTRUM ENGINEERS
324 South State Street, Suite 400
Salt Lake City, Utah 84111
801.328.5151
800.678.7077
FAX 801.328.5155
www.spectrum-engineers.com

Project Title	CAMPUS WIDE FIRE SPRINKLING TEST STATION MODIFICATION AND DEFICIENCIES STUDY
Consultant Project No.	20100195
Drawn	BXW
Checked	JDD
Drawing Title	BUILDING 4 BASEMENT LEVEL ZONE B
Date	08.03.2010
Project No.	660-10-110
Building No.	4
DRAWING No.	F.04.1
Dwg. of	XX

File Name: P:\2010\20100195\Drawings\Bldg 4\3Sheet\95F.04.1.dwg Last Plotted: 2010/11/01 @ 12:23 PM By: jdd