ZONE 07–B WATER FLOW SWITCH (AT CEILING)

ZONE 06–D CONTROL VALVE WITH TAMPER SWITCH AND FLOW SWITCH

ZONE 07–B

ZONE SEPARATION LINE

ZONE 07–B INSPECTORS TEST

ZONE 06–D
(FED FROM BLDG 7)

ZONE 06–D DRAIN (AT CEILING, USED FOR INSPECTORS TEST)

ZONE SEPARATION LINE

TRUE NORTH

PROJECT NORTH

0 8' 16' 32'

SCALE: 1/16" = 1'–0"

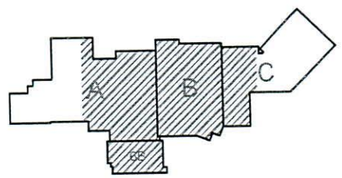

KEY PLAN

AS-BUILT RECORD DRAWINGS

Revisions Date Date		Consultant SPECTRUM ENGINEERS 324 South State Street, Suite 400 Salt Lake City, Utah 84111 801.328.5151 800.678.7077 FAX 801.328.5155 www.spectrum-engineers.com	Project Title CAMPUS WIDE FIRE SPRINKLING TEST STATION MODIFICATION AND DEFICIENCIES STUDY Consultant Project No. 20100195 Drawn BXW Checked JDD	Drawing Title BUILDING 7 FIRST LEVEL ZONE B	Date 08.03.2010 Project No. 660-10-110 Building No. 7	DRAWING No. F.07.1B Dwg. of XX VAMC Department of Veterans Affairs

File Name: P:\2010\20100195\Drawings\Bldg 7\3Sheet\95F.07.1b.dwg Last Plotted: 2010/11/01 @ 12:22 PM By: jdd