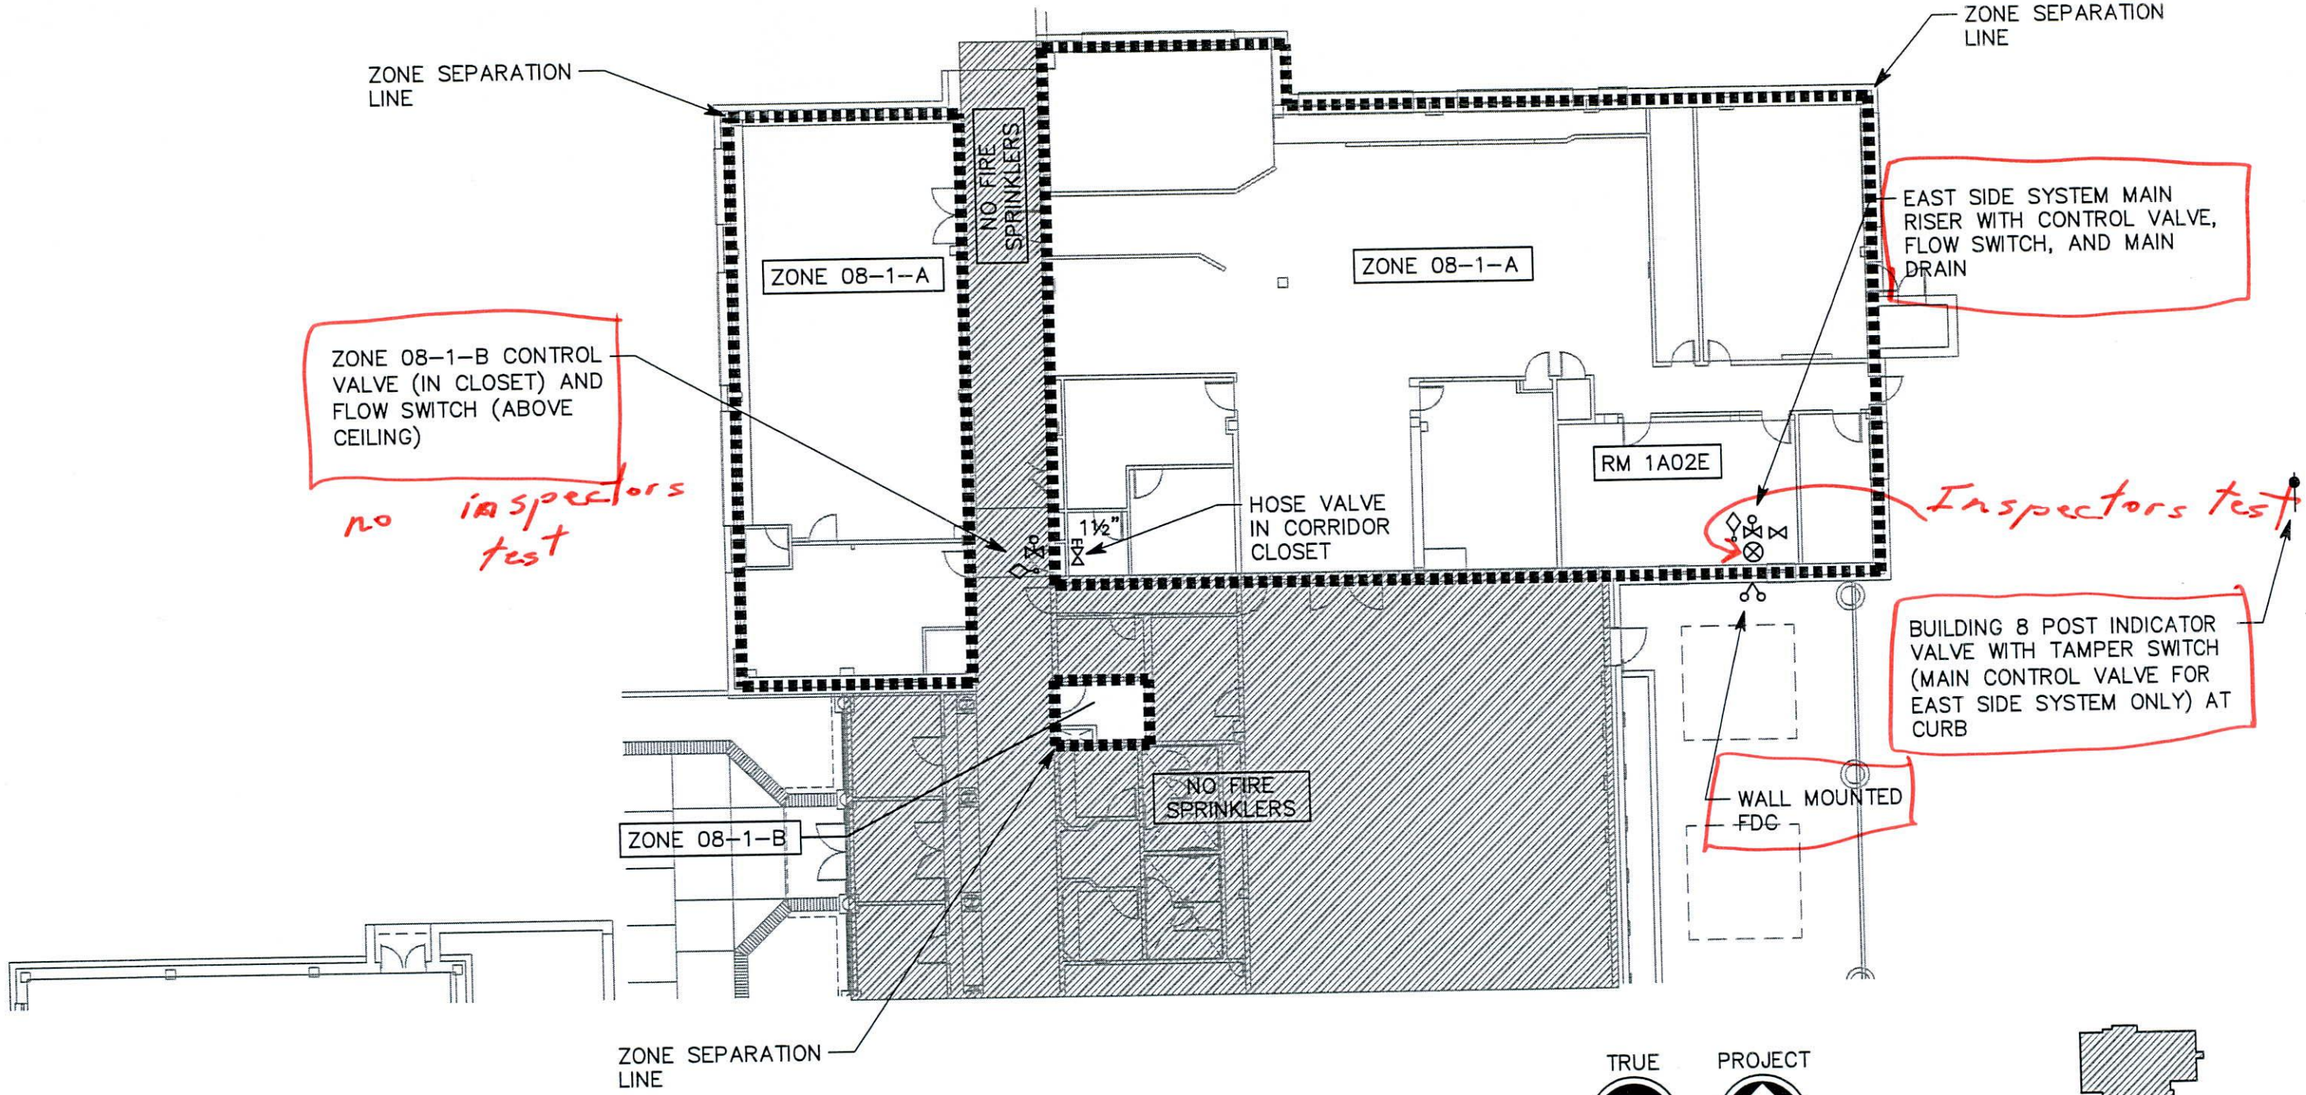

AS-BUILT RECORD DRAWINGS

Department of VAMC

Revisions	Date
	Date

Consultant: SPECTRUM ENGINEERS
324 South State Street, Suite 400
Salt Lake City, Utah 84111
801.328.5151
800.678.7077
FAX 801.328.5155
www.spectrum-engineers.com

Project Title: CAMPUS WIDE FIRE SPRINKLING TEST STATION MODIFICATION AND DEFICIENCIES STUDY
Consultant Project No. 20100195
Drawn BXW | Checked JDD

Drawing Title: BUILDING 8 FIRST LEVEL - NORTH

Date 08.03.2010
Project No. 660-10-110
Building No. 8

DRAWING No. F.08.2A
Dwg. of XX

File Name: P:\2010\20100195\1Drawings\Bldg 8\3Sheet\95F.08.2a.dwg Last Plotted: 2010/11/01 @ 12:21 PM By: jdd