
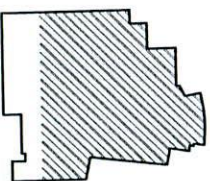


LEGEND	
	CONTROL VALVE
	FLOW SWITCH
	IT AND/OR DRAIN VALVE
	HOSE VALVE
	IT AND/OR DRAIN OUTLET
	POST INDICATOR VALVE

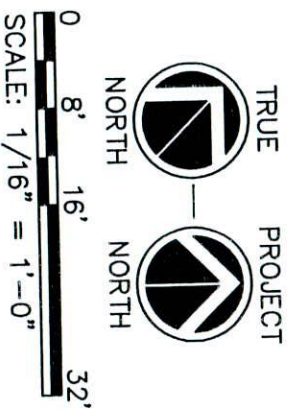

KEY PLAN

Revisions

Date

Date

Consultant



324 South State Street, Suite 400  
Salt Lake City, Utah 84111  
801.328.5151  
800.678.7077  
FAX 801.328.5155  
www.spectrum-engineers.com

Project Title

CAMPUS WIDE FIRE SPRINKLING TEST STATION  
MODIFICATION AND DEFICIENCIES STUDY

Consultant Project No. 20100195

Drawn BXW

Checked JDD

Drawing Title

BUILDING 9  
FIRST LEVEL  
ZONE A &  
ZONE B - NORTH

Date

08.03.2010

Project No.

660-10-110

Building No.

9

FORMING No.  
F.09.1A  
or XX



Department of

AS-BUILT RECORD DRAWINGS