FINISH SCHEDULE LEGEND

MATERIAL CODE	MANUFACTURER	PATTERN/LINE	COLOR	COMMENT
CPT - CARPET TILES				
CPT-01	TANDUS	RIVET 04219	HEEL-TOE 54209	
CUBICLE CURTAINS				
CC-01	CORAL - SNAP OVERLAY SYSTEM	MERIDIAN	TURQUOISE	
P- PAINT				
P-01	SHERWIN WILLIAMS		MACADAMIA SW6142	FINISH : MATTE
P-02	SHERWIN WILLIAMS		COMPOSED SW6472	FINISH : MATTE
P-03	SHERWIN WILLIAMS		HAZEL SW6471	FINISH : MATTE
P-04	SHERWIN WILLIAMS		SHOJI WHITE SW7042	FINISH : MATTE
PLAM- PLASTIC LAMINATE				
PLAM- 01	FORMICA		NATURAL TEAK 8849-58	MATTE FINISH
RB - RESILIENT BASE				
RB-01	JOHNSONITE	4" RUBBER TRADITIONAL	TOAST 283	
RB-02	JOHNSONITE	MILLWORK DIPLOMAT MW-XX-A	TOAST 283	
RES- RESINOUS FLOORING				
RES-O1	SIKA COMFORTFLOR		RAFFIA BEIGE SOLID	
RES-O1C	SIKA COMFORTFLOR		RAFFIA BEIGE CHIPS	10% BROADCAST CHIPS
RES-02	SIKA DECOFLAKE		CAPIZ	WITH 510 TOPCOAT
RES-03	SIKA DECOFLAKE		CUSTOM CHIP	WITH 510 TOPCOAT
RES-04	SIKA STERISEPT WALL SYSTEM		RAFFIA BEIGE CHIPS	
SS- SOLID SURFACE				
SS-01	CORIAN		SAVANNAH	
SV-SHEET VINYL				
SV-01	MANNINGTON	BLOCKPRINT	PARCHMENT VIV223	WELDING ROD #842336
VCT- VINYL COMPOSITION TILE				
VCT-01	MANNINGTON	TOUCHSTONE	ALMONDINE 9133	
VCT-02	MANNINGTON	TOUCHSTONE	SILVER PINE 9125	
WP- WALL PROTECTION				
WP-01	ACROVYN	CORNER GUARD SM-20MN	102 DESERT SAND	SUEDE TEXTURE

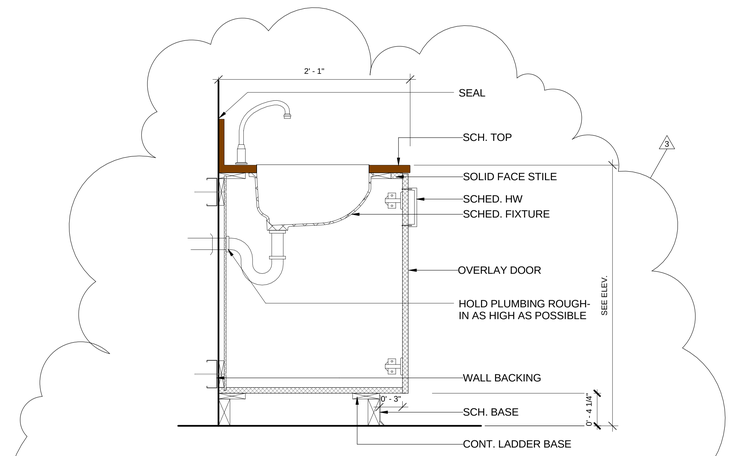

1 **SECTION AT SINK BASE CABINET**
1 1/2" = 1'-0"

ROOM FINISH SCHEDULE

ROOM NO.	ROOM NAME	ROOM FINISH SET	BASE FINISH	FLOOR FINISH	WALL FINISH	ACCENT WALLS	CEILING	HORIZONTAL MILLWORK	VERTICAL MILLWORK	MISC	WALL PROTECTION	CODED NOTES
1F-103	STAIR	(none)	RB-01	VCT-01	P-01	-	-	-	-			
2B-181	PACU	(none)	RES-01	RES-01	P-01	-	AT-01	-	-			
2B-182	RESTROOM	(none)	RES-01	RES-01	P-01	-	AT-01	-	-			
2B-183	CLEAN EQUIP.	(none)	-	-	-	-	-	-	-			
2B-184	MEDS	(none)	RB-01	SV-01	P-04	-	AT-01	-	-			
2B-185	SOILED UTILITY	(none)	-	-	-	-	-	-	-			
2B-186	NURISHMENT	(none)	RES-03	RES-03	P-01	-	AT-01	-	-			
2B-187	ISOLATION ROOM	(none)	RES-03	RES-03	P-01	P-03	AT-01	-	-			
2B-188	VESTIBULE	(none)	RES-03	RES-03	P-01	-	AT-01	-	-			
2B-189	JANITOR	(none)	RB-01	VCT-01	P-04	-	AT-01	SS-01	PLAM-01			
2B-190	FAMILY CONSULTING #2	(none)	RB-02	CPT-01	P-01	P-02	AT-01	SS-01	PLAM-01			
2B-191	FAMILY CONSULTING #1	(none)	RB-02	CPT-01	P-01	P-02	AT-01	SS-01	PLAM-01			
2B-192	HEAD NURSE	(none)	RB-02	CPT-01	P-01	P-02	AT-01	-	-			
2B-193	LINEN CLOSET	(none)	RES-01	RES-01	P-01	-	AT-01	-	-			
2C-100	SURGICAL SRVCS ADMINSTRATION	(none)	-	-	-	-	-	-				
2C-101	COPIER/ FILING	(none)	-	-	-	-	-	-				
2C-102	CHIEF SURGICAL SERVICES	(none)	-	-	-	-	-	-				
2C-103	ADMIN. OFFICER	(none)	-	-	-	-	-	-				
2C-104	STAFF SURGEON	(none)	-	-	-	-	-	-				
2C-105	SIGNAL	(none)	-	-	-	-	-	-				
2C-106	TELEPHONE	(none)	-	-	-	-	-	-				
2C-107	ELECTRICAL	(none)	-	-	-	-	-	-				
2C-108	SURGERY SVC. ADMIN.	(none)	-	-	-	-	-	-				
2C-110	SURGERY SVC. ADMIN.	(none)	-	-	-	-	-	-	-			
2C-115	SOILED UTILITY	(none)	-	-	-	-	-	-	-			
2C-116	EQUIPMENT STORAGE	(none)	-	-	-	-	-	-	-			
2C-139	CLEAN UTILITY	(none)	-	-	-	-	-	-	-			
2C-143	SICU BREAKROOM	(none)	RB-01	SV-01	P-01	P-02	AT-01	SS-01	PLAM-01			
2C-143A	FAMILY WAITING	(none)	RB-02	CPT-01	P-01	P-02	AT-01	-	-			
2C-144	UNISEX	(none)	RES-03	RES-03	P-01	-	EXISTING	-	-			
2C-145	UNISEX	(none)	RES-02	RES-02	P-01	-	-	-	-			
2C-146	SICU WAITING	(none)	-	-	-	-	-	-	-			
2C-224	CORRIDOR	(none)	-	-	-	-	-	-	-			
2C-225	CORRIDOR	(none)	MATCH EXISTING	MATCH EXISTING	MATCH EXISTING	-	EXISTING	-	-			
2F-102	CORRIDOR	(none)	RES-02	RES-02	P-01	P-02	AT-01	-	PLAM-01			
2F-103	STAIR	(none)	RB-01	VCT-01	P-01	-	AT-01	-	-			
2F-201	NEUROSURGERY OPERATING ROOM	(none)	RES-04	RES-01/RES-01C	P-01	P-03	GWB (SC)	-	-			5
2F-202	S.P.O.R. CONTROLS	(none)	RES-02	RES-02	P-04	-	AT-01	-	-			
2F-203	GAS CYLIND. STOR.	(none)	RES-02	RES-02	P-04	-	GWB (SC)	SS-01	PLAM-01			
2F-204	EQUIPMENT STORAGE	(none)	RES-02	RES-02	P-04	-	GWB (SC)	SS-01	PLAM-01			
2F-205	CLEAN STERILE STORAGE	(none)	RES-02	RES-02	P-04	-	GWB (SC)	SS-01	PLAM-01			
2F-206	SPECIAL PURPOSE OPERATING ROOM	(none)	RES-04	RES-01/RES-01C	P-01	P-03	GWB (SC)	-	-			5
2F-207	DATA	(none)	RES-02	RES-02	P-04	-	AT-01	SS-01	PLAM-01			
2F-209	STORAGE	(none)	RES-02	RES-02	P-04	-	AT-01	SS-01	PLAM-01			
2F-210	ELECT.	(none)	RES-02	RES-02	P-04	-	AT-01	SS-01	PLAM-01			
2F-211	CARDIOVASCULAR OPERATING ROOM	(none)	RES-04	RES-01/RES-01C	P-01	P-03	GWB (SC)	-	-			5
2F-212	DORNOCH STOR.	(none)	RES-02	RES-02	P-04	-	GWB (SC	SS-01	PLAM-01			
2F-213	GENERAL OPERATING ROOM	(none)	RES-04	RES-01/RES-01C	P-01	P-03	GWB (SC)	-	-			5
2F-214	ATRIUM	(none)	RB-01	SV-02	P-01	-	-	-	-			
2F-215	PATIENT HOLDING	(none)	RES-02	RES-02	P-01	P-02	AT-01	-	-			
2F-216	UNISEX	(none)	RES-02	RES-02	P-04	-	AT-01	-	-			
2F-219	OR BREAK ROOM	(none)	RB-01	SV-01	P-01	P-02	AT-01	SS-01	PLAM-01			
2F-220	SOILED CART HOLDING	(none)	RES-02	RES-02	P-04	-	AT-01	SS-01	PLAM-01			
2F-221A	MEN'S RESTROOM	(none)	RES-03	RES-03	P-01	-	GWB	SS-01	PLAM-01			
2F-221B	MEN'S LOCKER	(none)	RB-01	SV-01	P-01	P-02	AT-01	SS-01	PLAM-01			
2F-222A	WOMEN'S RESTROOM	(none)	RES-02	RES-02	P-01	P-02	GWB	SS-01	PLAM-01			
2F-222B	WOMEN'S LOCKER	(none)	RB-01	SV-01	P-01	P-03	AT-01	-				
2F-223	CONTROLS	(none)	RES-02	RES-02	P-01	-	AT-01	SS-01	PLAM-01			
2F-224	ANESTHESIA ROOM	(none)	RES-02	RES-02	P-04	-	AT-01	SS-01	PLAM-01			
2F-225	MEDS ROOM	(none)	RES-02	RES-02	P-04	-	AT-01	-	-			
2F-227	ORTHOPEDIC OPERATING ROOM #1	(none)	RES-04	RES-01/RES-01C	P-01	P-03	GWB (SC)	-	-			5
2F-228	CLEAN CORE	(none)	RES-02, RES-03	RES-02, RES-03	P-01	P-02	AT-02, GWB	-	-			
2F-229	ORTHOPEDIC OPERATING ROOM #2	(none)	RES-04	RES-01/RES-01C	P-01	P-03	GWB (SC)	-	-			5
2F-230	STORAGE	(none)	RES-01	RES-01	P-07	-	AT-01	SS-01	PLAM-01			
2F-231	CORRIDOR	(none)	RES-01	RES-01	P-01	P-02	AT-01	-	-			
2F-232	HAC	(none)	RES-02	RES-02	P-04	-	-	-	-			
2F-233	ORTHO STORAGE	(none)	RES-01	RES-01	P-04	-	AT-01	-	-			
GF-103	STAIR	(none)	RB-01	VCT-01	P-01	-	-	-	-			
GF-104	ELEVATOR	(none)	-	-	-	-	-	-	-			

ABBREVIATIONS

A	
AT	ACOUSTICAL CEILING TILE
C	
CC	PATIENT ROOM CUBICLE CURTAIN
CG	CORNER GUARD
CPT	CARPET TILE
CR	CRASH RAIL
CT	CERAMIC TILE / PORCELAIN TILE
CTB	CERAMIC TILE / PORCELAIN TILE BASE
D	
DP	DECORATIVE RESIN / WOOD PANEL
E	
EXPS	EXPOSED STRUCTURE
EXST	EXISTING
G	
GLAZ	GLAZING
GT	GROUT
GWB	GYPSUM WALLBOARD
H	
HNDRL	HANDRAIL
P	
P	PAINT
PLAM	PLASTIC LAMINATE
PWC	WALL PROTECTION SHEETING
R	
RB	RESILIANT BASE
RES	RESINOUS FLOORING / BASE
RFT	RUBBER FLOOR TILE
S	
SC	SHOWER CURTAIN
SCC	SEALED CONCRETE
SS	SOLID SURFACE
SV	SHEET VINYL
W	
WDGRL	WOOD GRILLE
WDPNL	WOOD BOARD PANELING

FINISH SCHEDULE NOTES

1 PROVIDE RUBBER BASE AT LANDINGS ONLY.
2 PROVIDE CEMENT BACKER BOARD BEHIND ALL CERAMIC TILE ON ALL WALLS TO A HEIGHT OF 3'-4" A.F.F.
3 PROVIDE GPYSUM BOARD ON MECHANICAL SHAFT SIDE OF ROOM.
4 PROVIDE WATER RESISTANT GYPSUM BOARD.
5 RESIN TO CONTINUE UP WALL 48" AFF.

CONSTRUCTION DOCUMENTS
FULLY SPRINKLERED

Revisions:		Date
3	RFI #11 and #41	2015.08.27

CONSULTANTS:

ARCHITECTURAL
BES INCORPORATED
BES, INC
2712 BULL ST,
BEAUFORT, SC 29902
843.522.2094

THESE DRAWINGS ARE NOT TO BE USED FOR CONSTRUCTION, BIDDING, RECORDATION, CONVEYANCE, SALES, OR AS THE BASIS FOR THE ISSUANCE OF A PERMIT

ARCHITECT/ENGINEERS:

BES DESIGN/BUILD
BES DESIGN/BUILD, LLC
766 Middle St, Fairhope, AL 36532
Phone: 251.990.5778
Fax: 251.990.3716

Drawing Title: **ROOM FINISH SCHEDULE**
Approved: Project Director
Project Title: **CONSTRUCT NEW OR SUITES**
Location: **JOHN L. McCLELLAN MEMORIAL VETERANS HOSPITAL; LITTLE ROCK, ARKANSAS**
Date: **01/23/15**
Drawn: **AB**
Checked: **AC**
Project Number: **598-12-207**
Building Number: **1**
Drawing Number: **IN601**
Dwg. 66 of 130

CENTRAL ARKANSAS VETERANS AFFAIRS HEALTHCARE SYSTEM
Department of Veterans Affairs

VA FORM 08-6231
8/27/2015 8:51:45 AM

three inches = one foot
one and one half inches = one foot
one inch = one foot
three quarters inch = one foot
one half inch = one foot
three eighths inch = one foot
one quarter inch = one foot
one eighth inch = one foot