
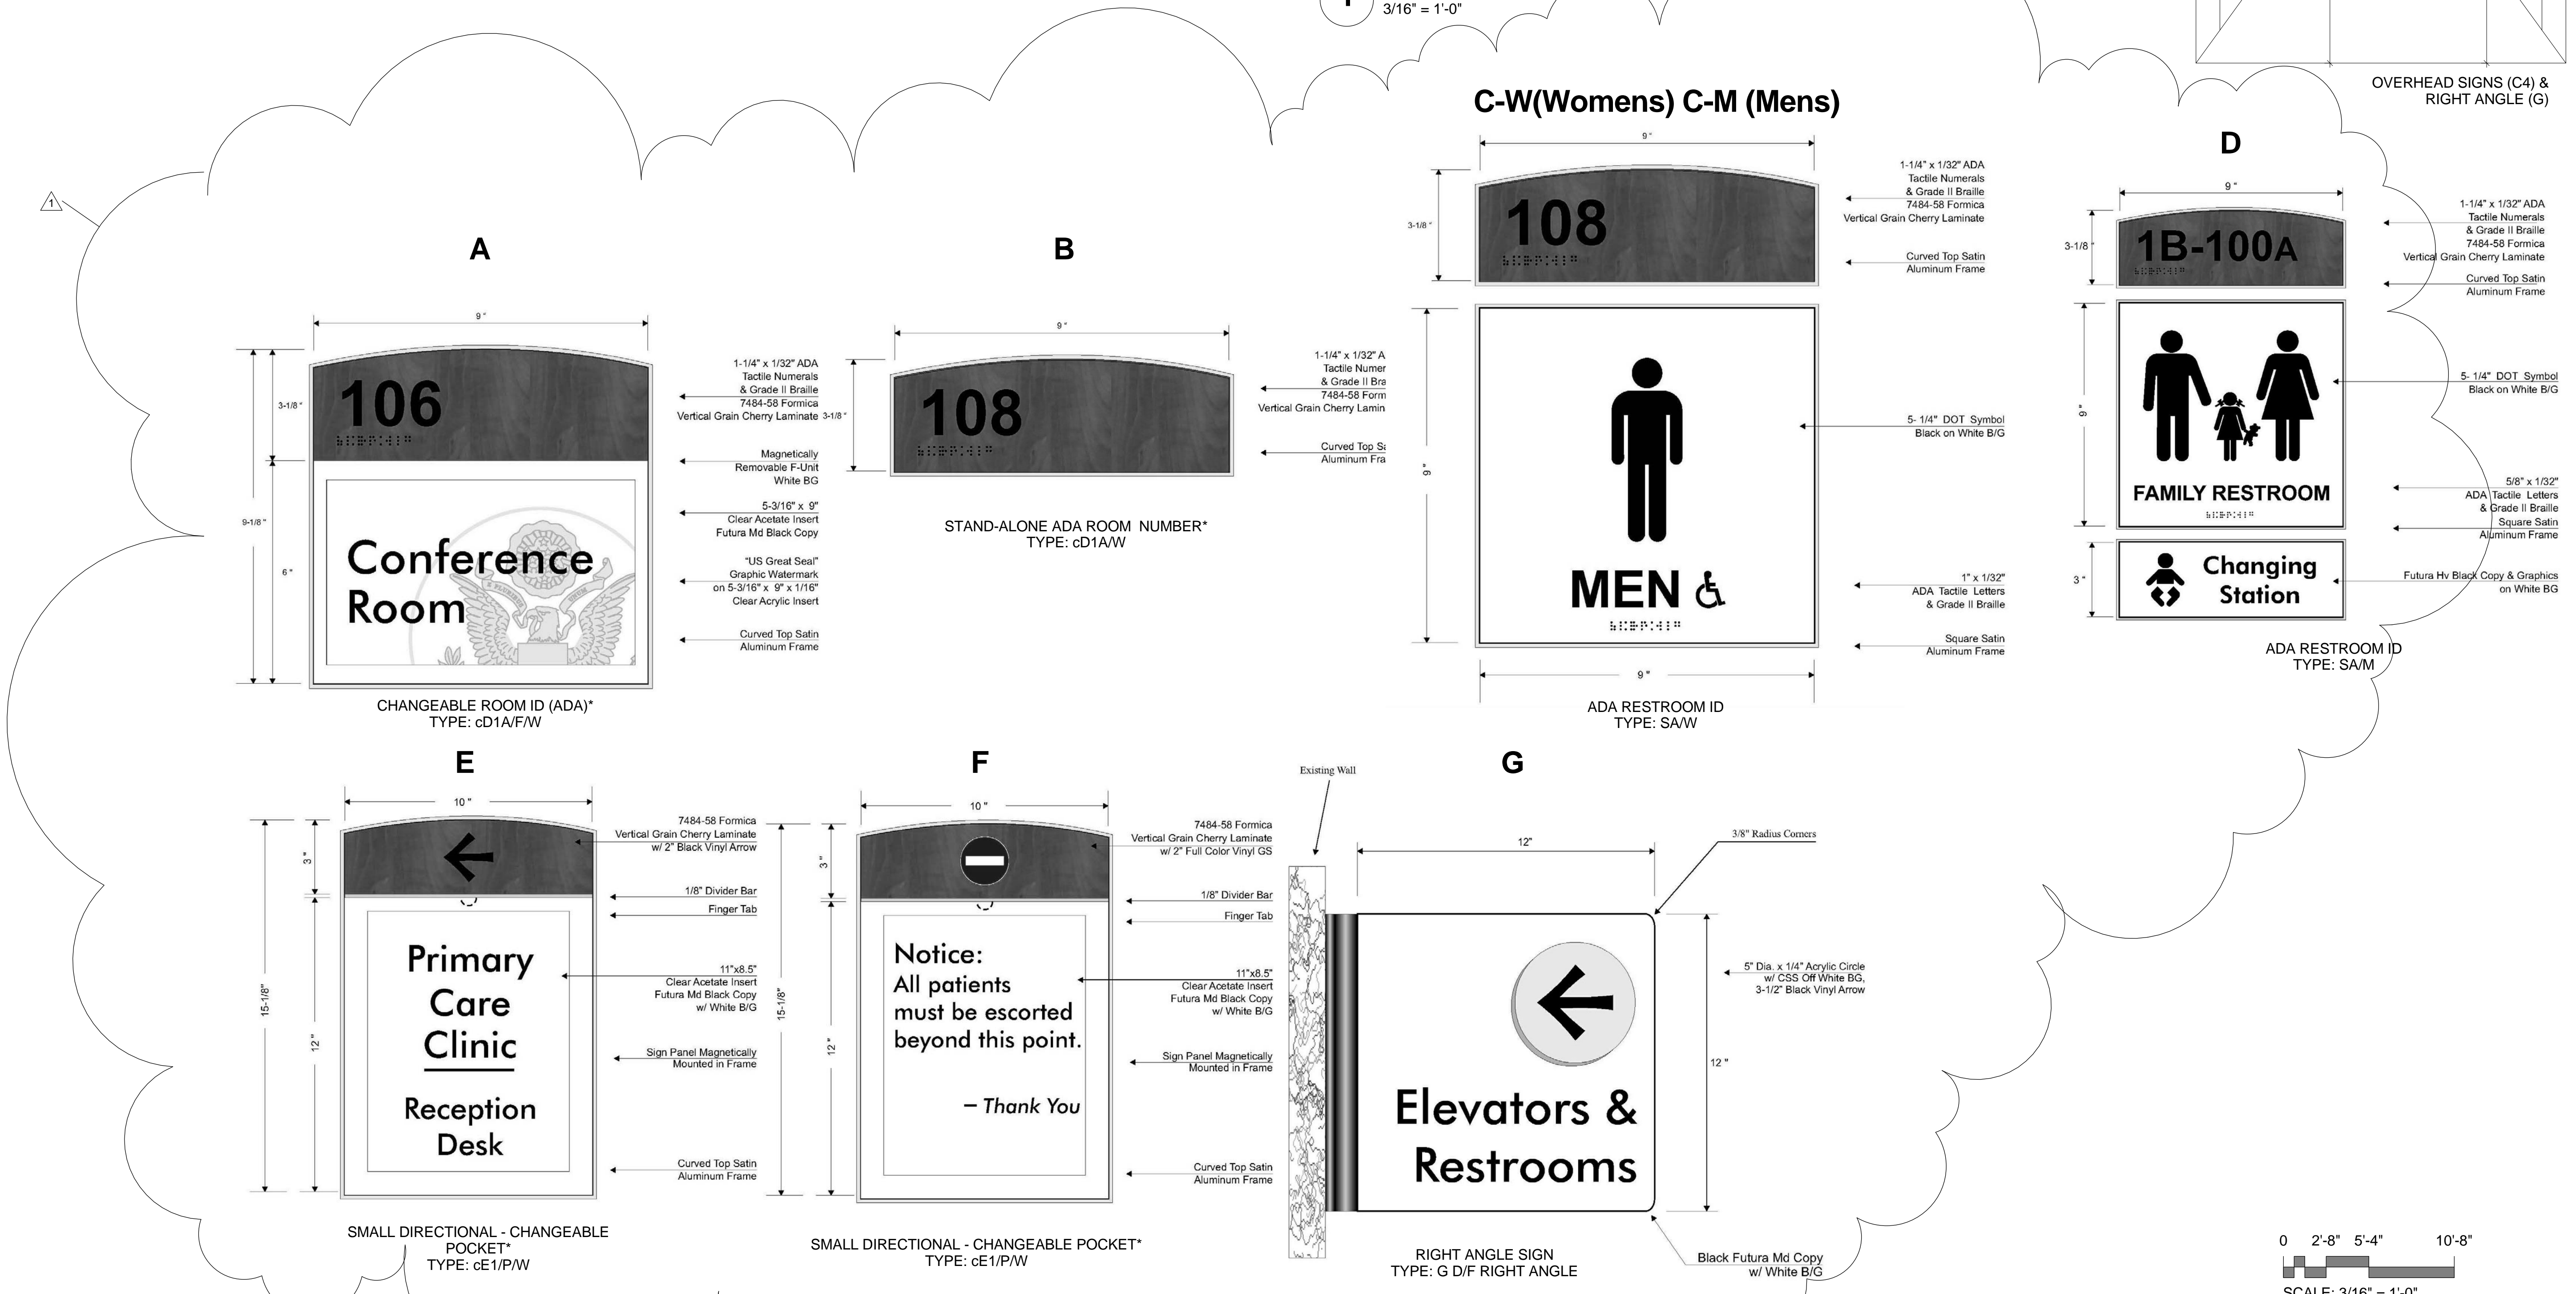



A
B
C
D
E
F

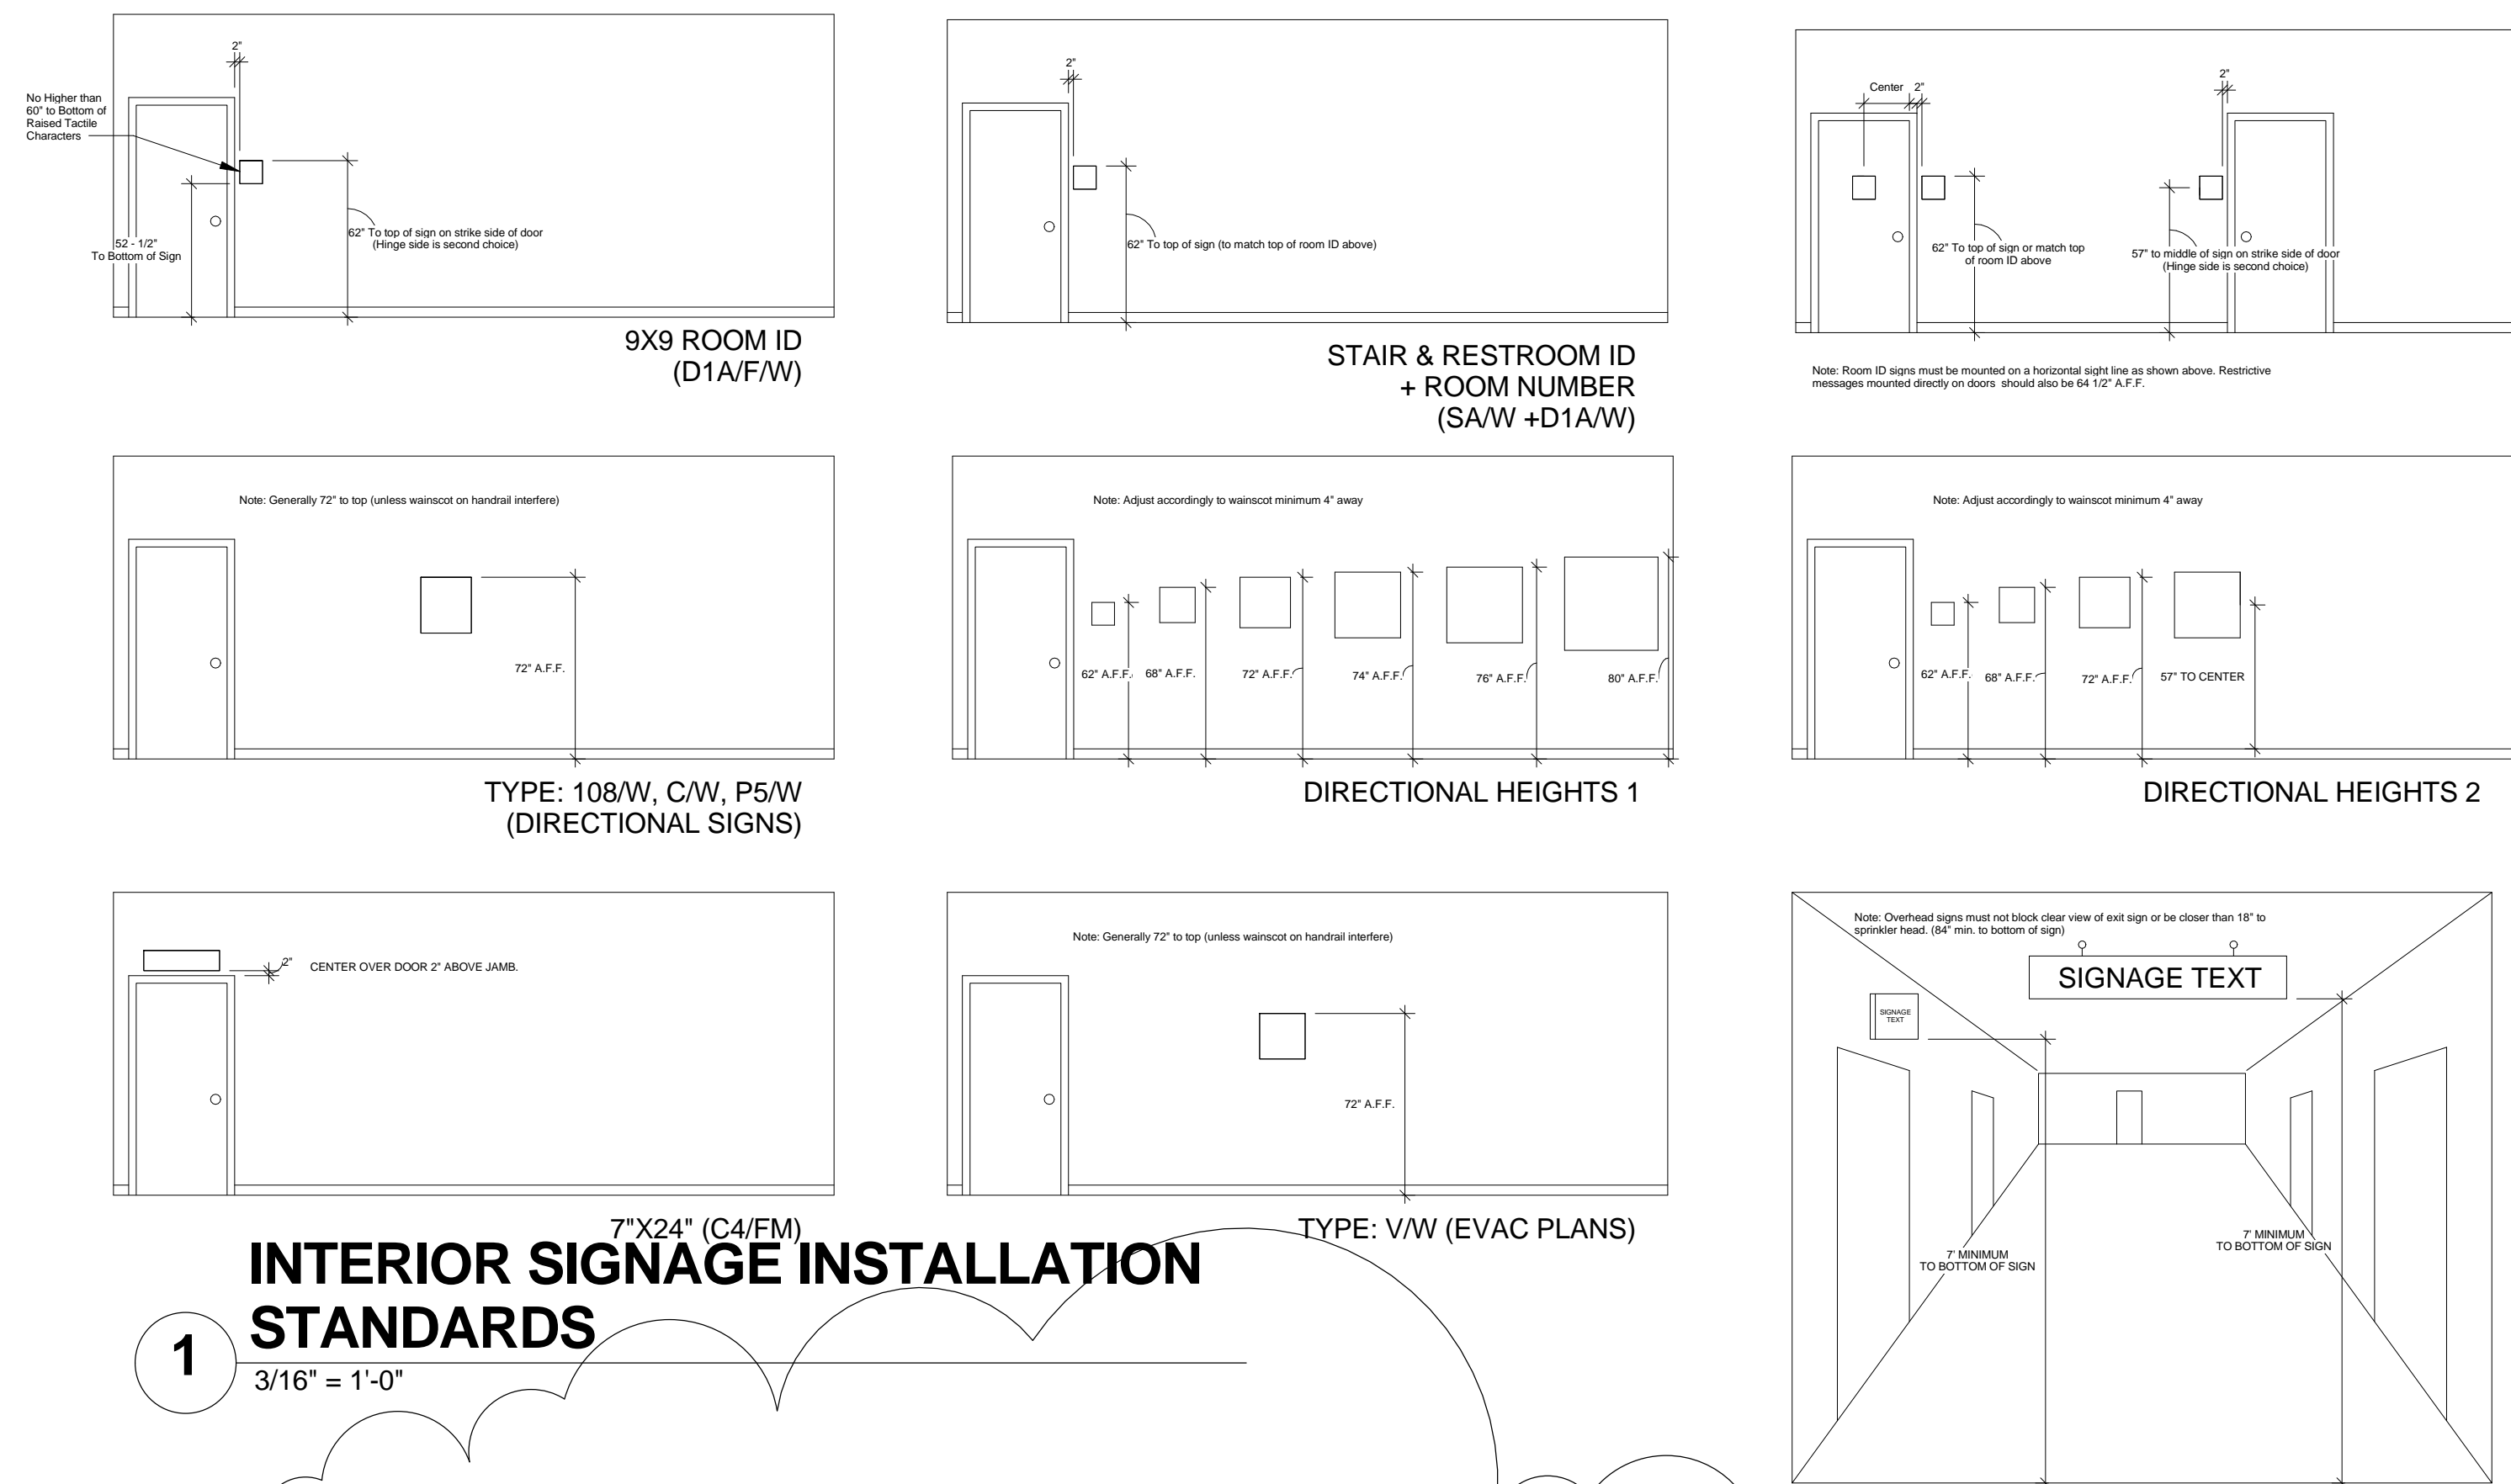

2 INTERIOR SIGN TYPE LEGEND
1/8" = 1'-0"

CONSULTANTS:		ARCHITECT/ENGINEERS:		Drawing Title SIGNAGE DETAILS	Project Title NLR EXPANSION OUTPATIENT AND SUPPORT SPACE UNIT	Project Number 598-13-102	OFFICE OF CONSTRUCTION AND FACILITIES MANAGEMENT Department of Veterans Affairs	
1 ADDENDUM #1	2015.08.31			Approved: Project Director	Location EJT HEALTHCARE CENTER N. LITTLE ROCK, AR 72114	Building Number MULTIPLE		
Revisions:	Date				Date 2015.02.11	Drawn MS	Checked RW	Dwg. 10 of 214