

LUMINAIRE SCHEDULE									
TAG	DESCRIPTION	MANUFACTURER	CATALOG NUMBER	LAMP DATA			INPUT WATTS	VOLTS	KEYED NOTES
				TYPE	QTY	WATTS			
S1	LED FLAG POLE IN-GROUND SPOT LIGHTS	HYDREL	M1720 A 18LED WHT53K MVOLT NSP FLC 34B LP	LED	I	19	19	MVOLT	-
S2	LED BOLLARD	LSI	XHYP3 360 LED 30 350 NW UE PLP DT	LED	I	34	34	MVOLT	2
S3	LED LANDSCAPING FIXTURE - TREE ILLUMINATION	ECOSENSE	BUL-S 40 277-1C BK II BUL-S-90S-BK BUL-S-LSD-80	LED	I	II	II	MVOLT	3
S4	LED IN-GROUND SPOT LIGHT	HYDREL	M1720 A 18LED WHT53K MVOLT MFL FLC 34B LP	LED	I	II	II	MVOLT	4
ES1	EXISTING DRIVE SITE LIGHT	UNKNOWN	EXISTING FIXTURE AND POLE SHALL BE SALVAGED AND RE-USED	LED	I	EXIST.	EXIST.	EXIST.	1
ES2	EXISTING LOOP BYPASS SITE LIGHT	UNKNOWN	EXISTING FIXTURE AND POLE SHALL BE SALVAGED AND RE-USED	LED	I	EXIST.	EXIST.	EXIST.	1
ES3	EXISTING PARKING DECK ENTRANCE SITE LIGHT	UNKNOWN	EXISTING FIXTURE AND POLE SHALL BE SALVAGED AND RE-USED	LED	I	EXIST.	EXIST.	EXIST.	1

GENERAL NOTE:
1. THE MANUFACTURER PRODUCTS IDENTIFIED ABOVE MEETS THE SALIENT CHARACTERISTICS OF THIS SPECIFICATION. SUCH INFORMATION IS ONLY PROVIDED TO SHOW AN EXAMPLE OF PRODUCTS WHICH MEET THE SPECIFICATIONS AND DO NOT, IN ANY WAY, LIMIT THE OFFEROR FROM PROVIDING PRODUCTS FROM OTHER MANUFACTURERS WHICH MEET THE SALIENT CHARACTERISTICS AS IDENTIFIED IN THE SPECIFICATION.

KEYED NOTES:
1. REFER TO DETAIL 04/E6-3 FOR NEW POLE BASE DETAIL.
2. REFER TO DETAIL 05/E6-3 FOR LIGHT BOLLARD INSTALLATION DETAIL.
3. COORDINATE LOCATION OF FIXTURE WITH LANDSCAPE CONTRACTOR. FIXTURES ARE INTENDED FOR TREE ILLUMINATION. POSITION FIXTURES, ONE ON EACH SIDE OF TREE, SO TREE AND FIXTURES MAKE A STRAIGHT LINE. ADJUST FIXTURE AIMING AFTER TREE IS PLANTED.
4. FIXTURE SHALL BE POSITIONED ON THE CENTERLINE OF THE CANOPY PILLAR AND PLACED 18" OC FROM EDGE OF PILLAR (ASSUMING FIXTURE DIAMETER IS 12").


DEDUCTIVE ALTERNATES:
A COMPLETE LIST OF DEDUCTIVE ALTERNATES CAN BE FOUND ON SHEETS ED01, ED1, AND ED2. REFER TO THESE SHEETS TO DETERMINE AREAS AFFECTED BY THE ALTERNATES AND FOR A BRIEF DESCRIPTION ON HOW THE ALTERNATE WILL AFFECT THE ELECTRICAL SCOPE OF WORK.

PHASING:
REFER TO SHEET G02 FOR PROJECT PHASING. CONTRACTOR IS RESPONSIBLE FOR PROVIDING ELECTRICAL UTILITIES (POWER, LIGHTING, TECHNOLOGY) TO ALL TEMPORARY LOCATIONS AS SHOWN ON THE PHASING PLAN.

EXISTING EAST PARKING DECK ELECTRICAL WORK:
REFER TO 'PKE' SHEETS FOR ELECTRICAL SCOPE OF WORK RELATED TO THE PARKING DECK.

- DEMOLITION SITE NOTES:
- GENERAL NOTES:
1. LIGHT SYMBOLS AND TEXT REPRESENT EQUIPMENT/DEVICES THAT ARE EXISTING AND ARE TO REMAIN. DARK AND/OR DASHED SYMBOLS AND TEXT REPRESENT EQUIPMENT/DEVICES THAT SHALL BE DEMOLISHED.
 2. DEMOLISH EXISTING DEVICE INDICATED. DEMOLISH ALL ASSOCIATED BOXES, RACEWAY, AND CONDUCTORS BACK TO SOURCE OR TO THE EXTENT OF WHICH THE INTEGRITY OF ANY DEVICES SHARING SUCH BOXES, RACEWAY, CABLES, OR CONDUCTORS ARE MAINTAINED (i.e. ADJACENT UNAFFECTED SPACES OR DEVICES ON SAME CIRCUIT).
 3. DEVICES OR LUMINARIES BEING DEMOLISHED SHALL BE PRESENTED TO OWNER FOR SALVAGE. IF UNWANTED DISPOSE OF DEVICES, FIXTURE, AND/OR LAMPS PROPERLY.

- KEYED NOTES:
1. EXISTING SITE LIGHT SHALL BE REMOVED AND SALVAGED FOR RE-USE IN NEW LOCATION. BOTH POLE AND FIXTURE SHALL BE SALVAGED. POLE BASE SHALL BE DEMOLISHED IN ITS ENTIRETY. MAKE NOTE OF EXISTING BOLT CIRCLE DIMENSIONS FOR NEW POLE BASES. DEMOLISH EXISTING BRANCH CIRCUIT WIRING AND GROUNDING AS SHOWN.
 2. EXISTING SITE LIGHT SHALL REMAIN. EXISTING BRANCH CIRCUIT WIRING TO THE REMAINING SITE LIGHTS TO THE NORTH SHALL REMAIN. BRANCH CIRCUIT WIRING TO THE SOUTH SHALL BE DEMOLISHED AS SHOWN. SITE LIGHT SHALL BE RE-FED FROM NEW BRANCH CIRCUIT WIRING AS SHOWN ON SHEET ES.1.
 3. SALVAGE HOMERUN WIRING FOR RE-USE. PROVIDE A HAND HOLE IN THE LOCATION OF THE EXISTING POLE BASE FOR A SPLICE POINT TO RE-FEED THE DRIVE SITE LIGHTING - REFER TO SHEET ES.1 FOR FURTHER INFORMATION.
 4. FLAG POLE, EACH WITH THREE LED FIXTURES MOUNTED TO BASE OF POLE. DEMOLISH FIXTURES AND BRANCH CIRCUIT WIRING BACK TO NEAREST SURFACE.
 5. EXISTING 240V POWER FEED TO ELECTRONIC SIGN IN PARKING GARAGE. DUE TO THE GRADING FOR THE NEW GARAGE ENTRANCE, THIS FEED SHALL BE REPLACED. DEMOLISH UNDERGROUND FEED BACK TO EXISTING HANDHOLE.

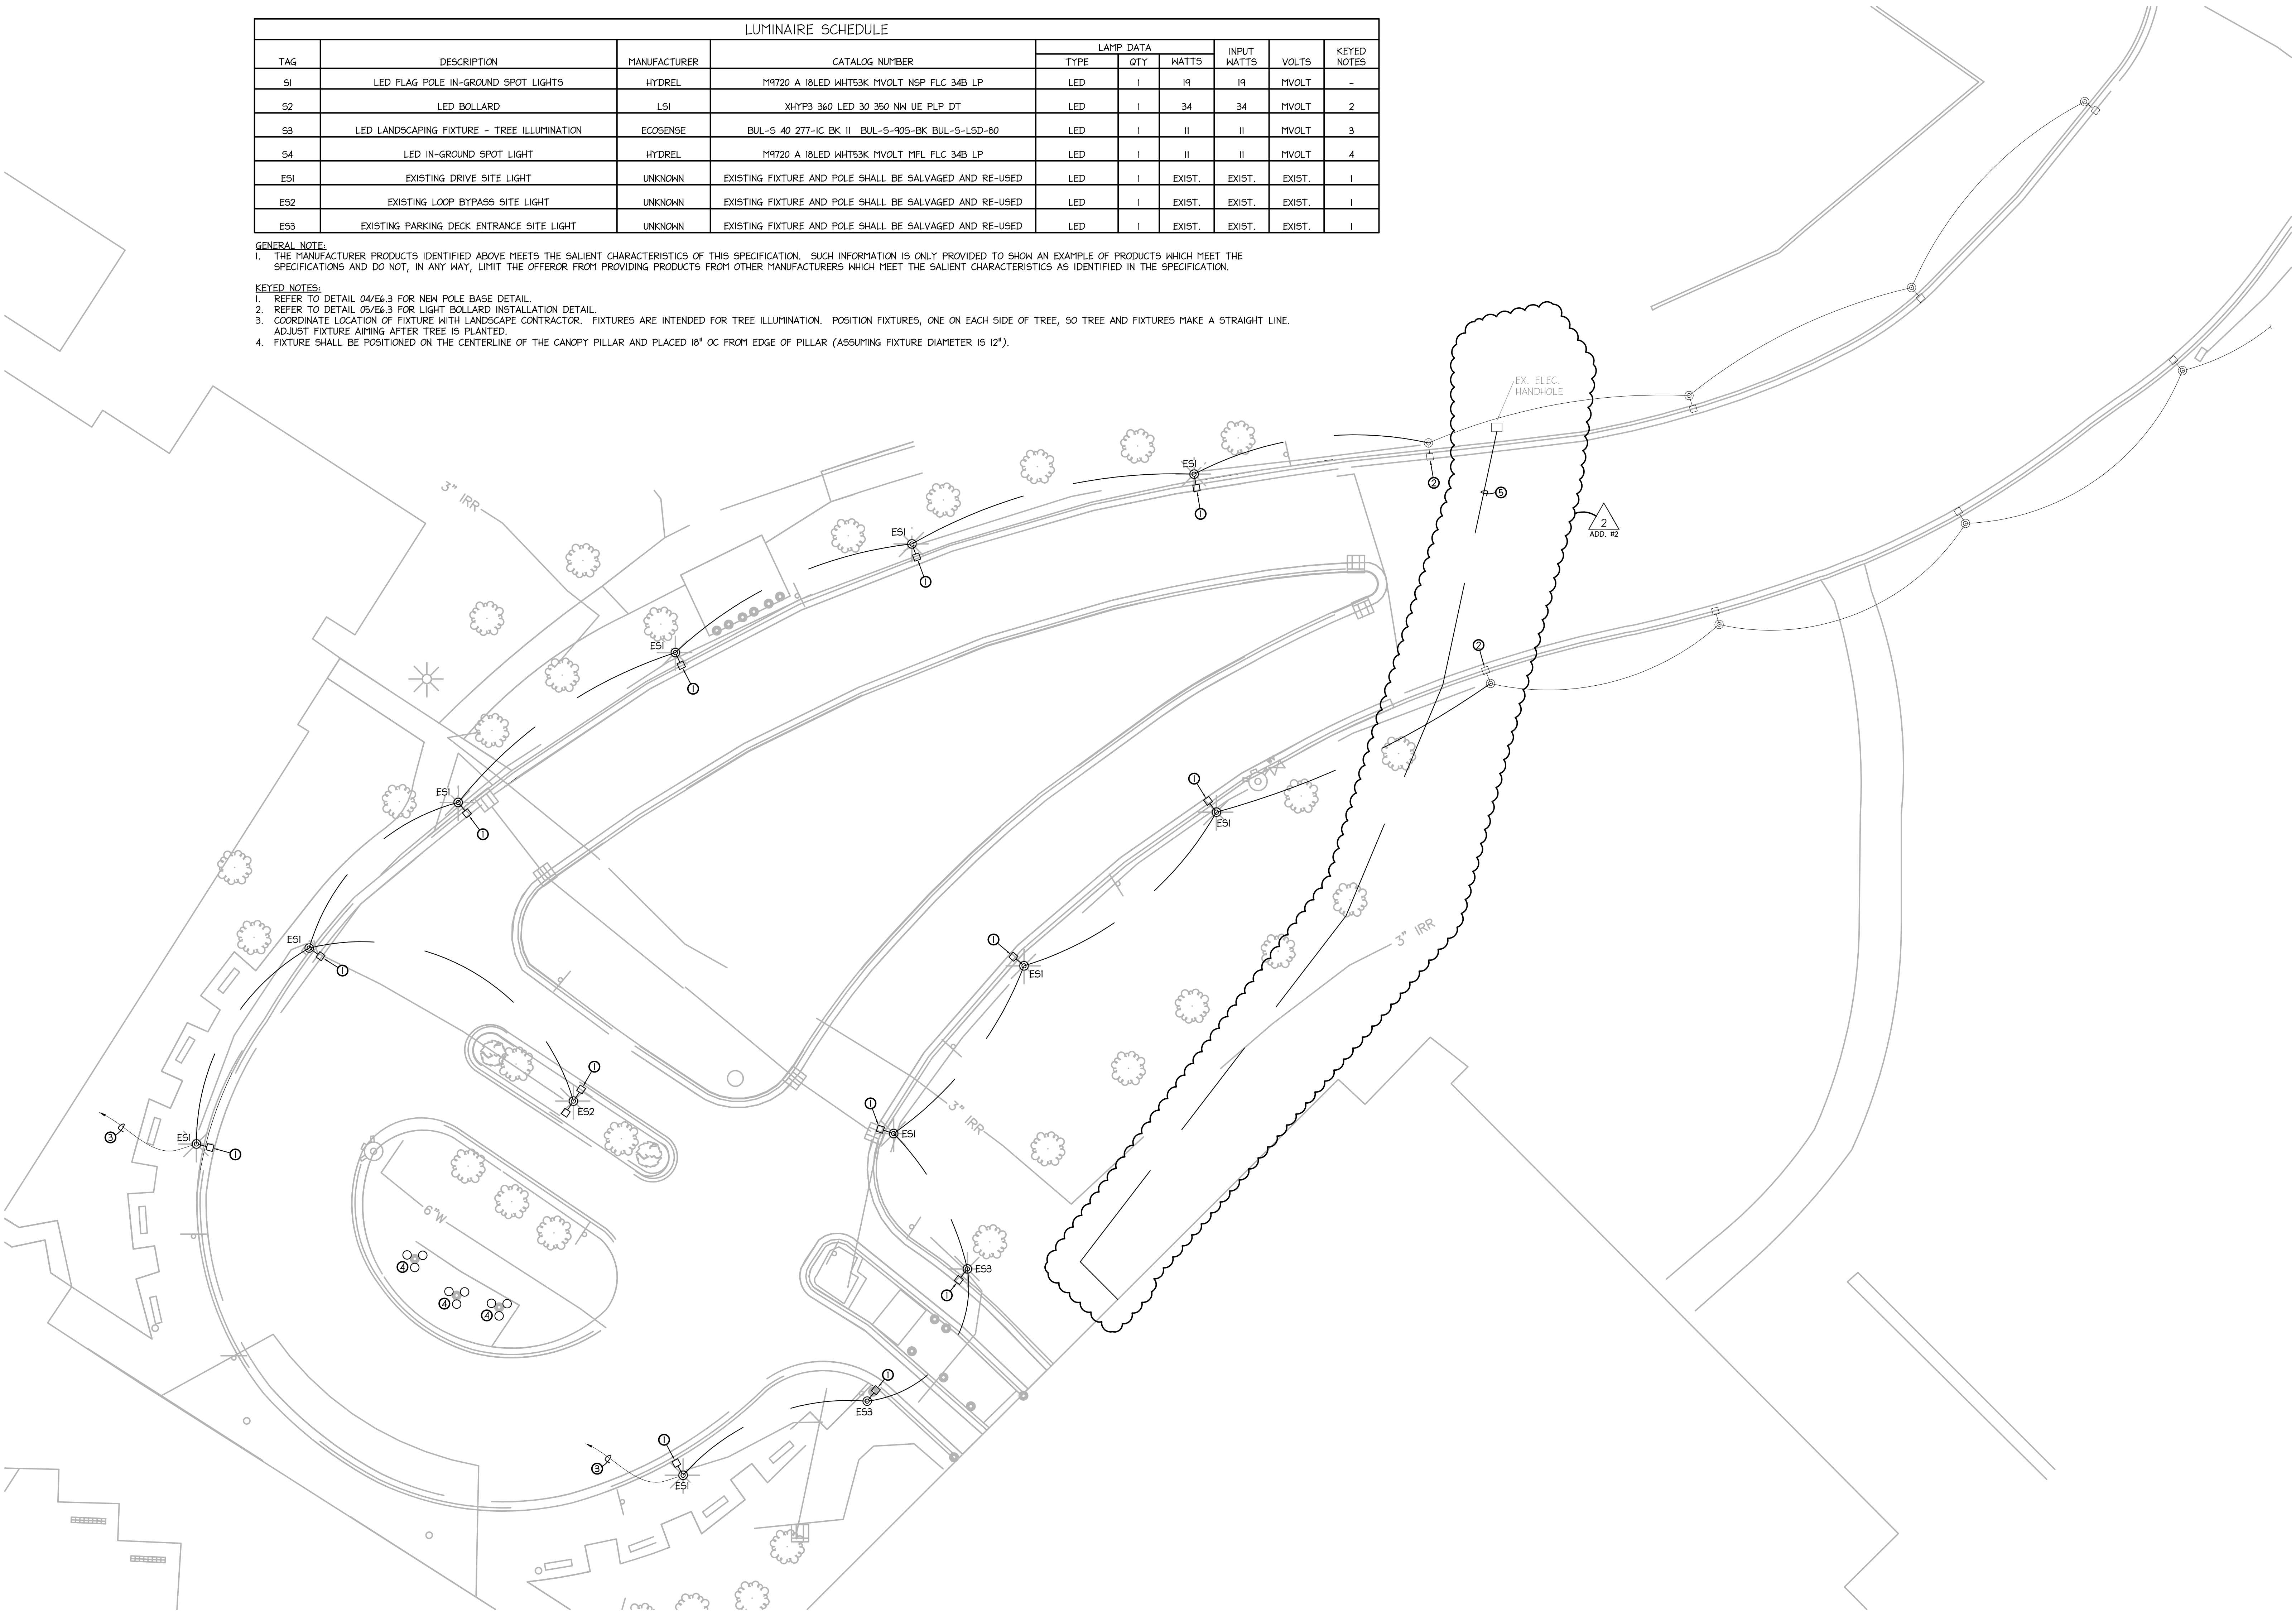

NORTH
DEMOLITION ELECTRICAL SITE PLAN
SCALE: 1" = 16'-0"

35% SCHEMATIC SUBMISSION	10/28/2014
65% DESIGN DEVELOPMENT SUBMISSION	01/20/2015
95% CONSTRUCTION DOCUMENT SUBMISSION	02/27/2015
100% BID DOCUMENT SUBMISSION	04/14/2015
ADDENDUM #2	08/31/2015
Revisions:	Date

CONSULTANTS:

ARCHITECT/ENGINEERS:



DIEKEMA HAMANN
architecture+engineering
612 South Park Street
Kalamazoo, Michigan 49007
15 Ionia Ave SW
Grand Rapids, Michigan 49503
TL 269.373.1108
FX 269.373.1186

Drawing Title
DEMOLITION ELECTRICAL SITE PLAN

Approved: Project Director

Project Title
EXPAND AMBULATORY CARE
CLINICAL EXAM ROOMS

Location
ANN ARBOR VAMC

Date
APRIL 14, 2015

Checked
BM

Drawn
SH

Project Number
506-328
Building Number
1

Drawing Number

EDS.1
Dwg132 of 175

Office of
Construction
and Facilities
Management

