
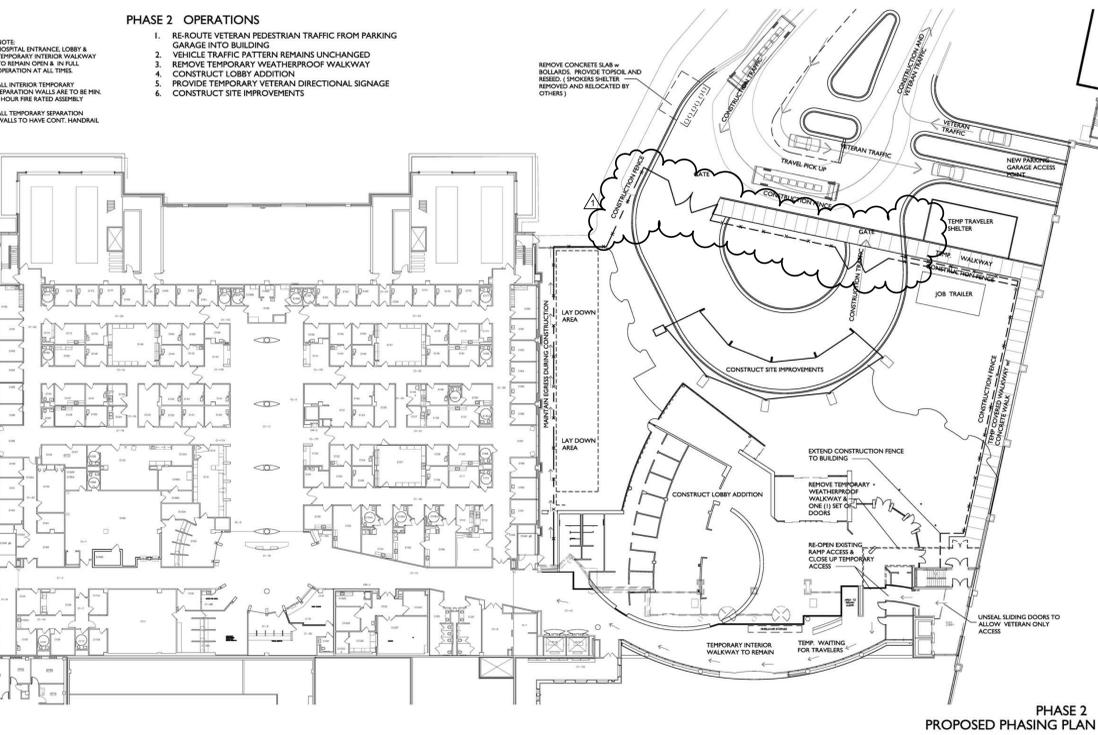


three inches = one foot
 one and one half inch = one foot
 one inch = one foot
 three quarter inch = one foot
 three eighths inch = one foot
 one quarter inch = one foot
 one eighth inch = one foot

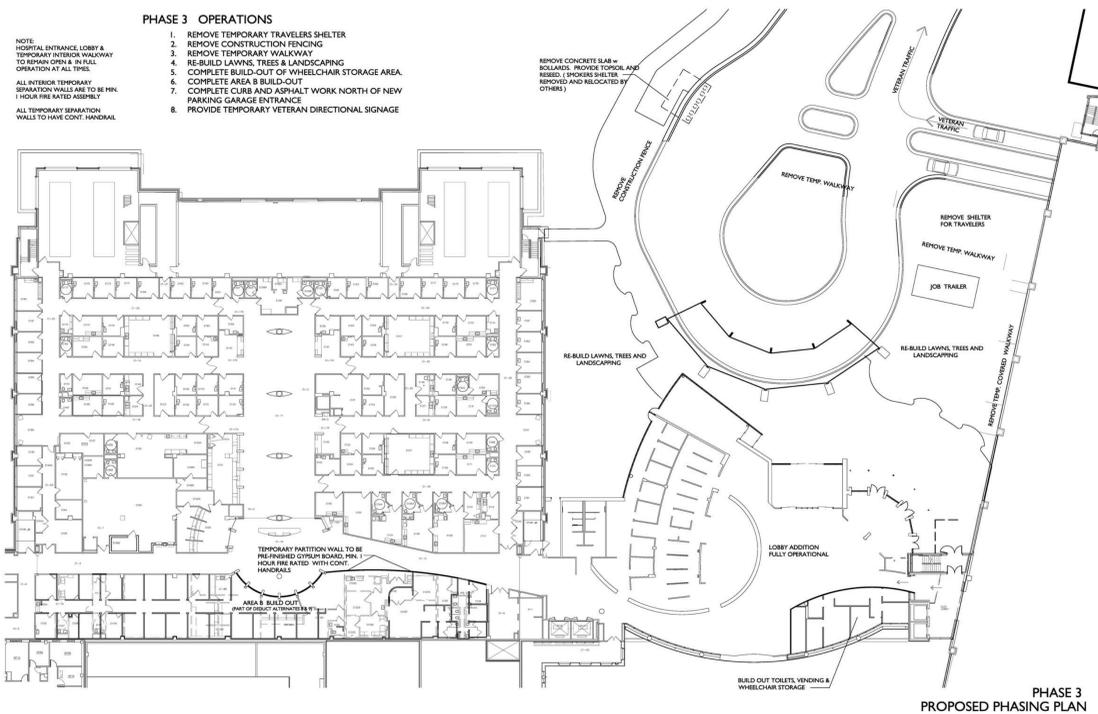

DEDUCTIVE ALTERNATE LIST

- REMOVE LANDSCAPING FROM THE PROJECT SCOPE
- REMOVE OUTDOOR EVENT CENTER TERRACE FROM THE PROJECT SCOPE
- REMOVE VEG/PATENT ADVOCATE OFFICES FROM THE PROJECT SCOPE
- REMOVE INTERIOR DOORS AT THE EVENT CENTER FROM THE PROJECT SCOPE
- REMOVE THE OUTDOOR TRELLIS AT THE EVENT CENTER FROM THE PROJECT SCOPE
- RE-USE ALL TERRAZZO FLOORING TO LVY FLOORING
- REMOVE THE TWO END SECTIONS OF THE DROP-OFF CANOPY FROM THE PROJECT SCOPE
- REMOVE ALL WORK IN THE PHLEBOTOMY AREA FROM THE PROJECT SCOPE
- REMOVE ALL WORK IN THE CLINICAL EXAM AREA FROM THE PROJECT SCOPE
- REMOVE THE SIGN MOUNT SYSTEM FROM THE PROJECT SCOPE

CONSULTANTS

TECHNOLOGY
 SECANT TECHNOLOGIES
 6995 TECHNOLOGY AVE. SUITE A
 KALAMAZOO, MI 49004


STRUCTURAL ENGINEERING
 NIELSEN SVAK
 414 SOUTH BURDICK STREET SUITE 300
 KALAMAZOO, MI 49001

CIVIL ENGINEERING
 VINDIS DESIGN GROUP
 313 NORTH BURDICK
 GRAND RAPIDS, MI 49501

COST CONSULTANT
 MIDDLETON CONSTRUCTION CONSULTANTS
 330 EAST HILBORN AVENUE
 SUITE 505
 MOUNTAIN VIEW, MI 49801


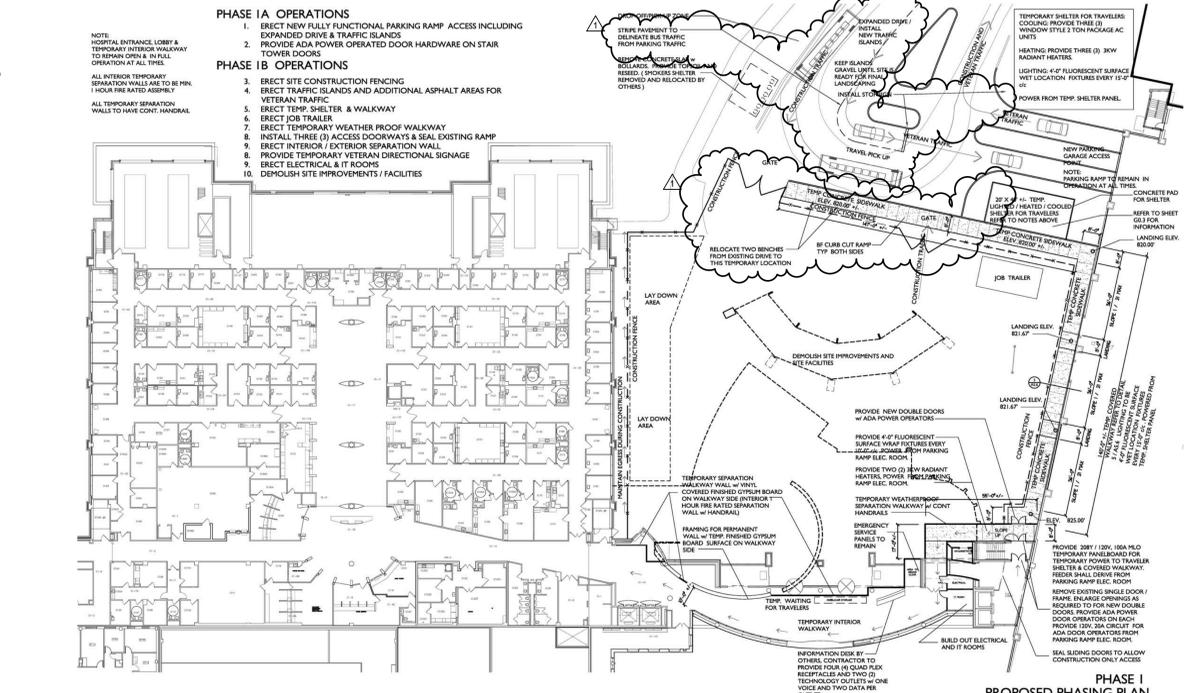

CONSULTANTS:

35% SCHEMATIC SUBMISSION	10/28/2014
65% DESIGN DEVELOPMENT SUBMISSION	1/20/2015
95% CONSTRUCTION DOCUMENT SUBMISSION	2/27/2015
100% BID DOCUMENT SUBMISSION	04/14/15
ADDENDUM #1	08/18/15
Revisions:	Date

ARCHITECT/ENGINEERS:

DIEKEMA | HAMANN
 architecture+engineering

612 South Park Street
 Kalamazoo, Michigan 49007
 15 Ionia SW - Suite 330
 Grand Rapids, Michigan 49503
 TL 269.373.1108
 FX 269.373.1186

GENERAL INFORMATION

Drawing Title: EXPAND AMBULATORY CARE CLINICAL EXAM ROOMS

Project Number: 506-328

Building Number: 1

Location: ANN ARBOR VAMC

Date: AUGUST 18, 2015

Checked: SBD

Drawn: JL

Dwg. 3 of 175

Office of Construction and Facilities Management

Department of Veterans Affairs

VA FORM 08-6231

DHAE PROJECT NO.: 13057.00