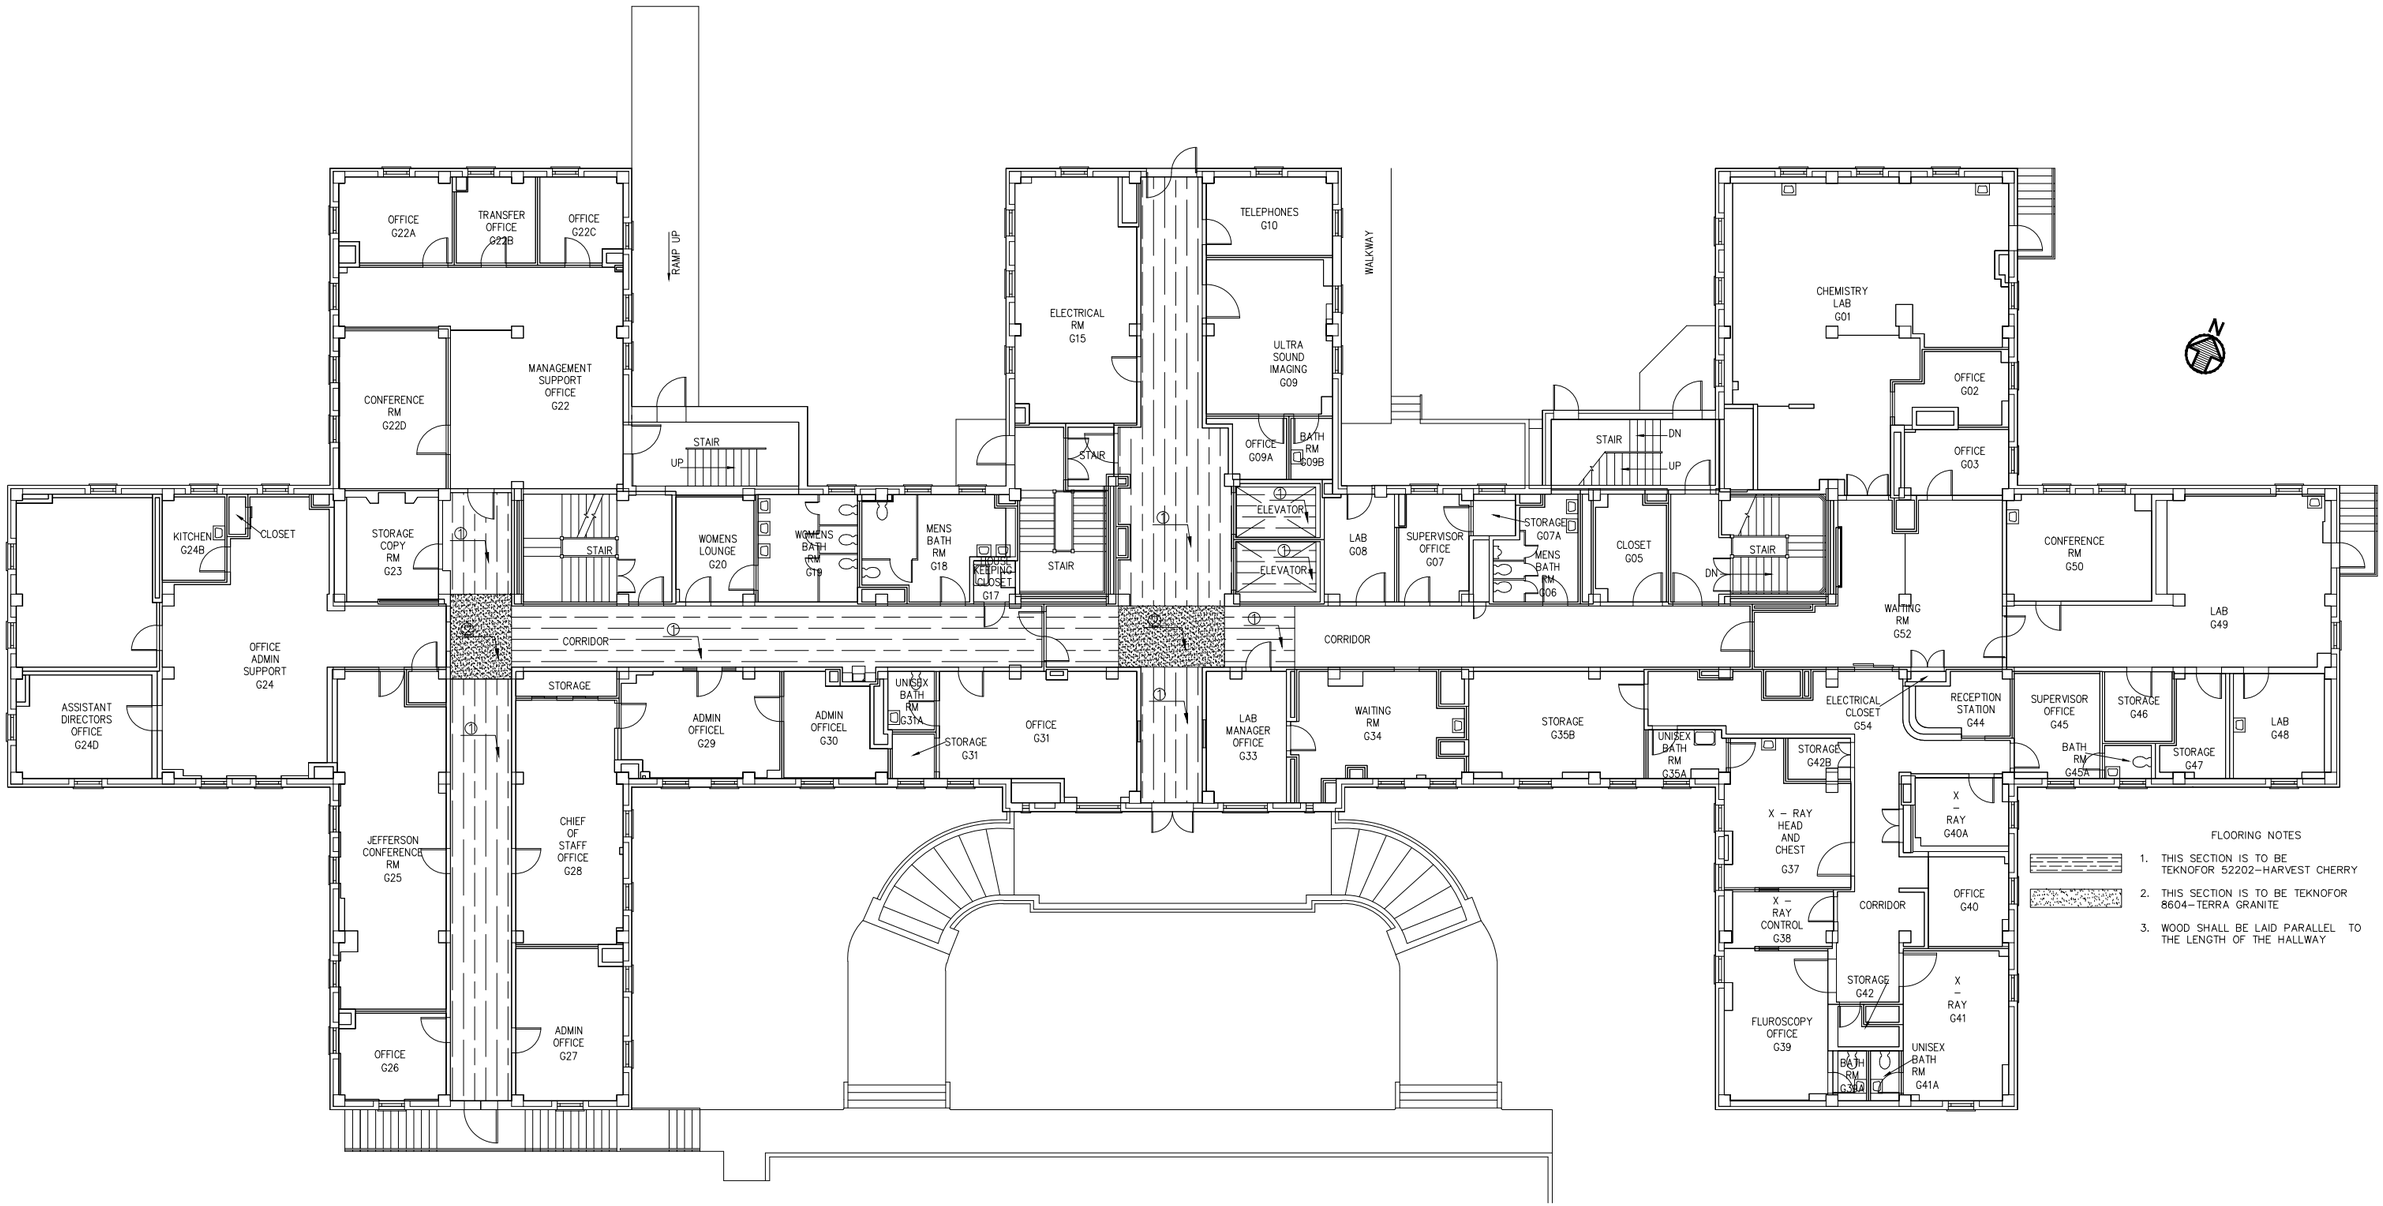

Revisions	Date		Professional Seal	Indus Systems, Inc. 2352, Main Street, Concord MA 01742 Tel: 978-461-0555 www.indus-systems.com	Drawing Title: GROUND FLOOR PLAN ARCHITECTURAL Approved: Approved:	Project Title: AS-BUILT Drawings Building Number: 01 Checked Drawn Location: VAMC COATESVILLE	Date: 11-24-2010 Project No. Drawing No.

VAMC, COATESVILLE

Department of Veterans Affairs