


GREEN COLOR DENOTES EXISTING HANDRAILS, GUARDRAILS & CORNER GUARDS TO REMAIN

THIS PORTION OF THE B WING HALLWAY, BETWEEN THE TWO DOORS, IS NOT IN CONTRACT

PROPOSED ACCENT WALLS

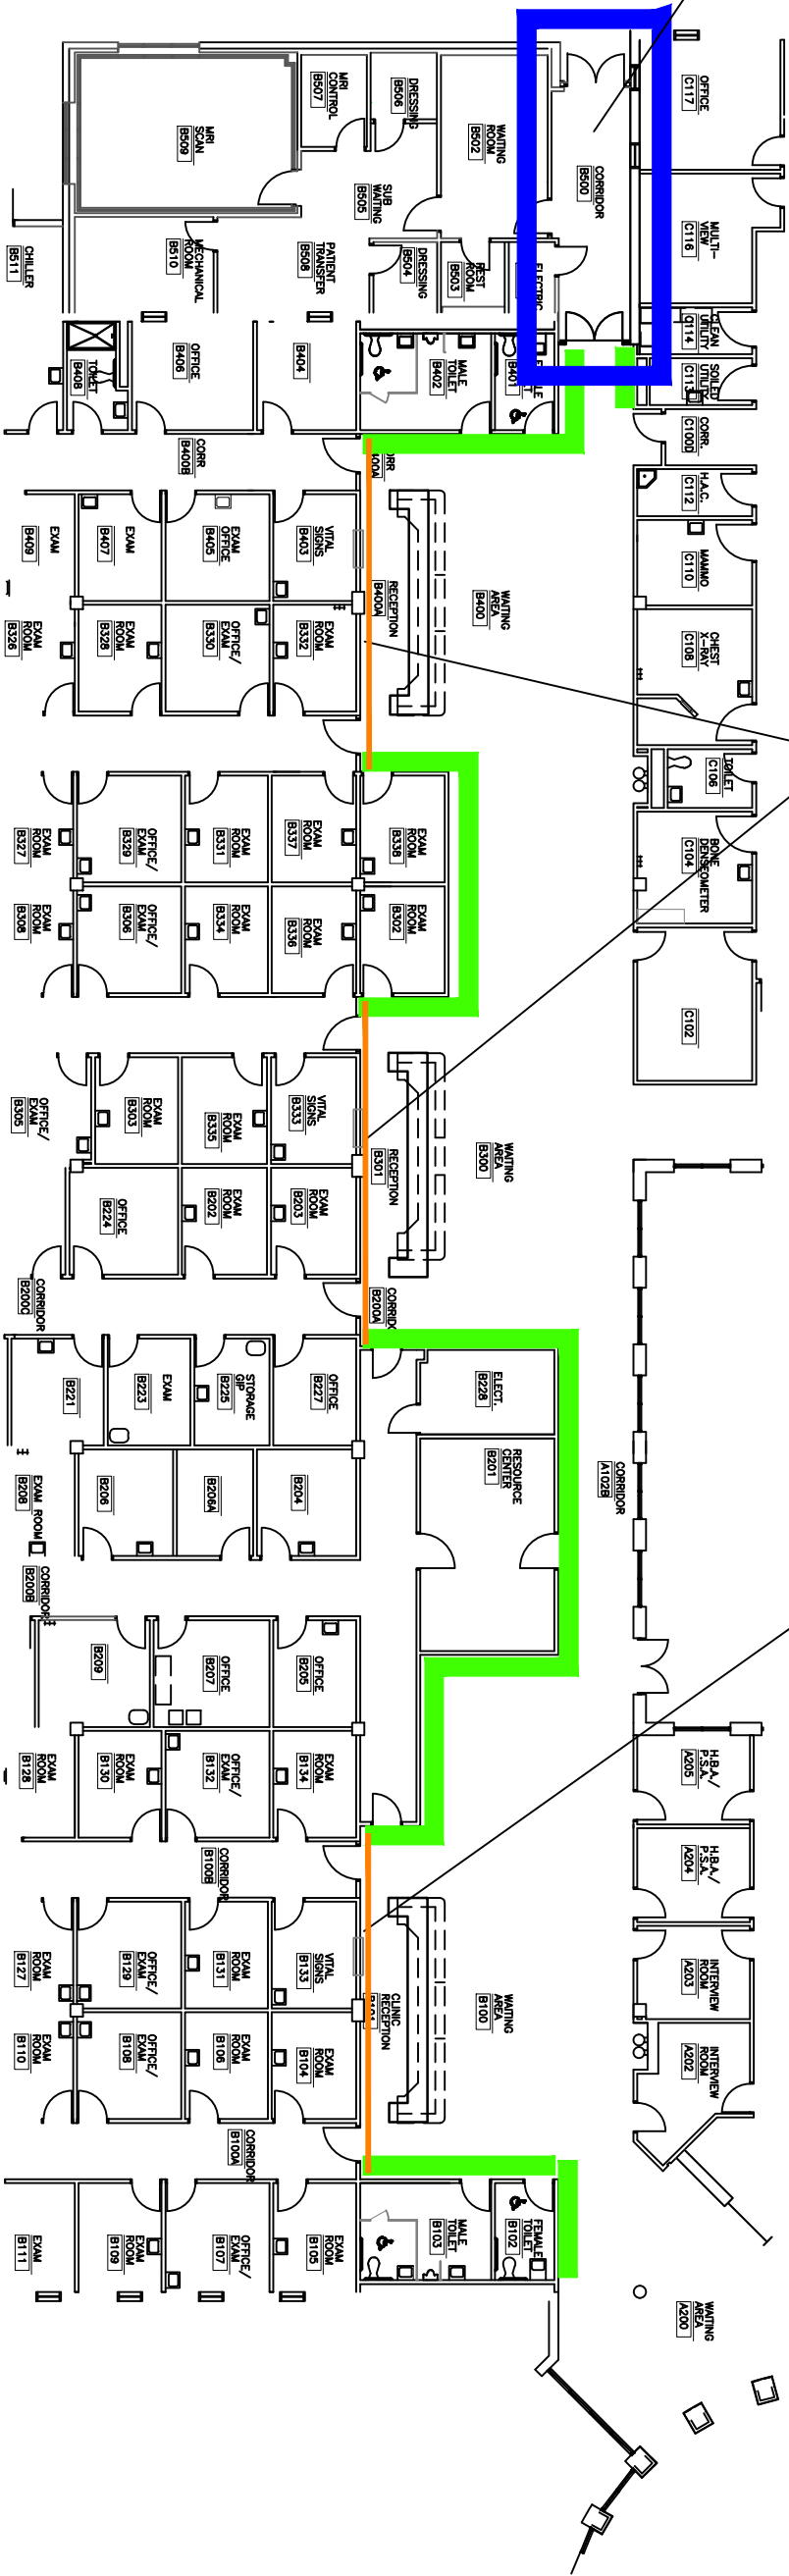

B WING

NTS

DATE: SEP 08, 2015