


three inches = one foot
one and one half inches = one foot
one inch = one foot
three quarters inch = one foot
one half inch = one foot
three eighths inch = one foot
one quarter inch = one foot
one eighth inch = one foot

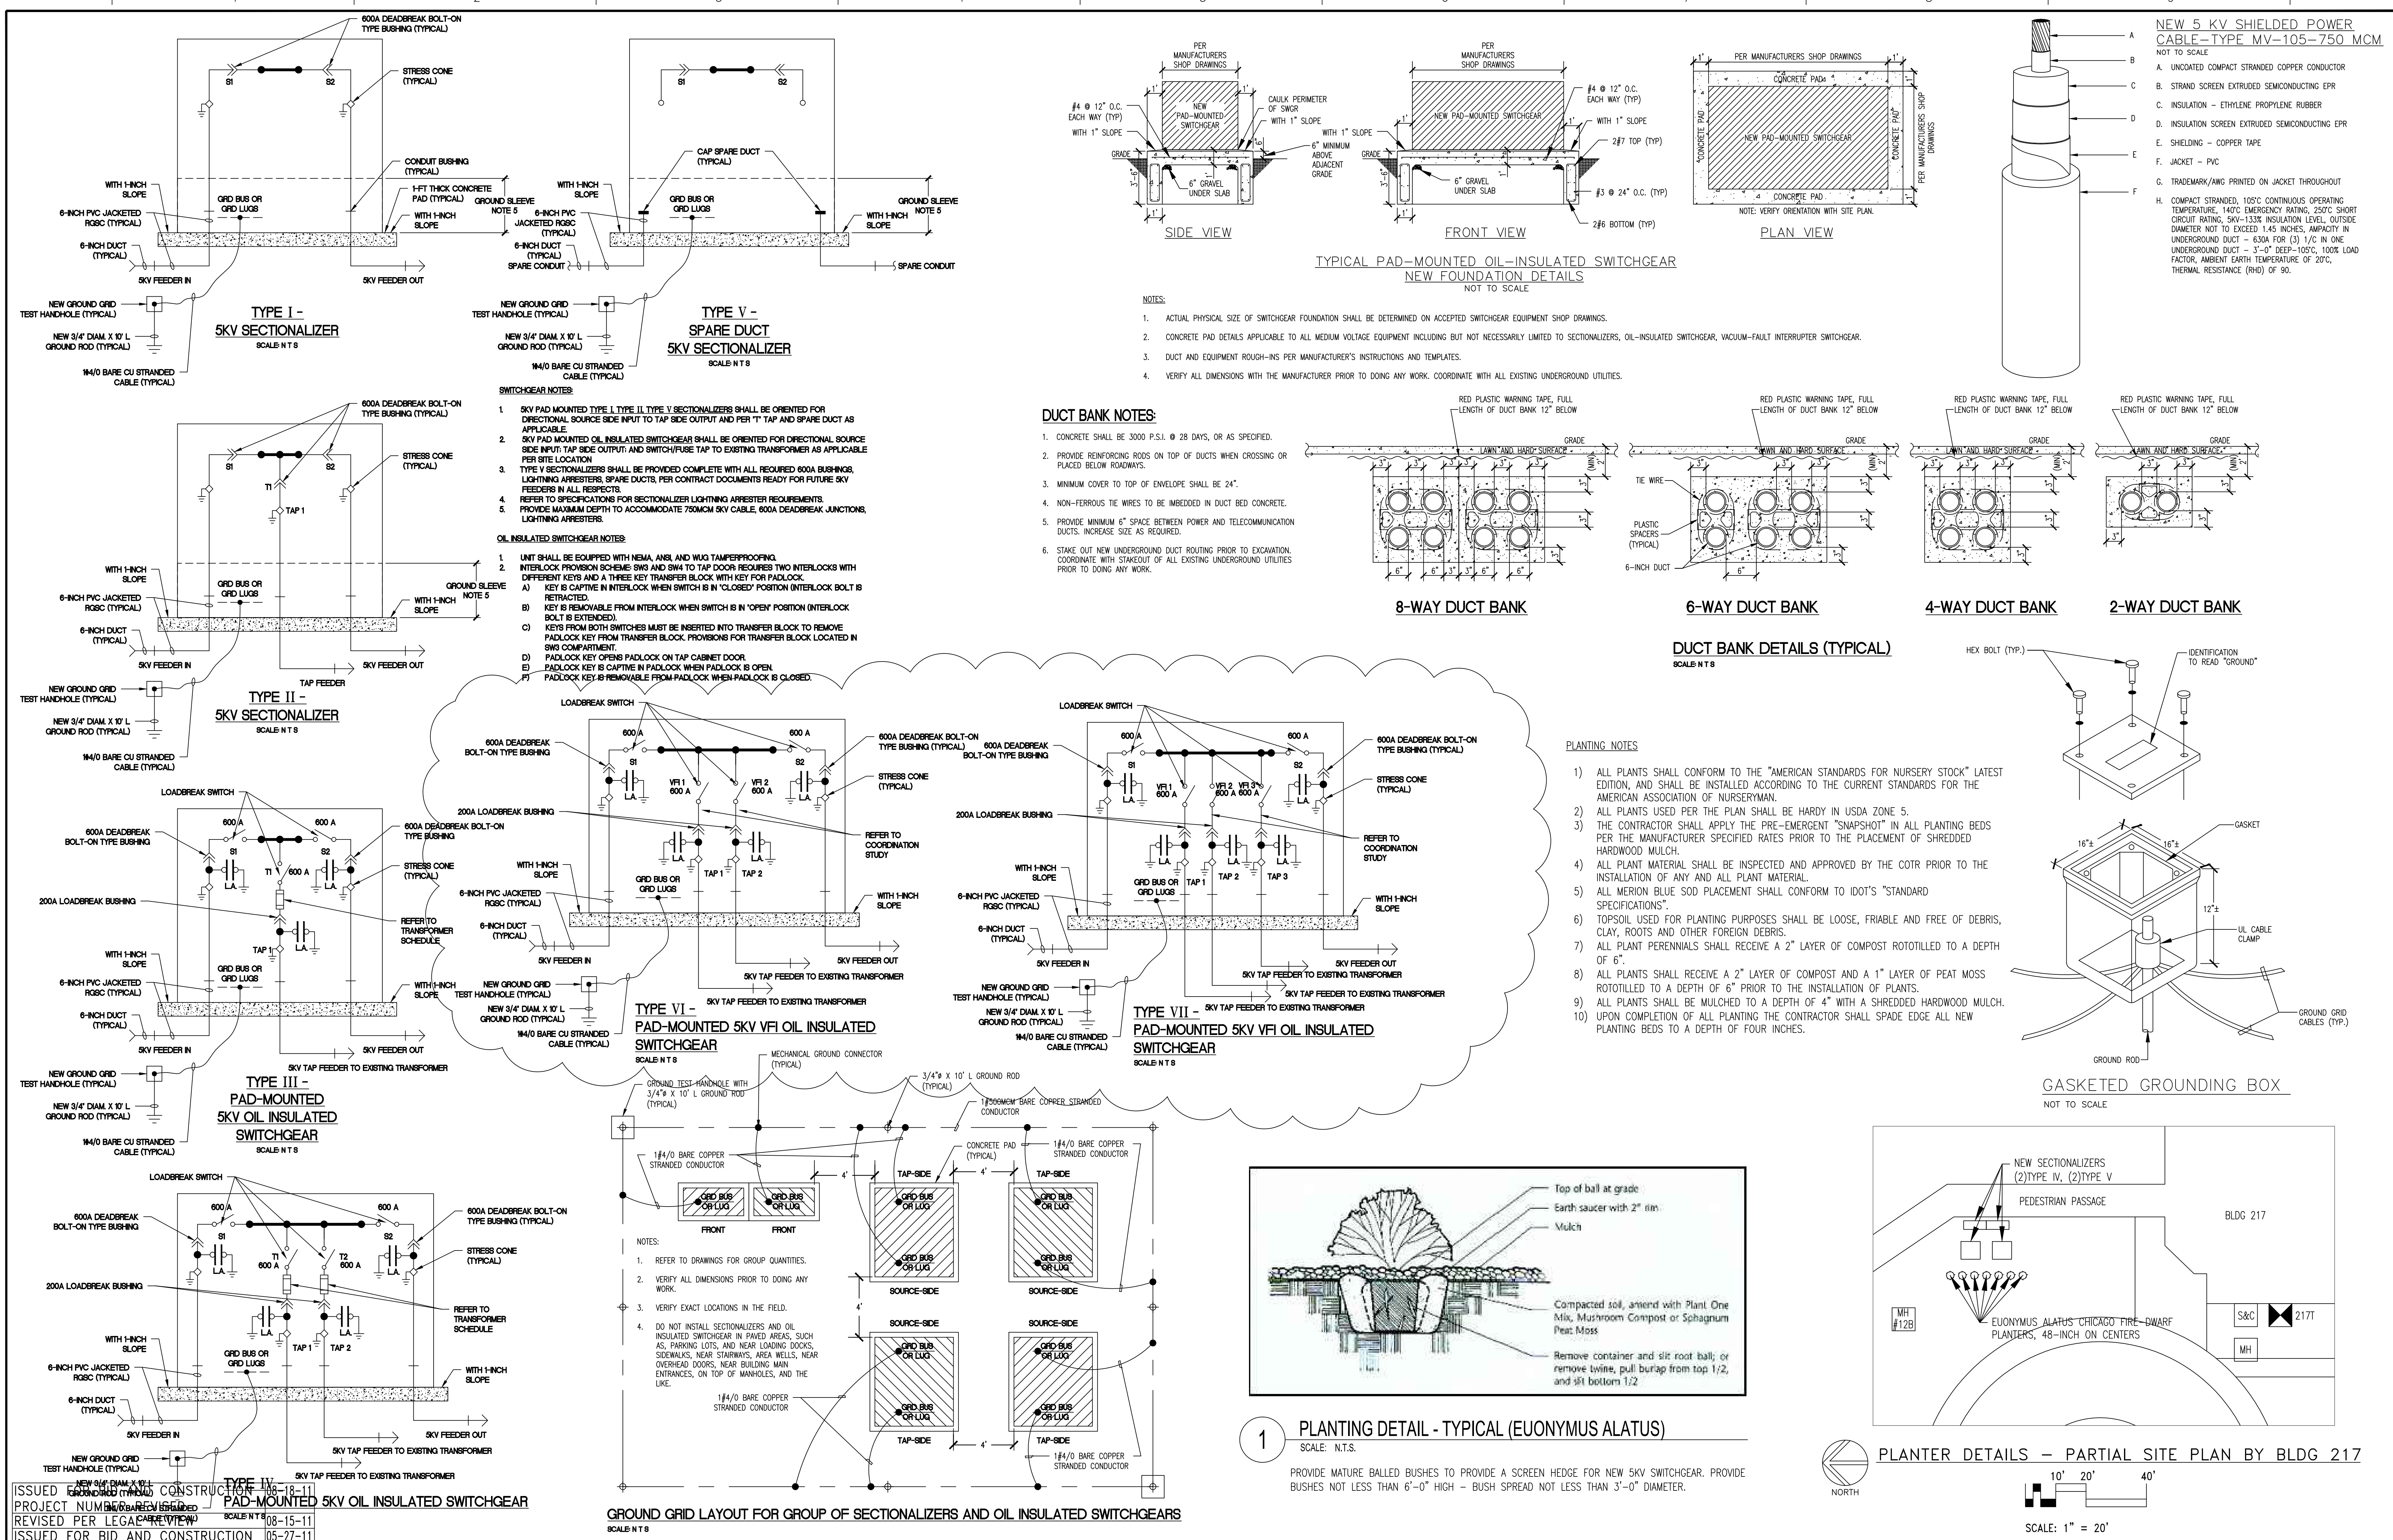

ISSUED FOR CONSTRUCTION 08-15-11
PROJECT NUMBER 578-11-103
REVISED PER LEGAL REVIEW 05-27-11
VOID ISSUED FOR BID AND CONSTRUCTION DATED 12-17-09
AMENDMENT NO. 3 - ISSUED FOR BID AND CONSTRUCTION 06-22-10
ISSUED FOR BID AND CONSTRUCTION 12-17-09
FOR CIVIL REVIEW 11-19-09
PROJECT 100% SIGN-OFF 08-20-09
100% DRAWINGS ISSUED FOR VA TECHNICAL REVIEW 08-05-09
AND LEGAL REVIEW - NOT FOR BID AND CONSTRUCTION
100% Review Submittal - NOT FOR BID AND CONSTRUCTION 06-26-09
50% Review Submittal - NOT FOR BID AND CONSTRUCTION 06-05-08
Revisions

CONSULTANTS: Manhard CONSULTING LTD 800 Woodlands Parkway, Vernon Hills, IL 60061 tel: (847) 634-5550 fax: (847) 634-0095 www.manhard.com Civil Engineers - Surveyors - Water Resources Engineers - Water & Wastewater Engineers Construction Managers - Environmental Scientists - Landscape Architects - Planners		ARCHITECT/ENGINEERS: MELVIN COHEN AND ASSOCIATES ARCHITECTS AND ENGINEERS 223 W. JACKSON, SUITE 820 CHICAGO, IL 60606 TEL: 312-663-3700 FAX: 312-663-4161 E-MAIL: melcohen@xnet.com		Drawing Title 5KV SECTIONALIZERS, OIL-INSULATED SWITCHGEAR, UNDERGROUND DETAILS, LANDSCAPE DETAILS PROJECT DRAWINGS HAVE BEEN PREPARED BASED UPON AVAILABLE HISTORICAL RECORDS, SURVEYS, AND OTHER PROJECT DRAWINGS OR INFORMATION. WHILE THIS INFORMATION IS BELIEVED TO BE RELIABLE, MELVIN COHEN & ASSOCIATES CANNOT ASSURE ITS COMPLETE ACCURACY AND IS NOT RESPONSIBLE FOR THE ACCURACY OF THE PROJECT DRAWINGS OR FOR ANY ERRORS OR OMISSIONS WHICH MAY HAVE BEEN INCORPORATED INTO IT AS A RESULT.	Project Title REPLACE 5KV UNDERGROUND FEEDERS PHASE 5 - 5KV FEEDERS 3A/3B Location V.A. HOSPITAL, HINES, IL. Date 08-18-11	Project Number 578-11-103 Building Number Drawing Number (4192-PR 5) 3A/3B-E6 Dwg 08 of 08	Office of Construction and Facilities Management Department of Veterans Affairs
---	--	---	--	---	---	---	-----------------------------------------------------------------------------------------------