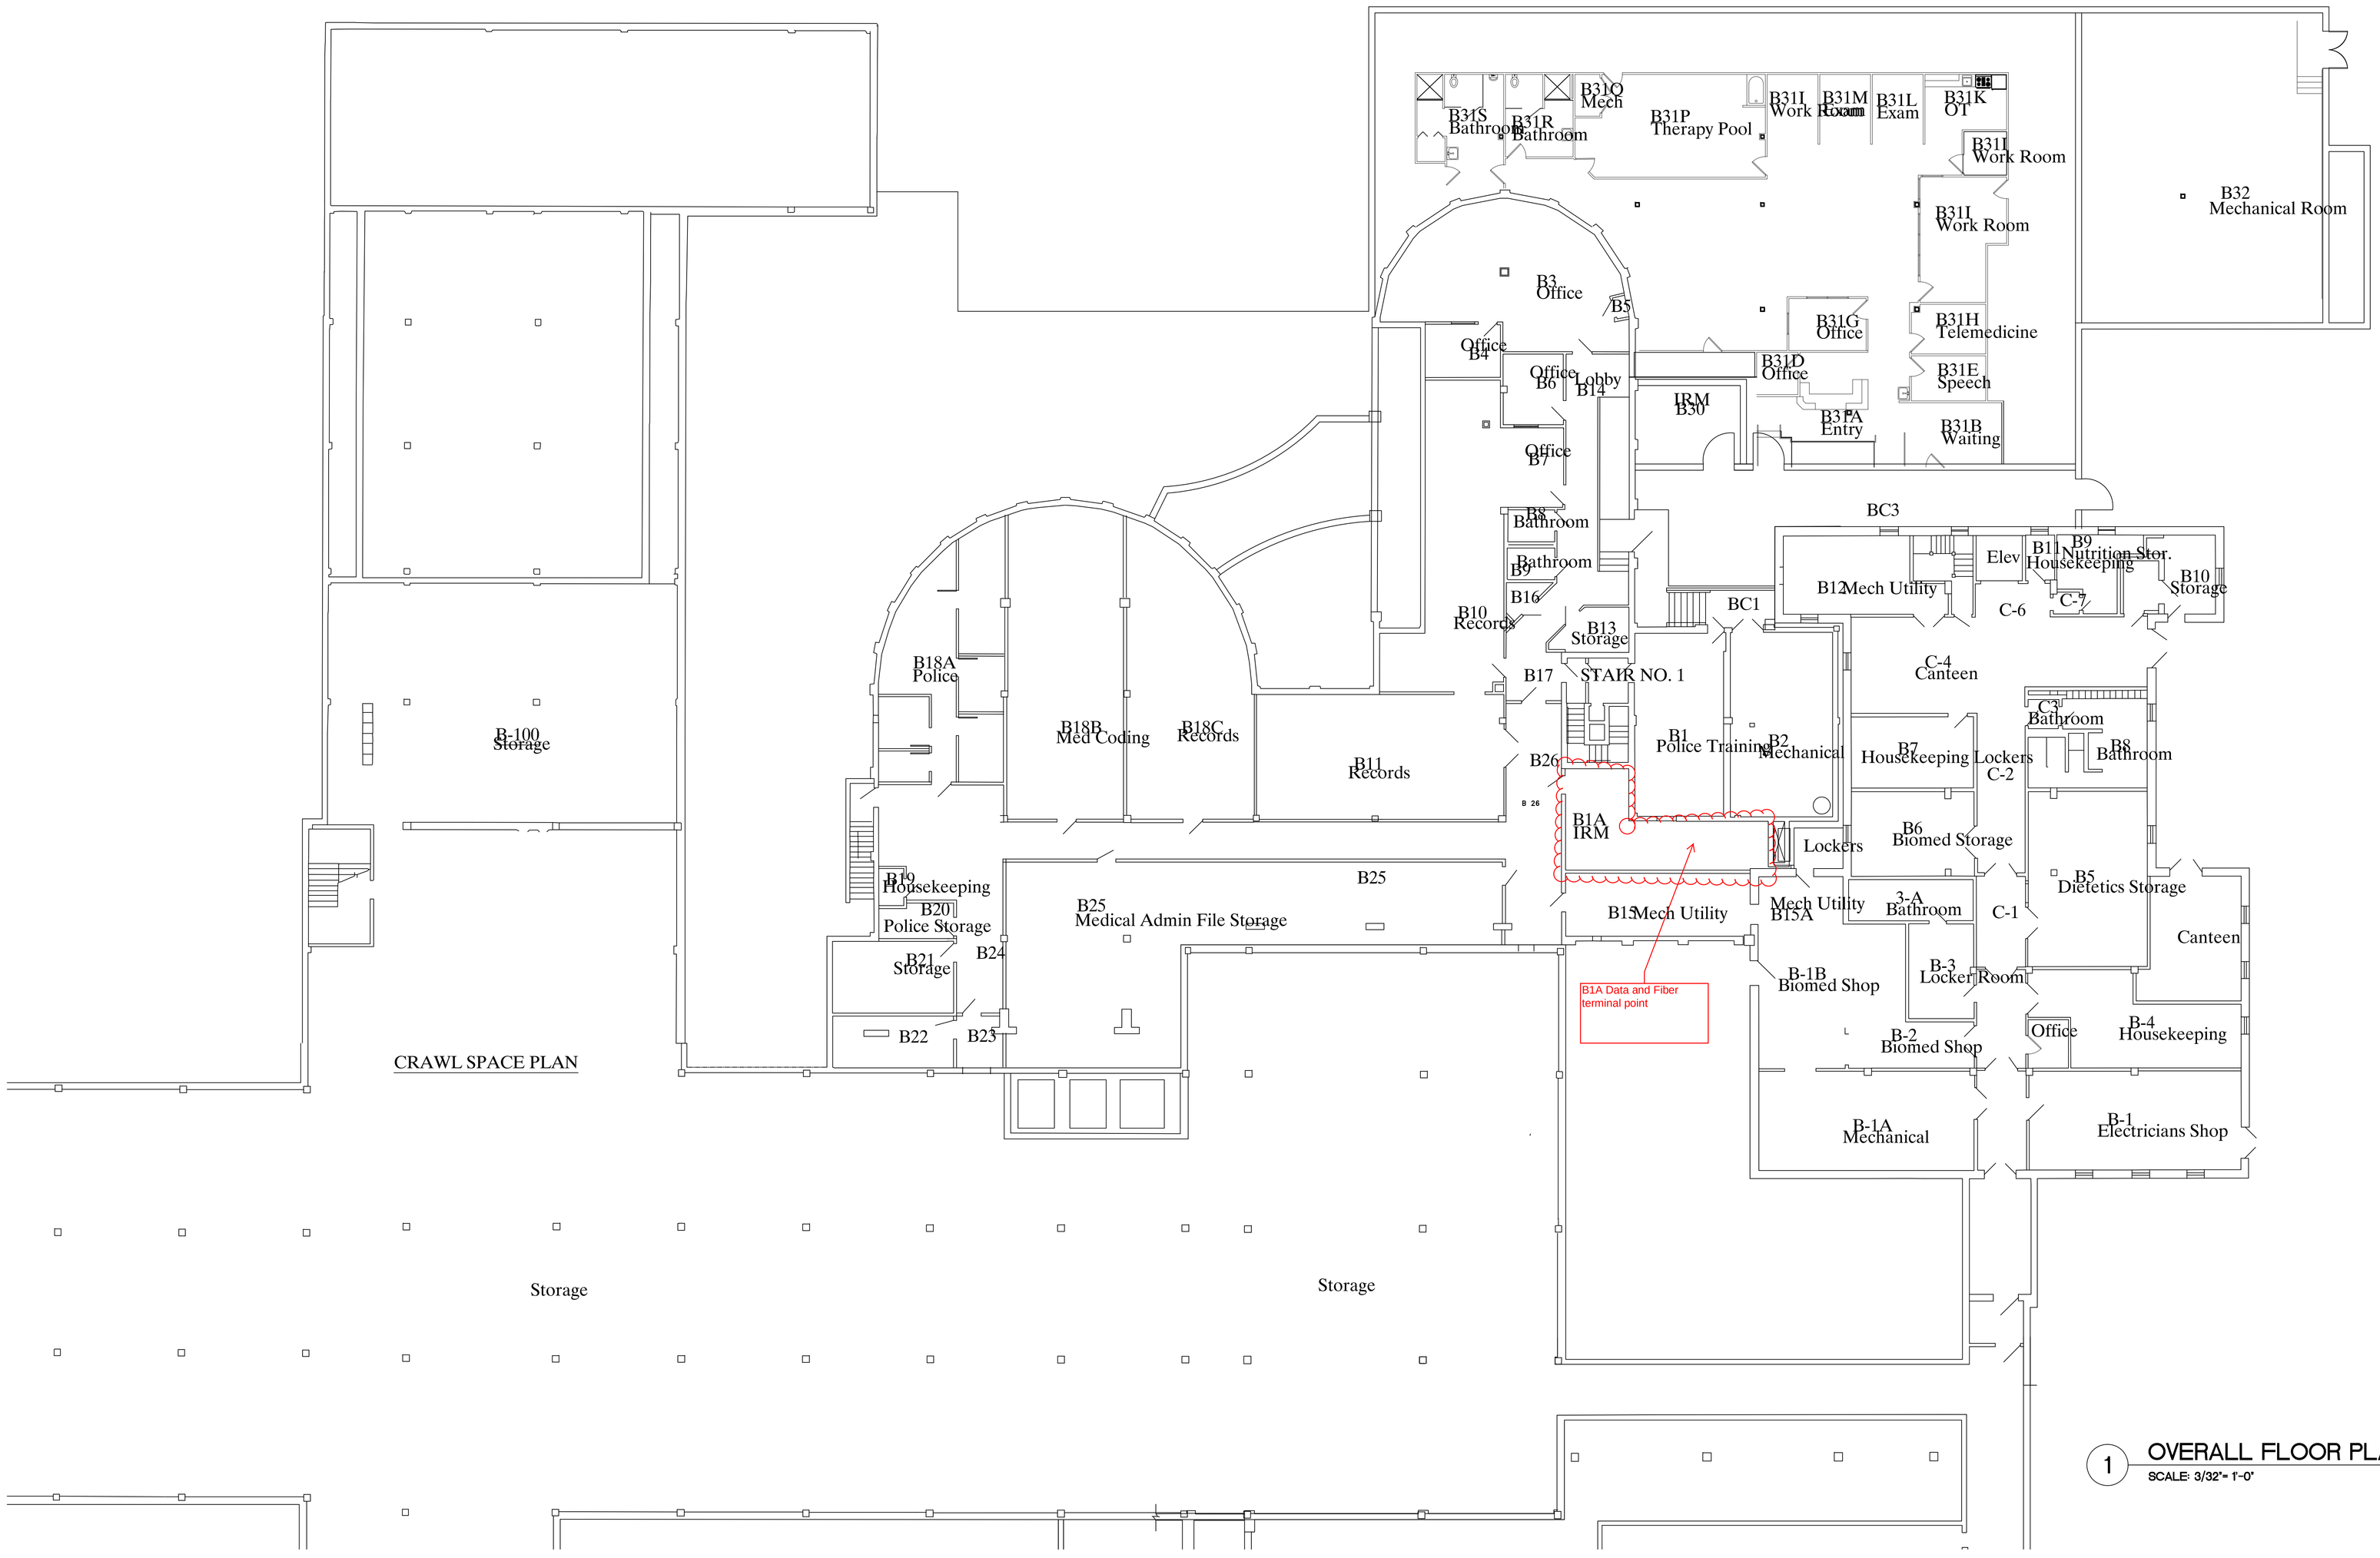

1 OVERALL FLOOR PLAN
SCALE: 3/32"= 1'-0"

Revisions	Date

CONSULTANTS:

ARCHITECT/ENGINEERS:

Drawing Title: HOSPITAL COMPLEX BASEMENT OVERALL FLOOR PLAN

Approved: Project Director: AARON DRIVDAHL, PROJECT ENGINEER, VAMC FORT HARRISON

Project Title: FORT HARRISON RECORD FILE DRAWINGS PHASE II

Location: FORT HARRISON, MONTANA

Date: 07/18/2014 | Checked: T.M. | Drawn: A.T.

Project Number: 436-13-103

Building Number: 154, 154A, 150

Drawing Number: 101

Dwg. 1

Office of Construction and Facilities Management

Department of Veterans Affairs

VA FORM 08-6231