


B.3 ROOF PLAN

1/32"=1'-0"

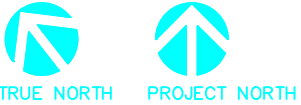

| | | | | | | | | | |
|-----------|--|--|---|--|-----------------------------------|--|---|--|--------------------|
| Revisions | | | CADD Information CAD/B.3/ARCH/B3-A-G.DWG | | Drawing Title: B.3 ROOF PLAN | | Project Title ARCHITECTURAL ASBUILTS | | Date 01/15 |
| | | | Approved: | | Approved: Medical Center Director | | Building Number B. 3 | | Project No. |
| | | | Approved: | | Approved: Chief, Engineering | | Location VAMC, SLC. UTAH. | | DRAWING No. A-4 |
| | | | | | | | | | Dwg. 4 of 4 |