


10B DETAIL  
L4.10 SCALE: 1" = 1'-0"

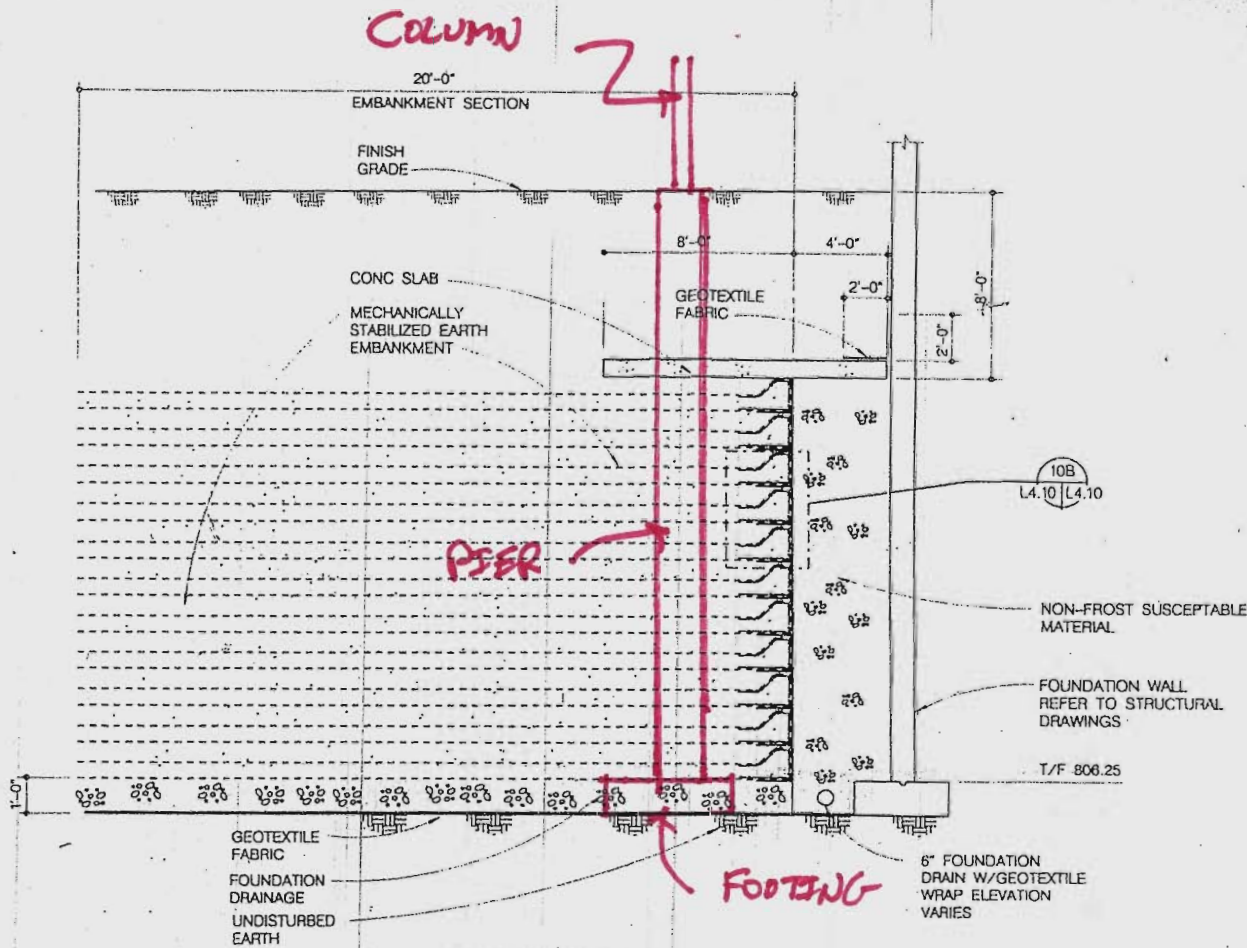

10A MECHANICALLY STABILIZED EARTH EMBANKMENT SECTION  
L4.10 L4.10 SCALE: 3/8" = 1'-0"

CONCEPT "B"

**Harley Ellington  
Pierce Yee Associates, Inc.**  
Architects Engineers Planners Interiors



26913 Northwestern Hwy.  
Suite 200  
Southfield, MI 48034  
313/262-1500

HEPY Project Number:  
**12835**

Drawing Title  
**Enlarged Plans, Sections  
and Details**

Approved Area Project Manager  
*Thomas C. Anglin*

Project Title  
**Clinical Addition  
and Renovation**

Building Number  
**1E**  
Checked  
**LJM**  
Drawn  
**JAR**  
Location  
**VAMC Ann Arbor, Michigan**

Date  
**10/18/94**

Project No.  
**506-027E**

DRAWING NO.  
**L4.10**  
Dwg Cl

