


B.3 ROOF PLAN
1/32"=1'-0"

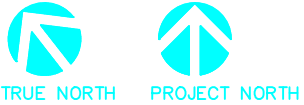

Revisions			CADD Information CAD/B.3/ARCH/B3-A-G.DWG		Drawing Title: B.3 ROOF PLAN		Project Title ARCHITECTURAL ASBUILTS		Date 01/15
			Approved:		Approved: Medical Center Director		Building Number B. 3		Project No.
			Approved:		Approved: Chief, Engineering		Location VAMC, SLC. UTAH.		DRAWING No. A-4
									Dwg. 4 of 4