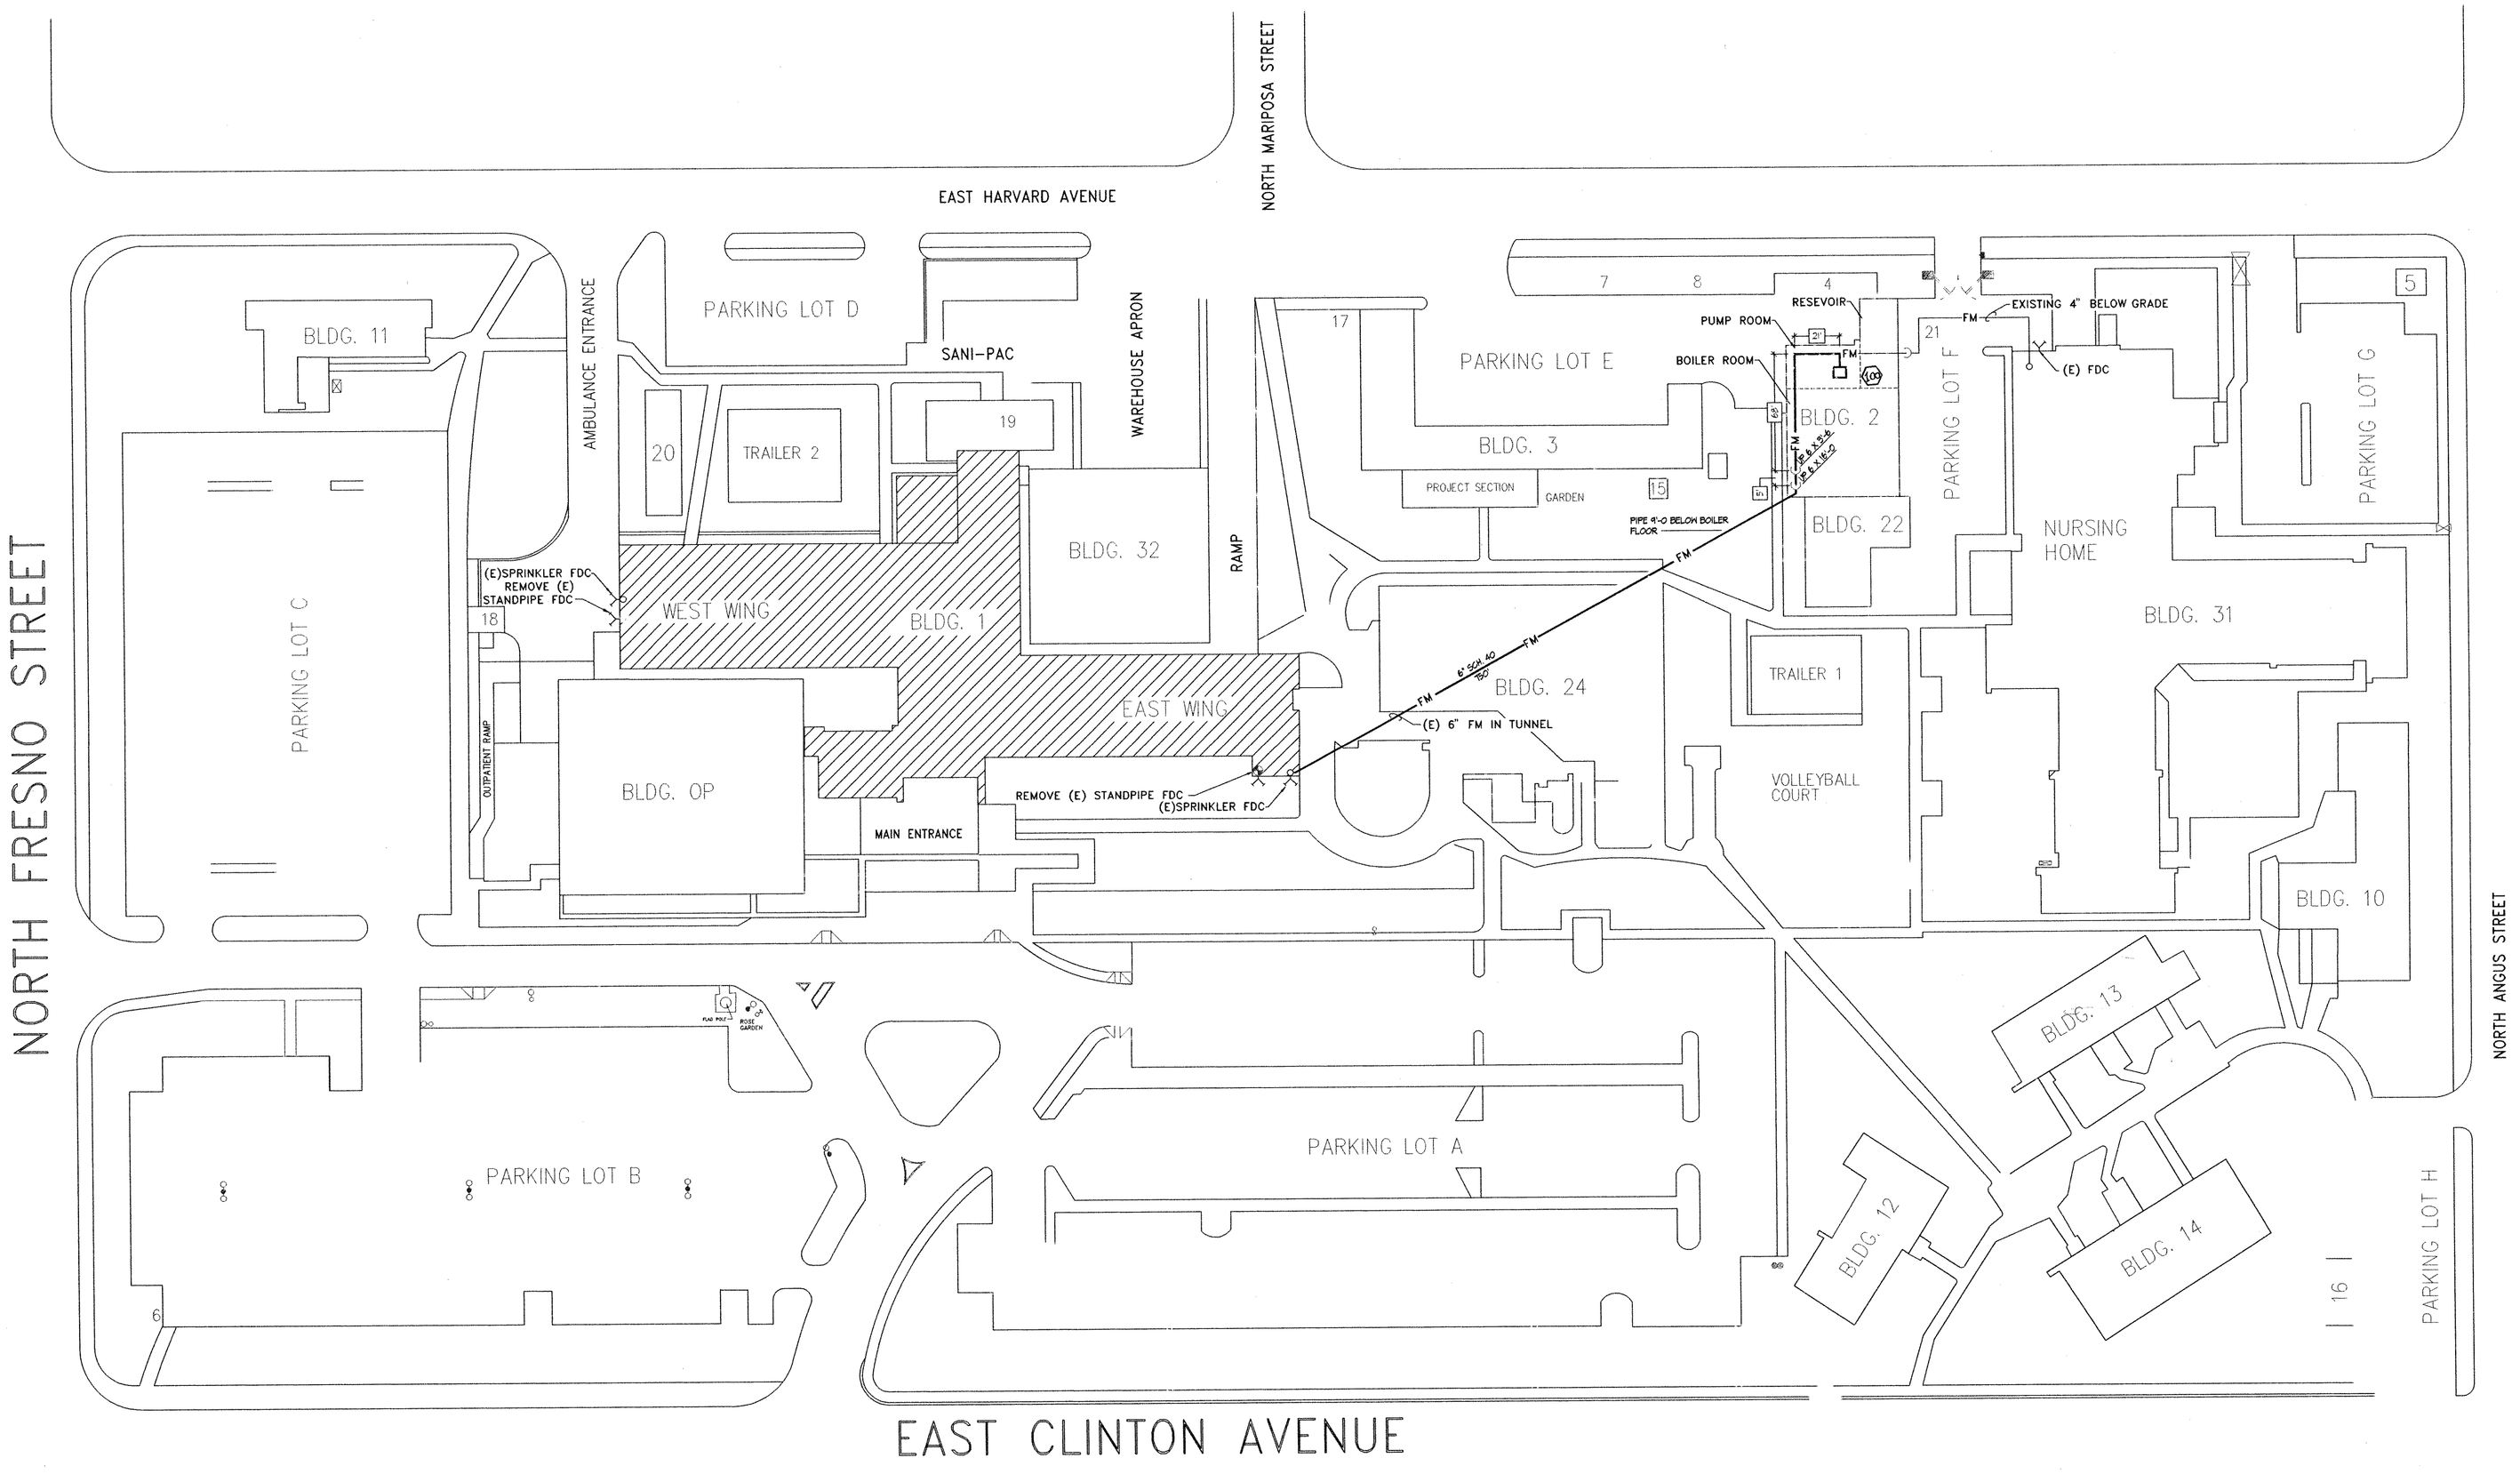

1. MAIN HOSPITAL
2. POWER HOUSE & COOLING TOWER
3. ENGINEERING SHOPS & PROJECT SECTION
4. PUMP, CHLORINATOR & EMERGENCY GENERATOR
5. PUMPHOUSE
6. DISPOSAL WELL
7. GASOLINE PUMP & TANKS
8. STORAGE SHEDS
9. FLAG POLE
10. ENGINEERING & CREDIT UNION
11. PSYCHIATRY AMBULATORY CARE BUILDING
12. PERSONNEL
13. SUPPLY SERVICE
14. FISCAL & ENVIRONMENTAL MANAGEMENT
15. RECREATIONAL STORAGE SHED
16. STORAGE
17. LIQUID OXYGEN TANK
18. O.P. PARKING LOT HANDICAP ELEVATOR
19. ELECTRIC UTILITY AREA
20. CANTEEN PATIO
21. WATER TANK
22. A/C UNITS
24. UC MEDICAL EDUCATION BLDG, LIBRARY
31. 60-BED NURSING HOME CARE UNIT (NHCU)
32. WAREHOUSE

OP. OUTPATIENT CLINIC (BLDG 1)
TRLR 1. SUPPLY STORAGE
TRLR 2. SPD-STORAGE, TEMP. PHARMACY
TRLR 3. OFFICES
TRLR 4. BIO-MEDICAL ENGINEERING

AS BUILT

PROJECT #: 570-97-109

HANGER SYMBOL LEGEND

#1	U-HOOK
#2	SIDE BEAM BRACKET (1/2" ATR & UP)
#2T	THREADED SIDE BEAM BRACKET
#3	CONCRETE SHOT & PIN
#4	COACH SCREW ROD
#5	CONCRETE DROP-IN ANCHOR
#6	TOP BEAM CLAMP W/ RETAINER STRAP
#__	_____

UNDERGROUND FIRE MAIN SYMBOLS

- NEW UNDERGROUND PIPING
- EXISTING UNDERGROUND PIPING
- POST INDICATOR VALVE (PIV)
- KEY VALVE
- FIRE DEPT CONNECTION (FDC)
- FIRE HYDRANT
- SWING CHECK VALVE
- CONCRETE THRUST BLOCK

FIRE SPRINKLER SYSTEM SYMBOL LEGEND

- AUTO SPRINKER RISER
- "RIGID" GRV CPLG
- "FLEX" GRV CPLG
- SOCKET (FIT) FITTING
- SCREWED CAP
- SCREWED PLUG
- PIPE HANGER LOCATION
- (2-1) HANGER TYP & LENGTH
- A1 WELDED MAIN PIECE NO.
- 01 WELD BRANCHLINE PC. NO.
- 01 BRANCH LINE NO.
- EARTHQUAKE BRACE
- HYDRAULIC REF. POINT
- 3'-0" 600 CENTER-LINE DIMENSION

FIRE SPRINKLER LEGEND

SYM	MAKE AND MODEL	K-FAC	SIZE	TEMP	TYPE	FINISH	CANOPY	QTY

Total Sprinklers This Job | Total Sprinklers This Sheet: 0

AUTHORITY HAVING JURISDICTION: DEPT. OF VETERANS AFFAIRS — PHONE: (202) 228-8452

#	Date	By	Revisions
3	7/24/97	T.M.	AS-BUILT DWGS

Contractor: DEPT. OF VETERANS AFFAIRS
Address: 2615 EAST CLINTON AVE. FRESNO, CA 93703
Phone: (209) 228-6452
Architect:
Address:
Phone:

PROJECT: VA MEDICAL CENTER - FRESNO
BLDG. 1
2615 E. CLINTON AVE.
FRESNO, CA 93703
TITLE: SITE / LATERAL PIPING PLAN

A&D FIRE PROTECTION INC.
10759 WOODSIDE AVE. SUITE D
SANTEE, CA 92071
(619) 448-9962
FAX (619) 448-5425
LICENSE NO. C16 602040

JOB NO.	96696
SCALE	1/8 = 1-0
DRAWN	T.M.
DATE	1/3/96
SHEET	2 OF 15

DRAWING FILE: SITE.DWG