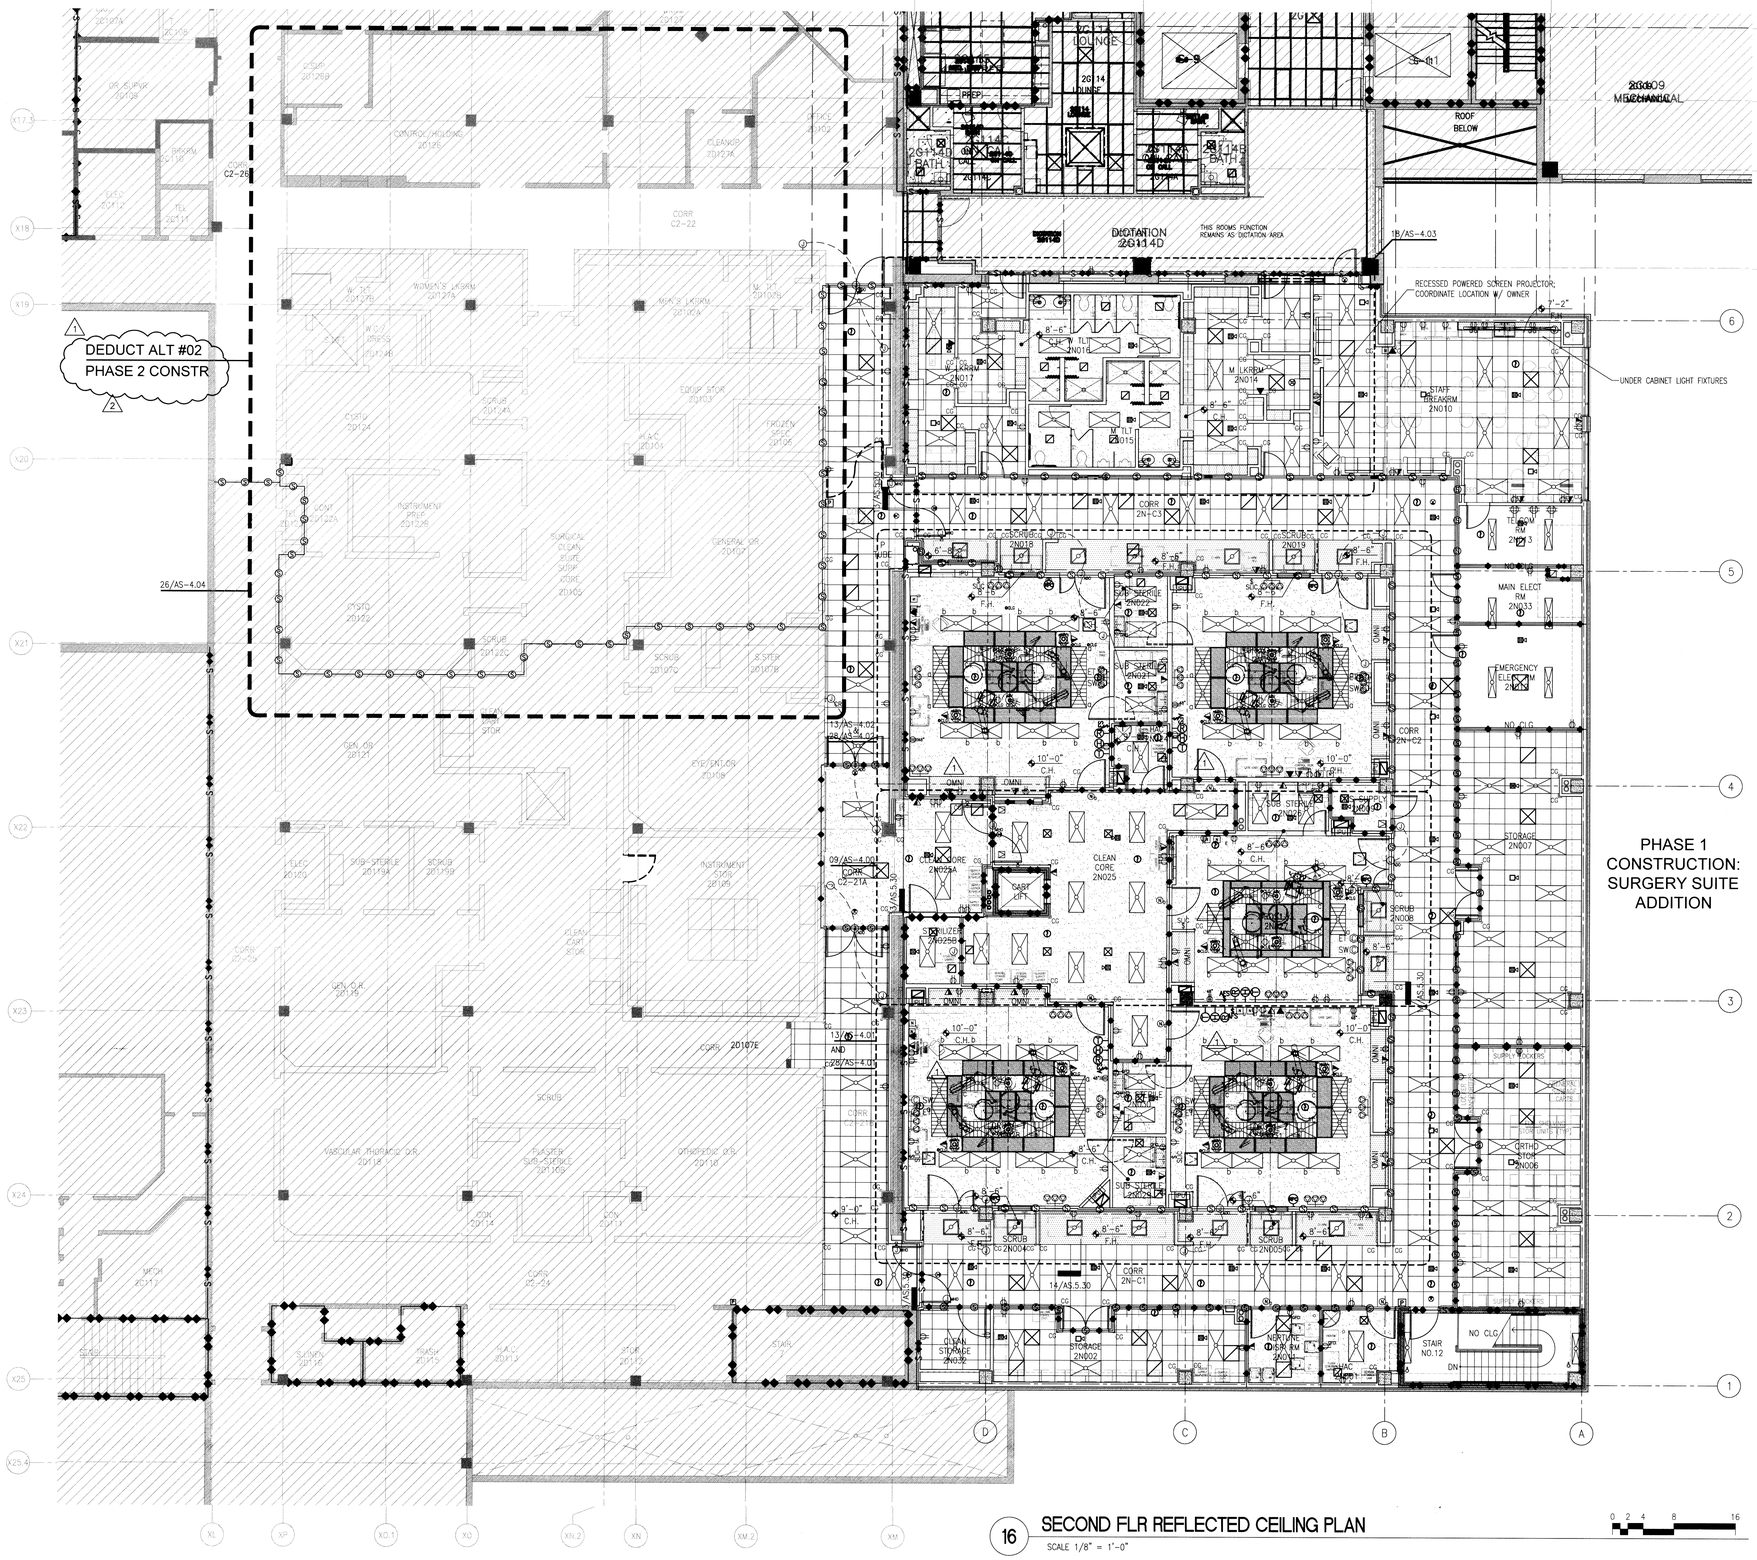
DEDUCT ALT #02
PHASE 2 CONSTR
DICTATION 2G114D
THIS ROOMS FUNCTION REMAINS AS DICTATION AREA
LOUNGE 2G14
2G114D BATH
2G114B BATH
MECHANICAL
ROOF BELOW
RECESSED POWERED SCREEN PROJECTOR; COORDINATE LOCATION W/ OWNER
UNDER CABINET LIGHT FIXTURES
STAFF BREAKRM 2N010
M. LKRM 2N014
W. LKRM 2N017
MAIN ELECT RM 2N033
EMERGENCY ELEC RM 2N007
STORAGE 2N007
CORR 2N-C2
CORR 2N-C3
CORR 2N-C1
CLEAN CORE 2N025
SOILED CORE 2N029A
STORAGE 2N002
CLEAN STORAGE 2N030
NURSING DSN INT 2N014
STAIR NO.12
NO CLG
SURG SUPPLIES
ORTHO TECH 2N006
26/AS-4.04
13/AS-4.02 AND 09/AS-4.04
14/AS.5.30
1B/AS-4.03
09/AS-4.04
13/AS-4.01 AND 09/AS-4.01
CORR C2-21A
CORR C2-26
CORR 20107E
CORR C2-22
CORR C2-24
CORR C2-27
CONTROL HOLDING 20126
INSTRUMENT PREP 20126
SURGICAL CLEAN SUPP STORE 20105
GENERAL OR 20107
SCRUB 20107A
