



ADDENDUM #1 (10/7/2015)

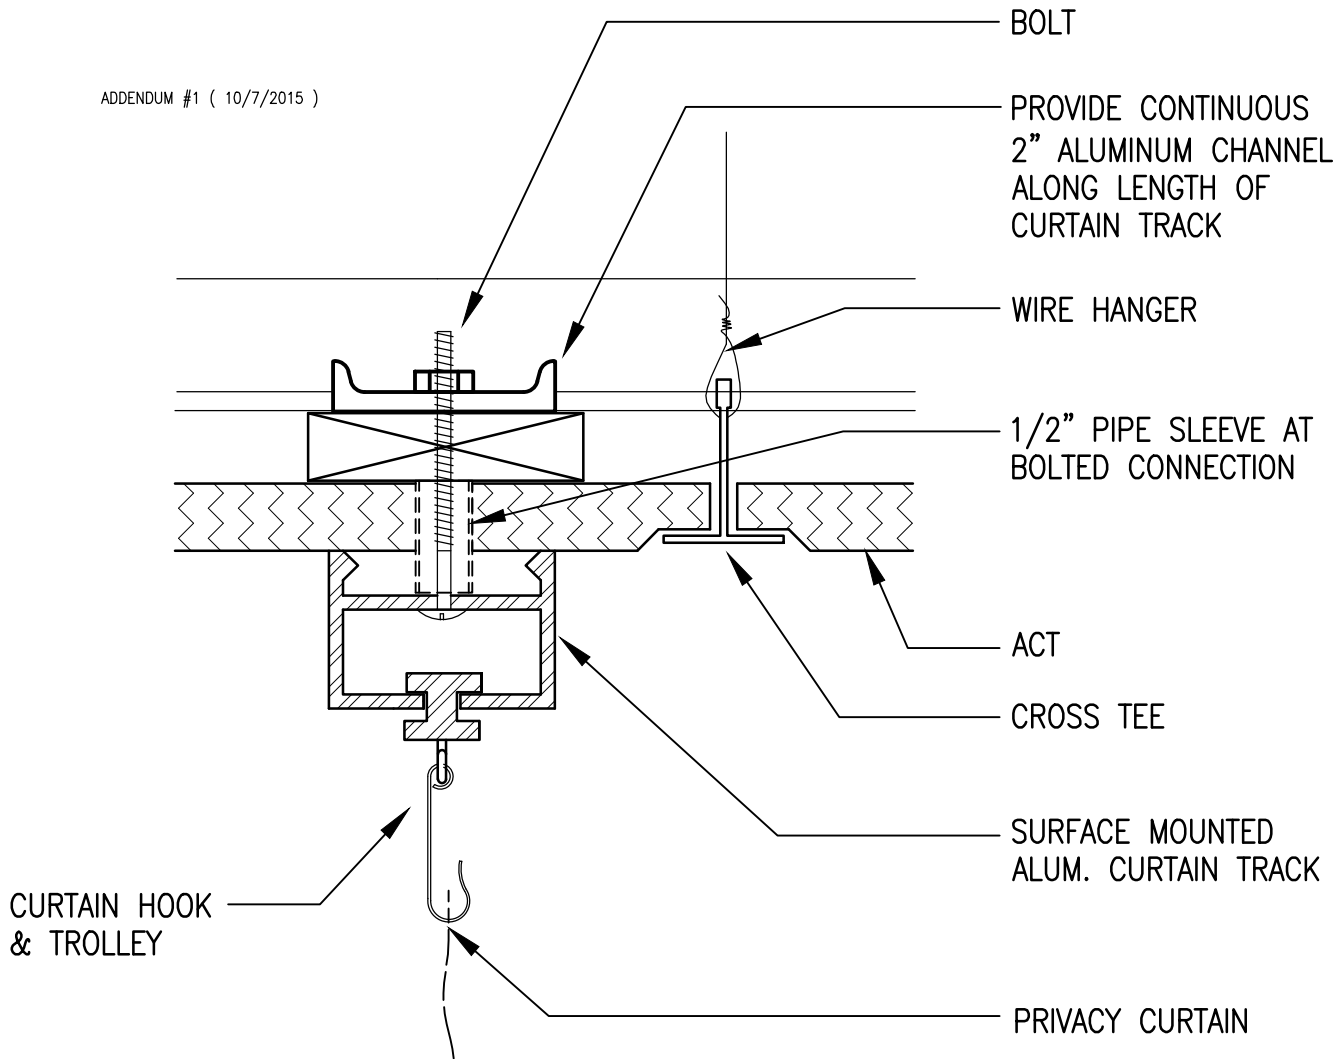

ACOUSTICAL CEILING CURTAIN TRACK DETAIL

3

6" = 1'-0"

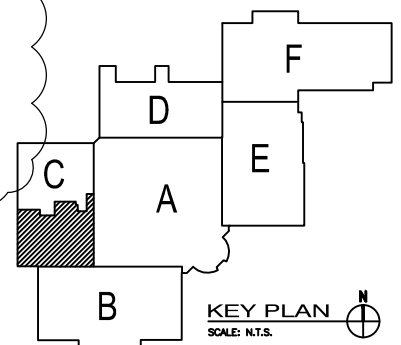

FINAL DESIGN SUBMITTAL
APPROVED FOR CONSTRUCTION

Project Title	Project Title	Project Number	Office of Construction and Facilities Management Department of Veterans Affairs
DETAILS	RENOVATE LABORATORY AND RADIOLOGY DEPARTMENTS	675-14-150	
Approved: Project Director	Location	Building Number	
	VIERA VA OUTPATIENT CLINIC	1	
	Attachment 7 - Sketch A500-add 1	Drawing Number	
	AUGUST 7, 2015	A500	
	THG		
	JG		