


DOOR MARK	ROOM TYPE	DOOR TYPE	DOOR SIZE	HDWR SET	DOOR MATERIA	FRAME TYPE	FRAME MATERIA	DETAIL HEAD	DETAIL JAMB	REMARKS
C111	STORAGE	A	S	4F	WD	1	HM	4	5	PHASE 1
C207	PATHOLOGY LAB	B	S	4G	WD	1	HM	4	5	PHASE 1
C109	RAD OFFICE	A	S	3E	WD	1	HM	4	5	PHASE 1
C209	BLOOD COLLECT	A	U	4G	WD	1	HM	4	5	PHASE 1
C113	MAMO READ	A	X	4G	WD	1	HM	4	5	PHASE 2
C115	BONE DENSITOMETER	A	X	4G	WD	1	HM	4	5	PHASE 2
C117	ULTRASOUND	A	X	4G	WD	1	HM	4	5	PHASE 2
C118	TOILET	A	S	2G	WD	1	HM	4	5	PHASE 2
C119	ULTRASOUND	A	X	4G	WD	1	HM	4	5	PHASE 2
C120	STRESS TEST	A	X	4G	WD	1	HM	4	5	PHASE 2
C102	QA PROCESS	A	S	3E	WD	1	HM	4	5	PHASE 3
C110	MAMMOGRAPHY									PHASE 4 Add floor door stop

ADDENDUM #1 (10/7/2015)

DOOR NOTES

1. ALL DOORS SHALL BE 1 3/4" FLUSH UNLESS NOTED OTHERWISE.
2. ALL GLAZING IN DOORS SHALL BE TEMPERED UNLESS NOTED OTHERWISE.
3. ALL METAL DOOR FRAMES ARE TO BE BACK PRIMED.
4. PROVIDE SEALANT AROUND ALL EXTERIOR DOOR FRAMES
5. PROVIDE 1 HOUR DOOR IN 1 HOUR STAIR PARTITIONS
6. PROVIDE 45 MIN. DOOR IN OTHER 1 HOUR PARTITIONS
7. PROVIDE 1 1/2 HOUR DOOR IN 2 HOUR PARTITIONS
8. PROVIDE HOSPITAL STOPS ON ALL HOLLOW METAL FRAMES EXCEPT SOUND-RATED, LEAD-LINED, FIRE-RATED, EXTERNAL & DOUBLE EGRESS DOORS

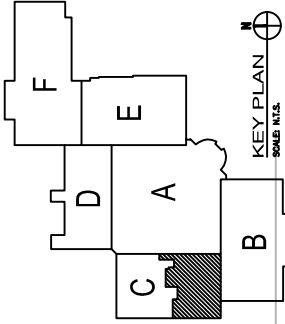

FINAL DESIGN SUBMITTAL
APPROVED FOR CONSTRUCTION

ARCHITECT/ENGINEERS:		DOOR AND FRAME ELEVATIONS		Project Title RENOVATE LABORATORY AND RADIOLOGY DEPARTMENTS		Project Number 675-14-150		Office of Construction and Facilities Management	
KEA INC. NW 98th Street, Suite B Tampa, FL 32606 Tel: (352) 474-6124 Fax: (352) 474-6324 FL #26693 Project No. 088-14		Approved: Project Director		Location VIERA VA OUTPATIENT CLINIC		Building Number 1		Department of Veterans Affairs	
				Date AUGUST 7, 2015		Drawing Number A502			
				Checked THG					
				Drawn JG					