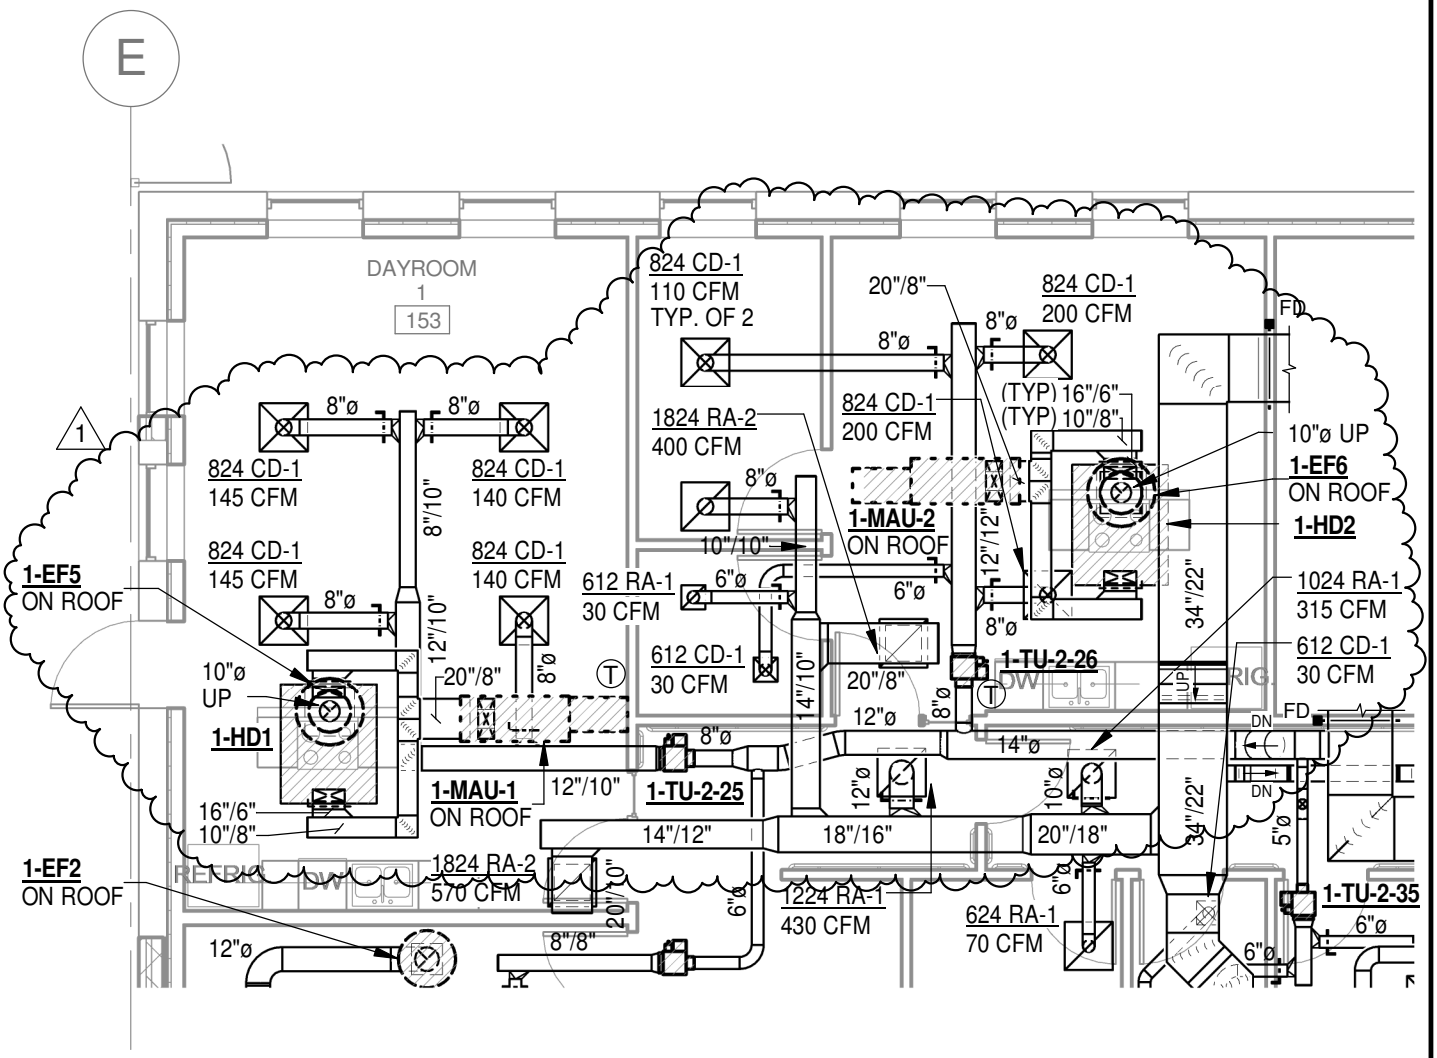

NORTH

1 MECHANICAL HVAC FLOOR PLAN

1/8" = 1'-0"

TAGGART ARCHITECTS

ADDENDUM

Renovate Leroy Pond Army Reserve Center for Mental Health Residential Rehabilitation Treatment/ Police Training

Owner

DATE
10/12/15

PROJECT NUMBER
564-341

ADD-M1