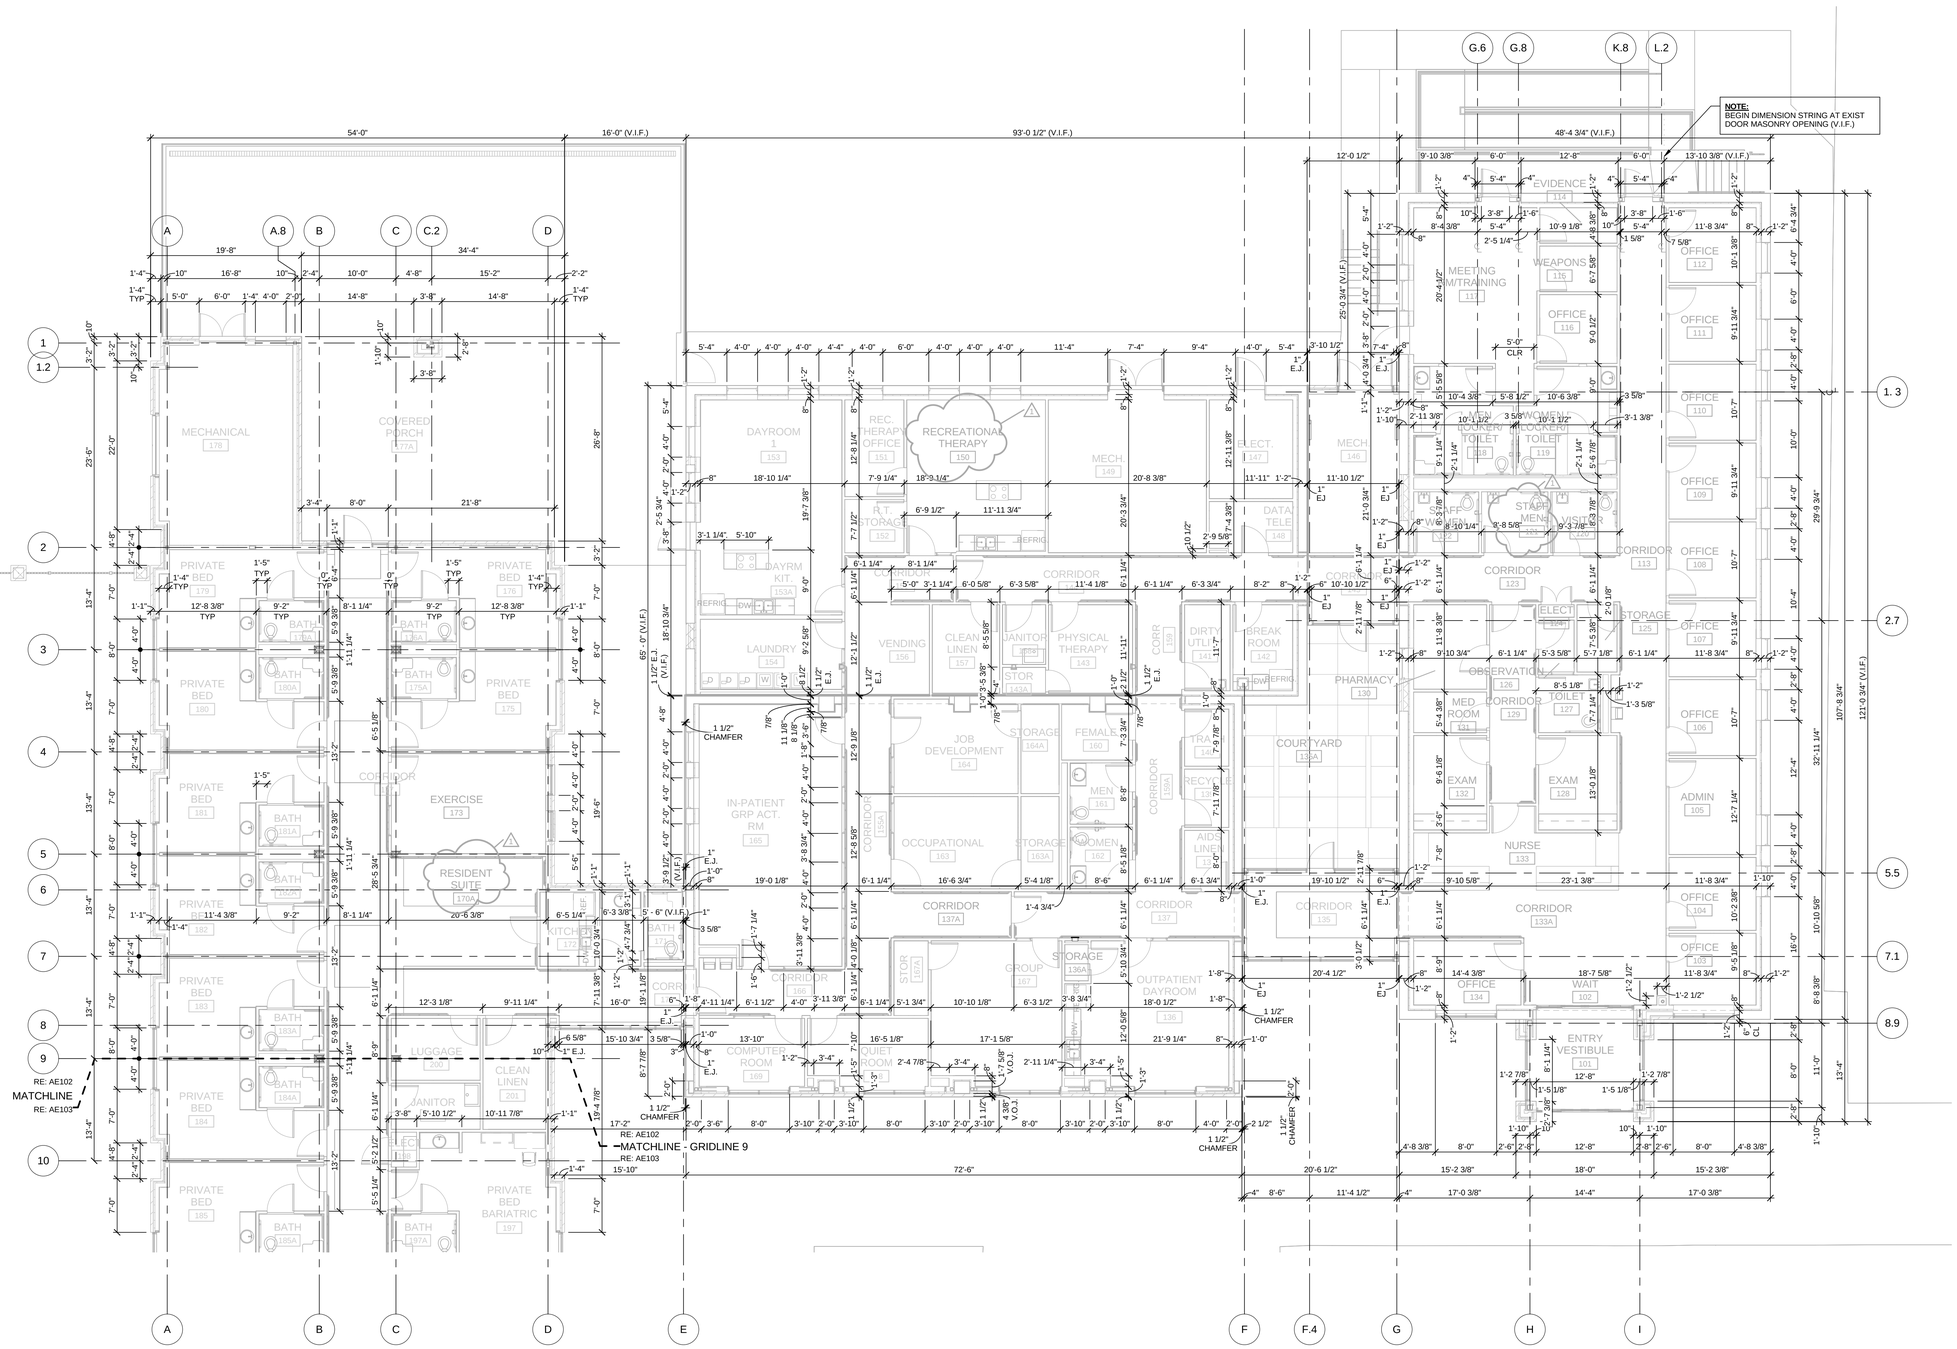

G2 DIMENSION PLAN - PARTIAL AREA "A, B & C"

1/8" = 1'-0"

FULLY SPRINKLERED

100% CONSTRUCTION DOCUMENTS

CONSULTANTS:	
09/07/2012	
ARCHITECT / ENGINEERS:	TAGGART ARCHITECTS, 4500 Burrow Drive, North Little Rock, AR 72116, Phone: 501-758-7443, Fax: 501-753-7309, www.taggarch.com
Drawing Title: DIMENSION PLAN - PARTIAL AREA A,B,C	Project Title: **Renovate Leroy Pond Army Reserve Center for Mental Health Residential Rehabilitation Treatment/ Police Training**
Project Number: **564-341**	Building Number
Approved: Project Director	Location: **Fayetteville, AR**
Drawing Number: AE105	Date: 9/7/12
Checked: Checker	Drawn: Author
Dwg. 51 of 126	**Office of Facilities Management**
DEPARTMENT OF VETERANS AFFAIRS	
Revisions: / Date	

VA FORM 08-6231, OCT 1978