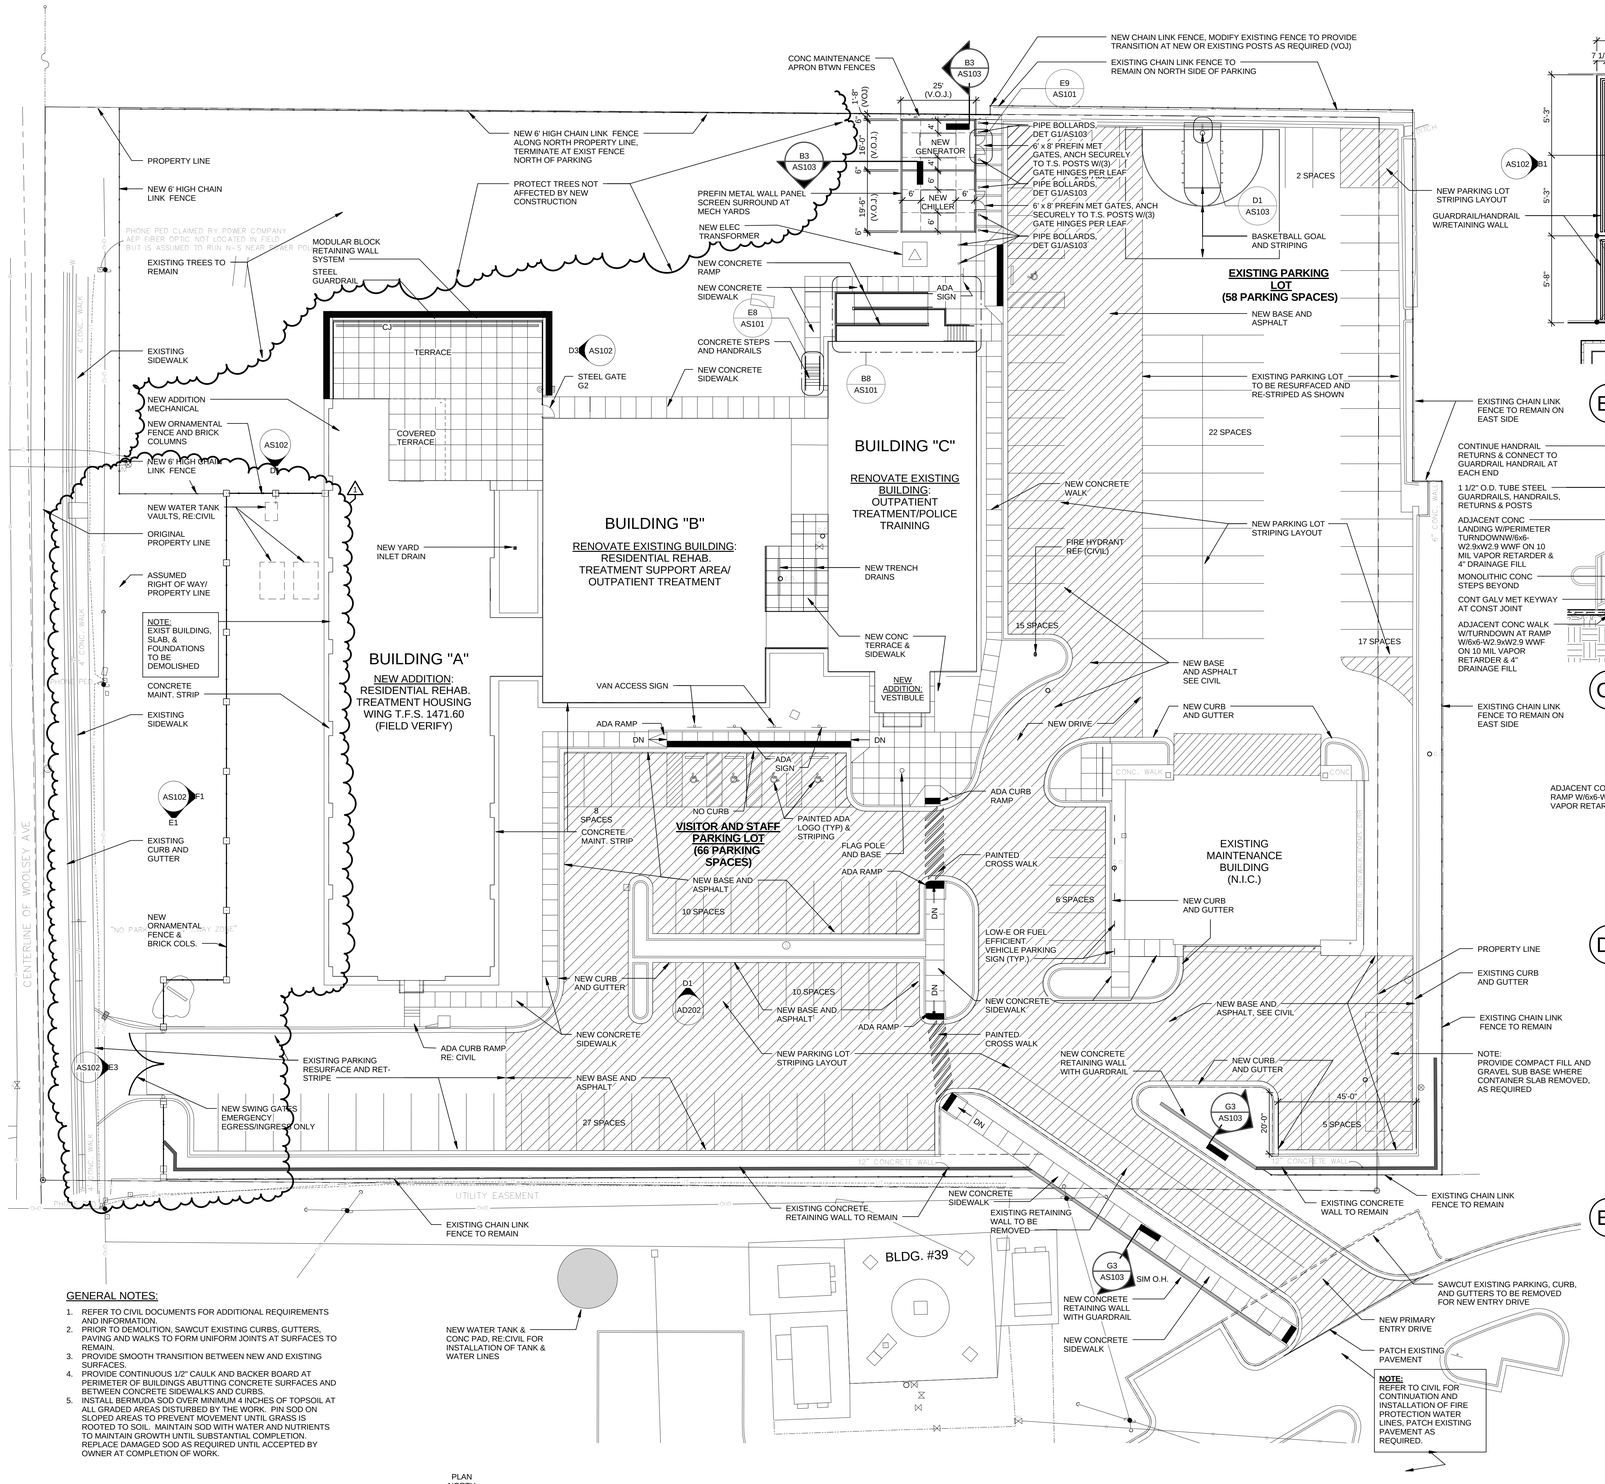

G1 ARCHITECTURAL SITE PLAN

1" = 20'-0"

PLAN NORTH

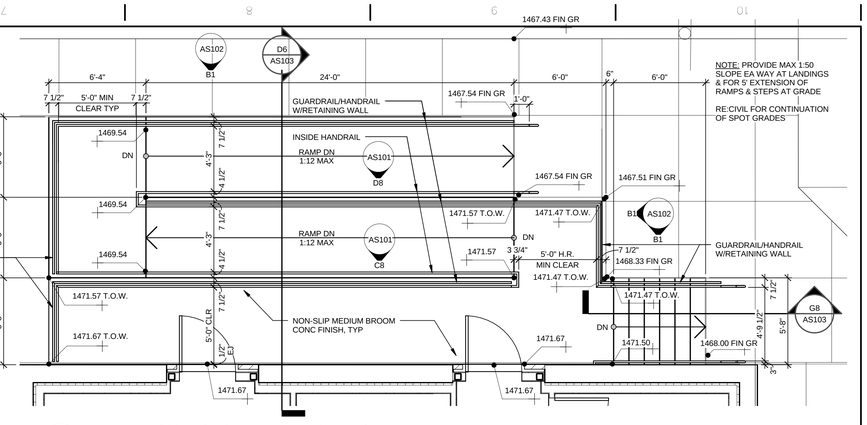

B8 ENLARGED PLAN AT RAMP

1/4" = 1'-0"

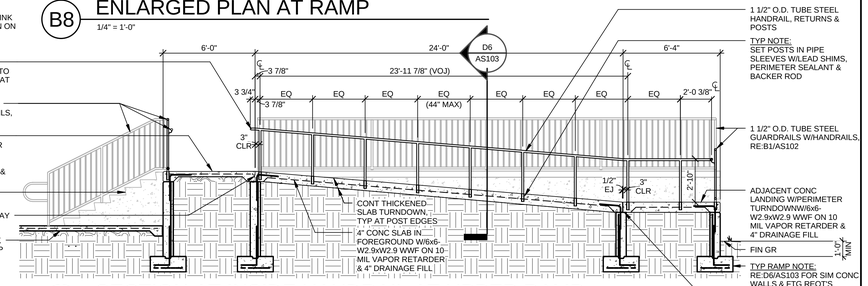

C8 SECTION AT INSIDE HANDRAIL AT UPPER RAMP

1/4" = 1'-0"

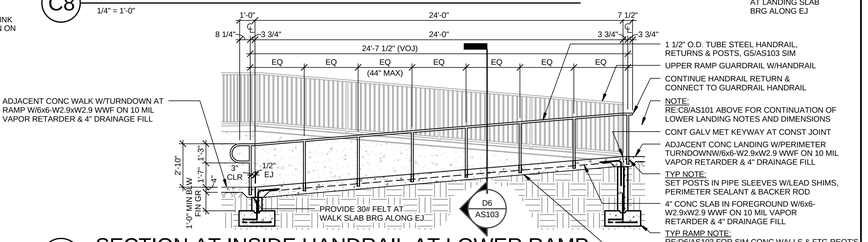

D8 SECTION AT INSIDE HANDRAIL AT LOWER RAMP

1/4" = 1'-0"

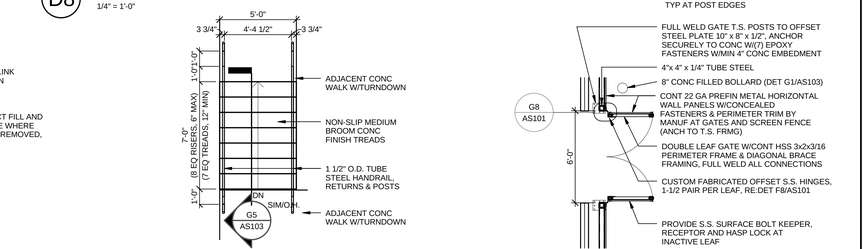

E8 ENLARGED PLAN AT SITE STEPS

1/4" = 1'-0"

G8 MECH YARD GATE JAMB DETAIL

3" = 1'-0"

E9 TYP MECH YARD GATES

1/4" = 1'-0"

FULLY SPRINKLERED

100% CONSTRUCTION DOCUMENTS

Revisions:	Date

CONSULTANTS:

09/07/2012

TAGGART ARCHITECTS REGISTERED ARCHITECTS License Number 0630 STATE OF TEXAS

ARCHITECT / ENGINEERS:

TAGGART ARCHITECTS

4500 Burrow Drive
North Little Rock, AR 72116
Phone: 501-758-7443
Fax: 501-753-7309
www.taggarch.com

Drawing Title: ARCHITECTURAL SITE PLAN

Approved: Project Director

Project Title: **Renovate Leroy Pond Army Reserve Center for Mental Health Residential Rehabilitation Treatment/ Police Training**

Location: **Fayetteville, AR**

Project Number: **564-341**

Building Number:

Drawing Number: AS101

Date: 9/7/12 | Checked: SG | Drawn: JB

Dwg. 43 of 126

Office of Facilities Management

DEPARTMENT OF VETERANS AFFAIRS

VA FORM 08-6231, OCT 1978