



(C7) SECURITY FENCE POST DETAIL
3/4" = 1'-0"

C9 SECURITY FENCE COLUMN SECTION

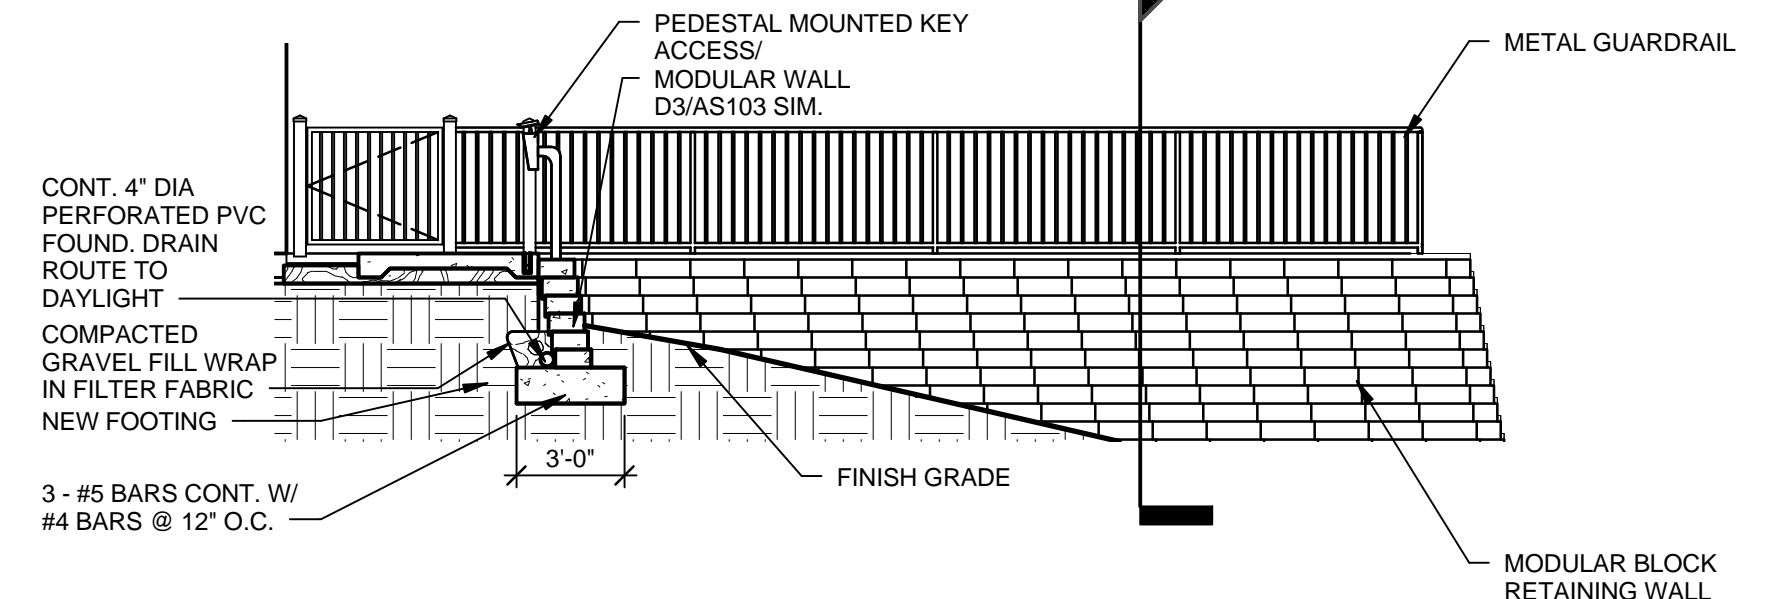


(D1) NORTH FENCE ELEVATION
3/16" = 1'-0"

D3 GATE ELEVATION
3/16" = 1'-0"

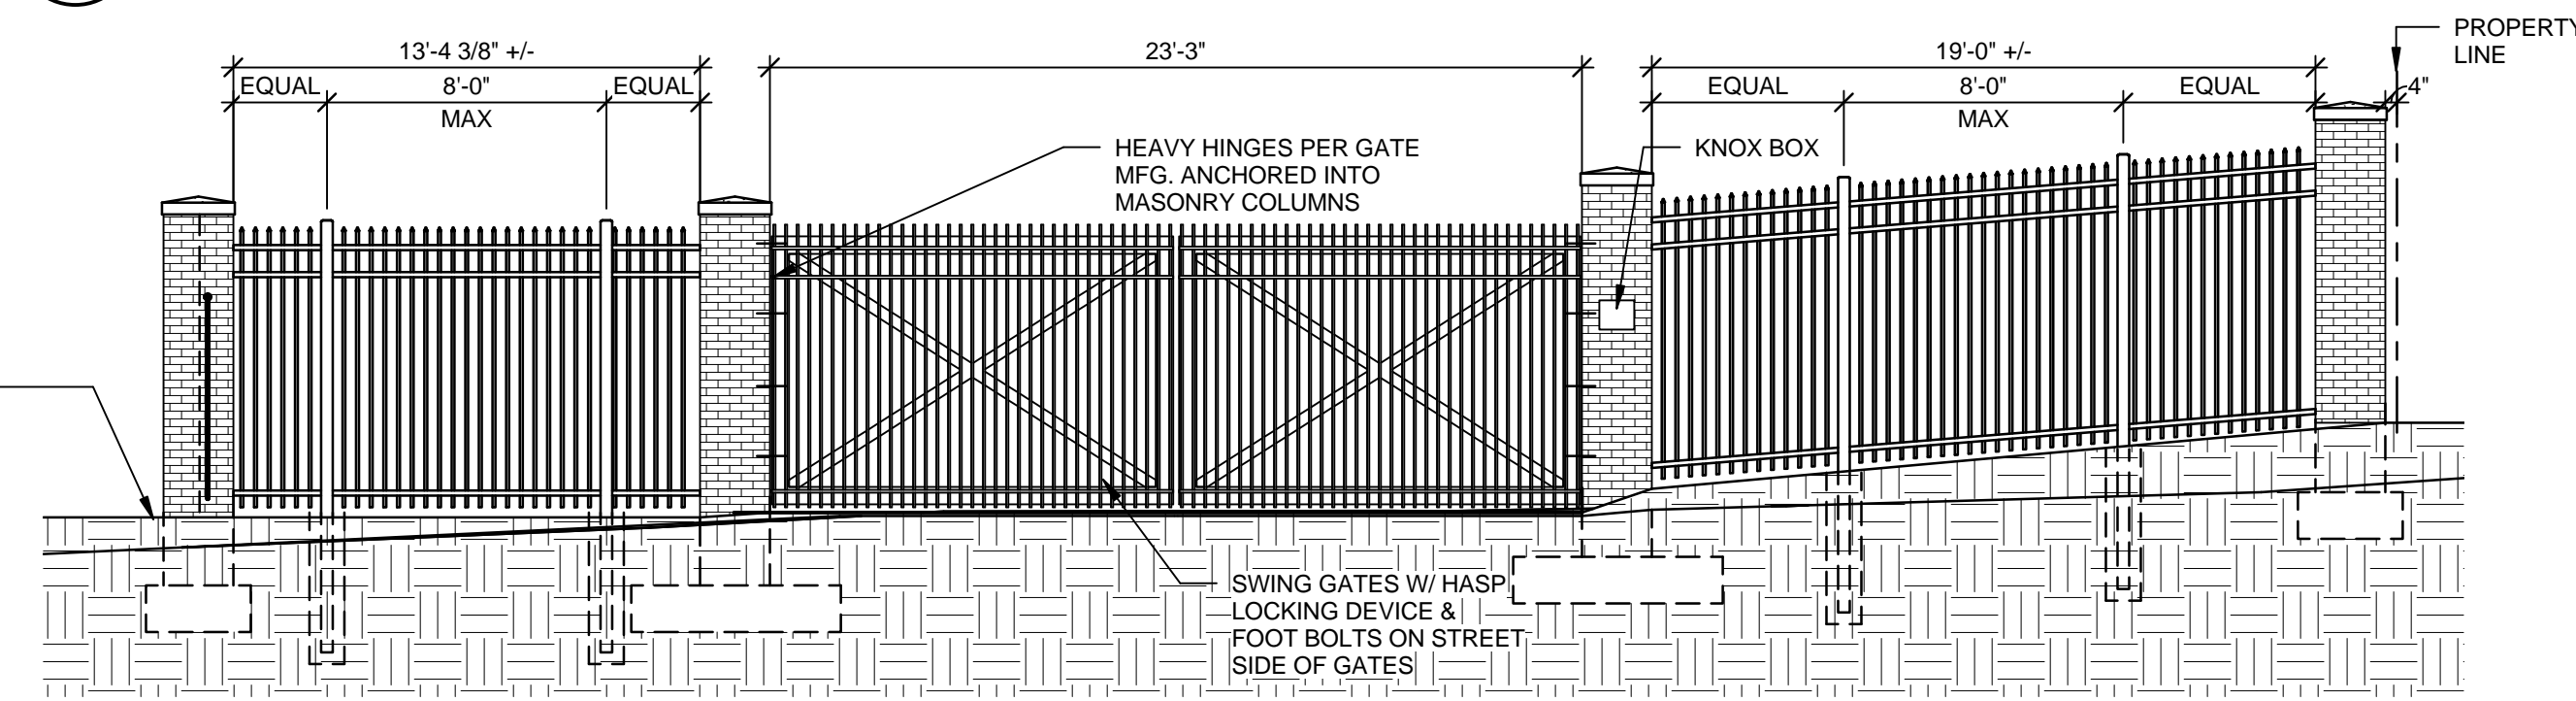


E1 NORTH FENCE ELEVATION
3/16" = 1'-0"

E3 WEST FENCE/GATE ELEVATION
3/16" = 1'-0"

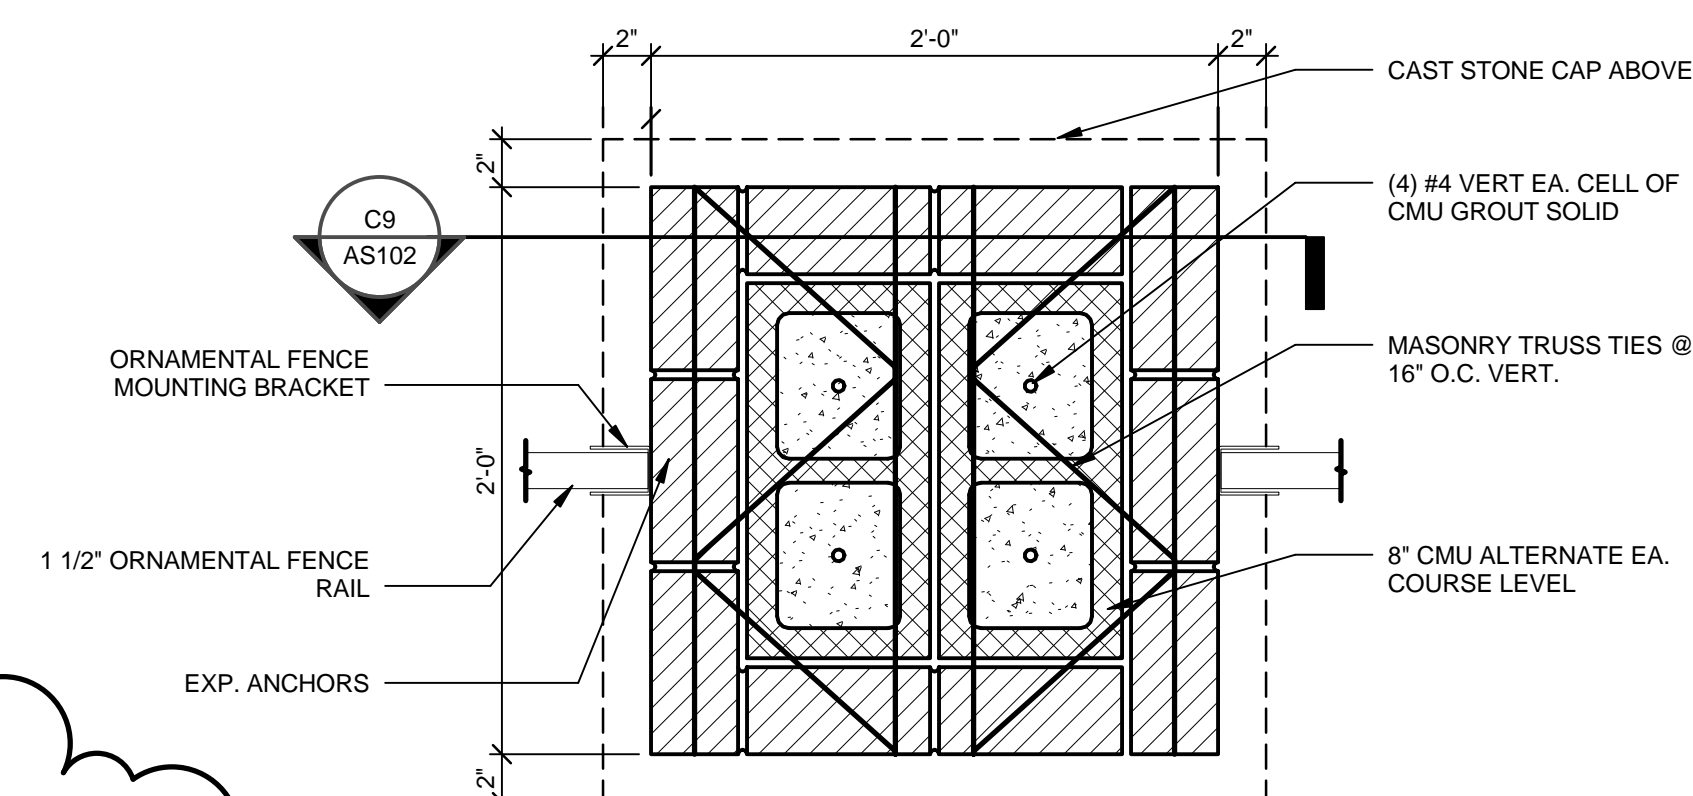

E9 SECURITY COLUMN SECTION
1 1/2" = 1'-0"

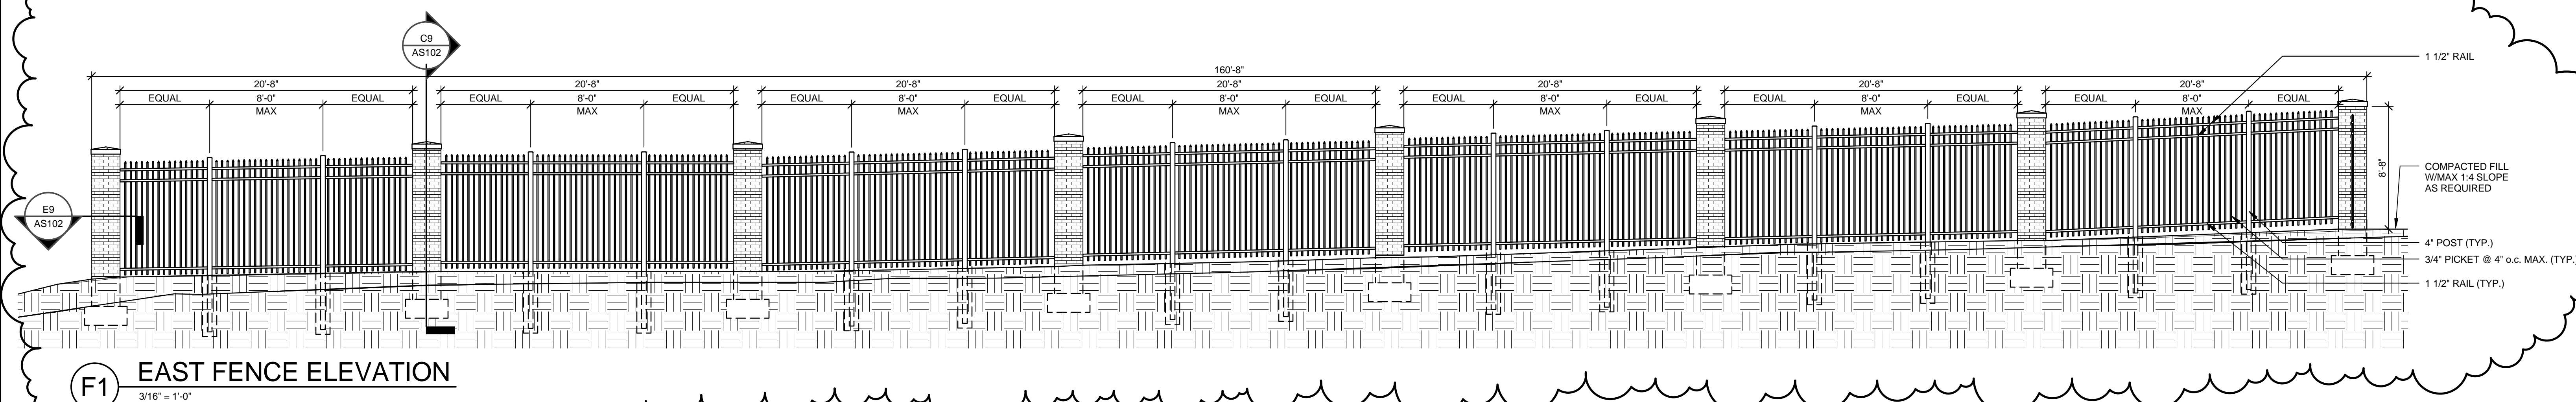

F1 EAST FENCE ELEVATION
3/16" = 1'-0"

[illegible]

DEPARTMENT OF
VETERANS AFFAIRS