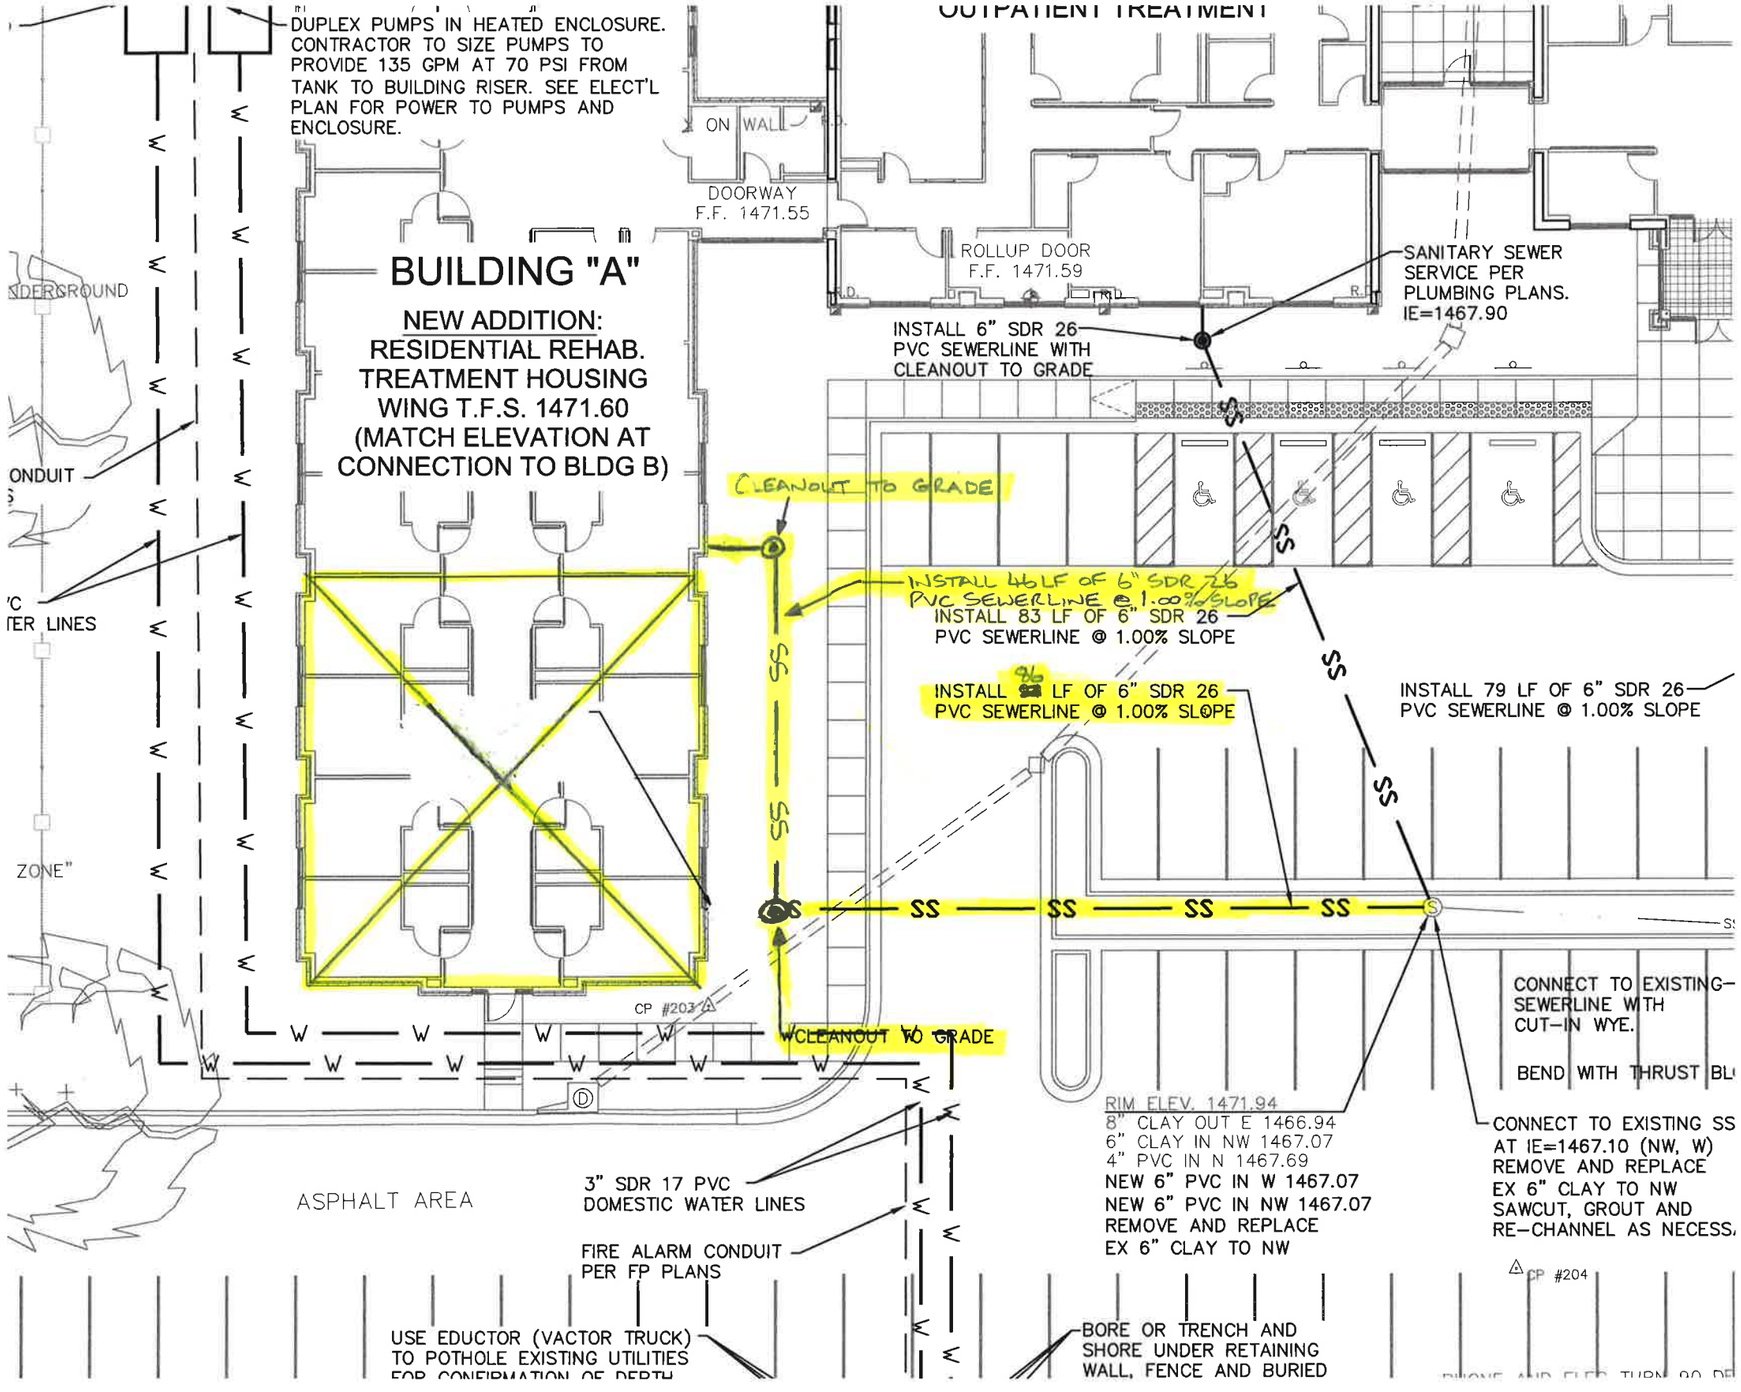
DUPLEX PUMPS IN HEATED ENCLOSURE. CONTRACTOR TO SIZE PUMPS TO PROVIDE 135 GPM AT 70 PSI FROM TANK TO BUILDING RISER. SEE ELECT'L PLAN FOR POWER TO PUMPS AND ENCLOSURE.
OUTPATIENT TREATMENT
DOORWAY F.F. 1471.55
ROLLUP DOOR F.F. 1471.59
BUILDING "A"
NEW ADDITION: RESIDENTIAL REHAB. TREATMENT HOUSING WING T.F.S. 1471.60 (MATCH ELEVATION AT CONNECTION TO BLDG B)
SANITARY SEWER SERVICE PER PLUMBING PLANS. IE=1467.90
INSTALL 6" SDR 26 PVC SEWERLINE WITH CLEANOUT TO GRADE
CLEANOUT TO GRADE
INSTALL 46 LF OF 6" SDR 26 PVC SEWERLINE @ 1.00% SLOPE
INSTALL 83 LF OF 6" SDR 26 PVC SEWERLINE @ 1.00% SLOPE
INSTALL 96 LF OF 6" SDR 26 PVC SEWERLINE @ 1.00% SLOPE
INSTALL 79 LF OF 6" SDR 26 PVC SEWERLINE @ 1.00% SLOPE
SS
W
CP #203
CLEANOUT TO GRADE
ASPHALT AREA
3" SDR 17 PVC DOMESTIC WATER LINES
FIRE ALARM CONDUIT PER FP PLANS
USE EDUCTOR (VACTOR TRUCK) TO POTHOLE EXISTING UTILITIES
BORE OR TRENCH AND SHORE UNDER RETAINING WALL, FENCE AND BURIED
RIM ELEV. 1471.94
8" CLAY OUT E 1466.94
6" CLAY IN NW 1467.07
4" PVC IN N 1467.69
NEW 6" PVC IN W 1467.07
NEW 6" PVC IN NW 1467.07
REMOVE AND REPLACE EX 6" CLAY TO NW
CONNECT TO EXISTING SEWERLINE WITH CUT-IN WYE.
BEND WITH THRUST BL
CONNECT TO EXISTING SS AT IE=1467.10 (NW, W)
REMOVE AND REPLACE EX 6" CLAY TO NW
SAWCUT, GROUT AND RE-CHANNEL AS NECESS.
CP #204
ONDUIT
TER LINES
ZONE"