
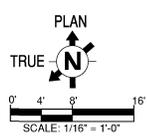


- GENERAL NOTES:**
1. CONDITIONS SHOWN ARE BASED ON EXISTING DRAWINGS AND LIMITED FIELD SURVEY. CONTRACTOR SHALL FIELD VERIFY EXISTING CONDITIONS PRIOR TO BEGINNING DEMOLITION. REPORT ANY AND ALL DISCREPANCIES TO THE COR.
  2. PROCEED WITH CARE AND CAUTION DURING DEMOLITION TO AVOID AND MINIMIZE DAMAGE TO EXISTING CONSTRUCTION, MATERIALS, SYSTEMS AND FINISHES TO REMAIN.
  3. REFER TO AE601 FOR WINDOW TYPES. CONTRACTOR SHALL FIELD VERIFY WINDOW OPENING SIZES AND CONDITIONS PRIOR TO COMMENCEMENT OF WORK.
  4. REMOVE ALL EXISTING SECURITY SCREENING EXCEPT AT BUILDING 7 UNLESS NOTED OTHERWISE (UNO).
  5. ALL EXISTING BASEMENT LEVEL LOUVERS TO REMAIN. CLEAN AND REPAIR TO MATCH EXISTING CAMPUS STANDARD COLOR. COORDINATE WITH COR.
  6. EXISTING WINDOWS TO REMAIN ARE NOT TAGGED AND REQUIRE NO WORK UNDER THIS CONTRACT.
  7. HALF-TONE OBJECTS, LABELS OR NOTES TYPICALLY REPRESENT EXISTING ITEMS TO REMAIN.
  8. VERIFY CONDITION OF EXISTING INTERIOR AND EXTERIOR HEAD, JAMB AND SILL AT EACH WINDOW LOCATION SCHEDULED FOR REPLACEMENT. PATCH, REPAIR OR REPLACE PERIMETER COMPONENTS AS REQUIRED BY CONDITION TO MATCH EXISTING ADJACENT MATERIALS AND FINISHES.
  9. ALL KEY NOTES MAY NOT BE APPLICABLE TO EVERY SHEET.


- DEMOLITION KEY NOTES:**
1. REMOVE EXISTING WINDOW AND OR INFILL MATERIAL.
  2. REMOVE EXISTING WINDOW AND SECURITY SCREEN. CLEAN AND REPLACE EXISTING SECURITY SCREEN AT THIS LOCATION.
- KEY NOTES:**
1. EXISTING WINDOW TO REMAIN. REPAIR, PATCH, PAINT AND SEAL EXISTING INTERIOR WINDOW TRIM TO GREATEST EXTENT POSSIBLE. COORDINATE TRIM REPLACEMENT WITH COR WHEN REPAIRS ARE NOT REASONABLE.
  2. PROVIDE OBSCURE GLASS AT THIS LOCATION.
  3. PROVIDE REPLACEMENT INFILL MATERIAL BELOW WINDOW TO MATCH THE INFILL MATERIAL AT LOCATIONS ABOVE.
  4. WINDOW INSTALLATION FROM INTERIOR AT THIS LOCATION. CLEAN AND REPAIR EXISTING EMBEDDED SECURITY BARS TO MATCH EXISTING CAMPUS STANDARD COLOR. COORDINATE WITH COR.

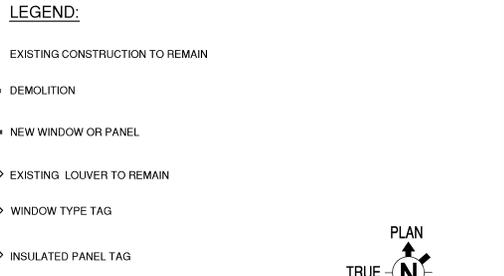

These two windows have AC units in them. Are these to be removed and not reinstalled?

this window has a Fan in it, is the fan to be removed and not reinstalled?

These two windows have a fan and duct work in them. Are these items to be removed and no reinstalled?

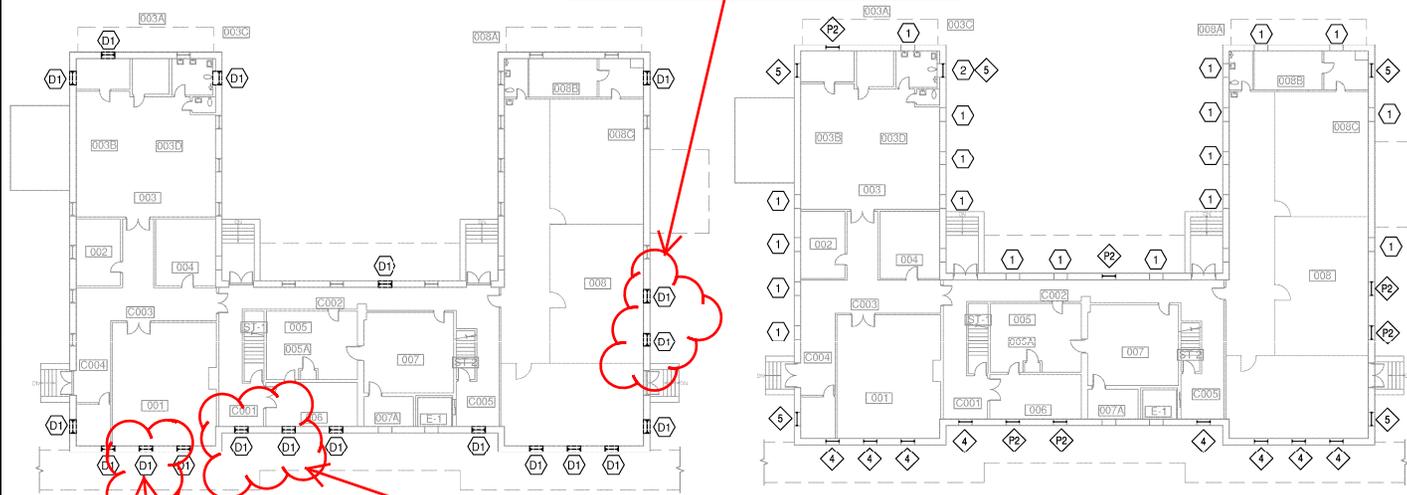

WINDOW DEMOLITION BUILDING 4 - WINDOW REPLACEMENT PLAN SCALE: 1/16" = 1'-0"

CONSULTANTS:	ARCHITECT/ENGINEERS:	Drawing Title B4 - WINDOW DEMOLITION / REPLACEMENT PLANS	Project Title ENERGY AUDIT CORRECTIONS PHASE I	Project Number 666-15-10	Office of Construction
--------------	----------------------	---	---	-----------------------------	------------------------