2. PROCEED WITH CARE AND CAUTION DURING DEMOLITION TO AVOID AND MINIMIZE DAMAGE TO EXISTING CONSTRUCTION, MATERIALS, SYSTEMS AND FINISHES TO REMAIN.

3. REFER TO AE601 FOR WINDOW TYPES. CONTRACTOR SHALL FIELD VERIFY WINDOW OPENING SIZES AND CONDITIONS PRIOR TO COMMENCEMENT OF WORK.

4. REMOVE ALL EXISTING SECURITY SCREENING EXCEPT AT BUILDING 7 UNLESS NOTED OTHERWISE (UNO).

5. ALL EXISTING BASEMENT LEVEL LOUVERS TO REMAIN. CLEAN AND REPAINT TO MATCH EXISTING CAMPUS STANDARD COLOR, COORDINATE WITH COR.

6. EXISTING WINDOWS TO REMAIN ARE NOT TAGGED AND REQUIRE NO WORK UNDER THIS CONTRACT.

7. HALF-TONE OBJECTS, LABELS OR NOTES TYPICALLY REPRESENT EXISTING ITEMS TO REMAIN.

8. VERIFY CONDITION OF EXISTING INTERIOR AND EXTERIOR HEAD, JAMB AND SILL AT EACH WINDOW LOCATION SCHEDULED FOR REPLACEMENT. PATCH, REPAIR OR REPLACE PERIMETER COMPONENTS AS REQUIRED BY CONDITION TO MATCH EXISTING ADJACENT MATERIALS AND FINISHES.

9. ALL KEY NOTES MAY NOT BE APPLICABLE TO EVERY SHEET.

D# DEMOLITION KEY NOTES:

1. REMOVE EXISTING WINDOW AND OR INFILL MATERIAL.

2. REMOVE EXISTING WINDOW AND SECURITY SCREEN. CLEAN AND REPLACE EXISTING SECURITY SCREEN AT THIS LOCATION.

KEY NOTES:

1. EXISTING WINDOW TO REMAIN. REPAIR, PATCH, PAINT AND SEAL EXISTING INTERIOR WINDOW TRIM TO GREATEST EXTENT POSSIBLE. COORDINATE TRIM REPLACEMENT WITH COR WHEN REPAIRS ARE NOT REASONABLE.

2. PROVIDE OBSCURE GLASS AT THIS LOCATION.

3. PROVIDE REPLACEMENT INFILL MATERIAL BELOW WINDOW TO MATCH THE INFILL MATERIAL AT LOCATIONS ABOVE.

4. WINDOW INSTALLATION FROM INTERIOR AT THIS LOCATION. CLEAN AND REPAINT EXISTING EMBEDDED SECURITY BARS TO MATCH EXISTING CAMPUS STANDARD COLOR, COORDINATE WITH COR.

LEGEND:

- EXISTING CONSTRUCTION TO REMAIN
- DEMOLITION
- NEW WINDOW OR PANEL
- EL — EXISTING LOUVER TO REMAIN
- # — WINDOW TYPE TAG
- P# — INSULATED PANEL TAG

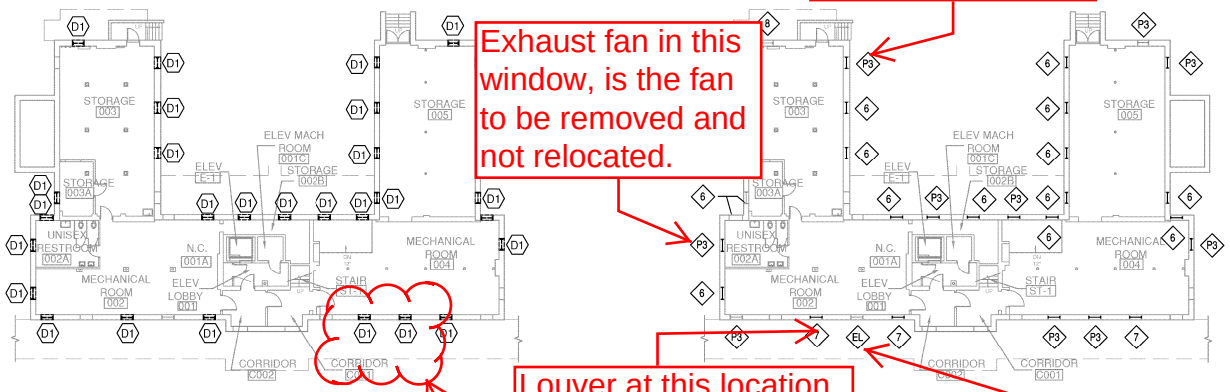

1 AE104 BUILDING 6 - WINDOW DEMOLITION PLAN
SCALE: 1/8" = 1'-0"

2 E104 BUILDING 6 - WINDOW REPLACEMENT PLAN
SCALE: 1/16" = 1'-0"

Exhaust fan in this window, is the fan to be removed and not relocated.

Exhaust fan in this window, is the fan to be removed and not relocated.

Louver at this location

These 2 windows have fans and ducts in them. Are the fans and ducts to be removed and not replaced.

No louver at this location.

PLAN TRUE N

0' 4' 8' 16'
SCALE: 1/16" = 1'-0"

BID DOCUMENTS

CONSULTANTS:	ARCHITECT/ENGINEERS:	
	AES Group, Inc.	

Drawing Title	B6 - WINDOW DEMOLITION / REPLACEMENT PLANS
Project Title	ENERGY AUDIT CORRECTIONS PHASE I
Project Number	666-15-110
Building Number	6
Drawing Number	AE104 Dwg. 6 of 17
Approved Project Director	DOUGLAS Q LOFGREN, SUPERVISORY STAFF ENGINEER/ENERGY MANAGER PLANT OPERATIONS, MAINT + REPAIR FMS OFFICE: 307-675-3671 EMAIL: DOUGLAS.LOFGREN@VA.GOV
Location	FT. MCKENZIE, SHERIDAN, WY
Date	JANUARY 2015
Checked	RJO
Drawn	LED

Office of Construction and Facilities Management

Department of Veterans Affairs

Revisions	Date

VA FORM 08-6231