


one and one half inch = one foot
one inch = one foot
three quarters inch = one foot
one half inch = one foot
three eighths inch = one foot
one quarter inch = one foot
one eighth inch = one foot

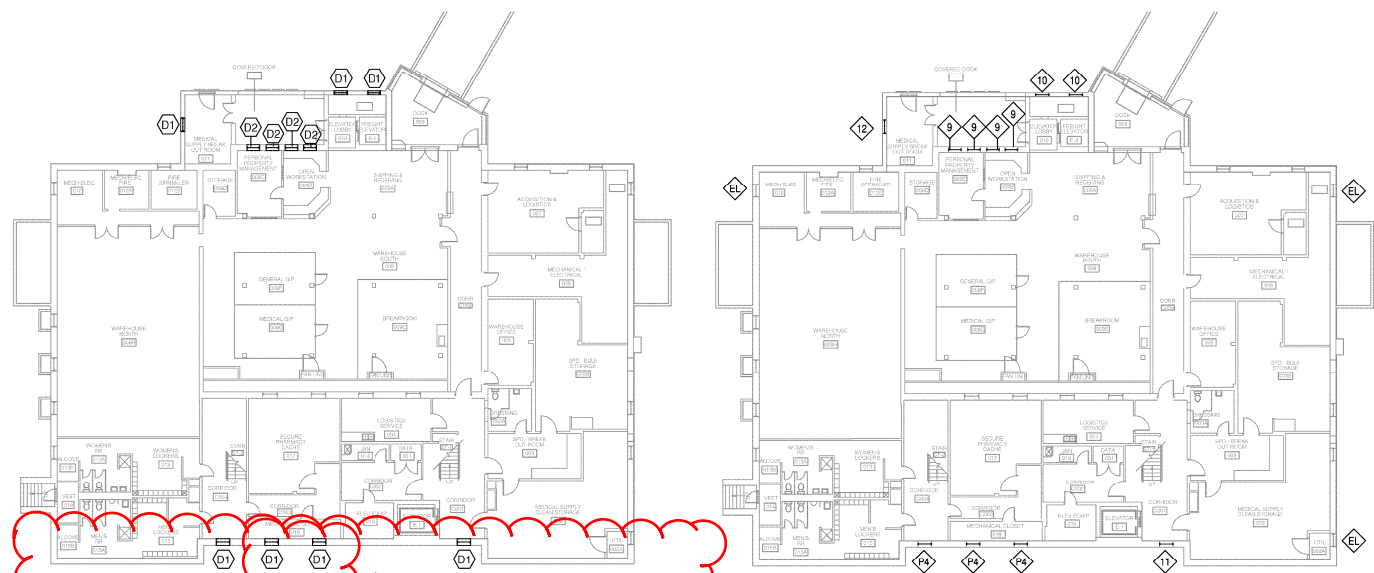

These 2 windows have duct work and fans. Are we to remove the duct work and fans and not re-install them?

Please note that the tramway is not shown on these drawings. the windows on this side of the building are located inside the tramway and are not seen from the exterior of the building.

2. PROCEED WITH CARE AND CAUTION DURING DEMOLITION TO AVOID AND MINIMIZE DAMAGE TO EXISTING CONSTRUCTION, MATERIALS, SYSTEMS AND FINISHES TO REMAIN.
3. REFER TO AE601 FOR WINDOW TYPES. CONTRACTOR SHALL FIELD VERIFY WINDOW OPENING SIZES AND CONDITIONS PRIOR TO COMMENCEMENT OF WORK.
4. REMOVE ALL EXISTING SECURITY SCREENING EXCEPT AT BUILDING 7 UNLESS NOTED OTHERWISE (UNO).
5. ALL EXISTING BASEMENT LEVEL LOUVERS TO REMAIN. CLEAN AND REPAINT TO MATCH EXISTING CAMPUS STANDARD COLOR, COORDINATE WITH COR.
6. EXISTING WINDOWS TO REMAIN ARE NOT TAGGED AND REQUIRE NO WORK UNDER THIS CONTRACT.
7. HALF-TONE OBJECTS, LABELS OR NOTES TYPICALLY REPRESENT EXISTING ITEMS TO REMAIN.
8. VERIFY CONDITION OF EXISTING INTERIOR AND EXTERIOR HEAD, JAMB AND SILL AT EACH WINDOW LOCATION SCHEDULED FOR REPLACEMENT. PATCH, REPAIR OR REPLACE PERIMETER COMPONENTS AS REQUIRED BY CONDITION TO MATCH EXISTING ADJACENT MATERIALS AND FINISHES.
9. ALL KEY NOTES MAY NOT BE APPLICABLE TO EVERY SHEET.

DEMOLITION KEY NOTES:


1. REMOVE EXISTING WINDOW AND OR INFILL MATERIAL.
2. REMOVE EXISTING WINDOW AND SECURITY SCREEN. CLEAN AND REPLACE EXISTING SECURITY SCREEN AT THIS LOCATION.

KEY NOTES:



1. EXISTING WINDOW TO REMAIN. REPAIR, PATCH, PAINT AND SEAL EXISTING INTERIOR WINDOW TRIM TO GREATEST EXTENT POSSIBLE. COORDINATE TRIM REPLACEMENT WITH COR WHEN REPAIRS ARE NOT REASONABLE.
2. PROVIDE OBSCURE GLASS AT THIS LOCATION.
3. PROVIDE REPLACEMENT INFILL MATERIAL BELOW WINDOW TO MATCH THE INFILL MATERIAL AT LOCATIONS ABOVE.
4. WINDOW INSTALLATION FROM INTERIOR AT THIS LOCATION. CLEAN AND REPAINT EXISTING EMBEDDED SECURITY BARS TO MATCH EXISTING CAMPUS STANDARD COLOR. COORDINATE WITH COR.

LEGEND:

- EXISTING CONSTRUCTION TO REMAIN
- DEMOLITION
- NEW WINDOW OR PANEL
- EXISTING LOUVER TO REMAIN
- WINDOW TYPE TAG
- INSULATED PANEL TAG

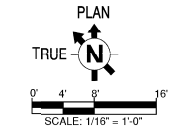

BID DOCUMENTS

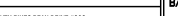		CONSULTANTS:				ARCHITECT/ENGINEERS:		Drawing Title B7 - WINDOW DEMOLITION / REPLACEMENT PLANS		Project Title ENERGY AUDIT CORRECTIONS PHASE I		Project Number 666-15-10 Building Number 7		Office of Construction and Facilities Management	
						 10051 60th Street, Suite 100, 4302 Parker, Colorado 80138 Ph: 303.643.2922 www.aes-grp.com		Approved Project Director DOUGLAS G. LOFFREN, SUPERVISORY STAFF ENGINEER/ENERGY MANAGER PLANT OPERATIONS, MAINT + REPAIR P&M OFFICE: 307-475-2671 EMAIL: DOUGLASLOFFREN@VA.GOV		Location FT. MCKENZIE, SHERIDAN, WY		Drawing Number AE105			
Revision		Date						Date JANUARY 2015		Checked RJO		Drawn LED			