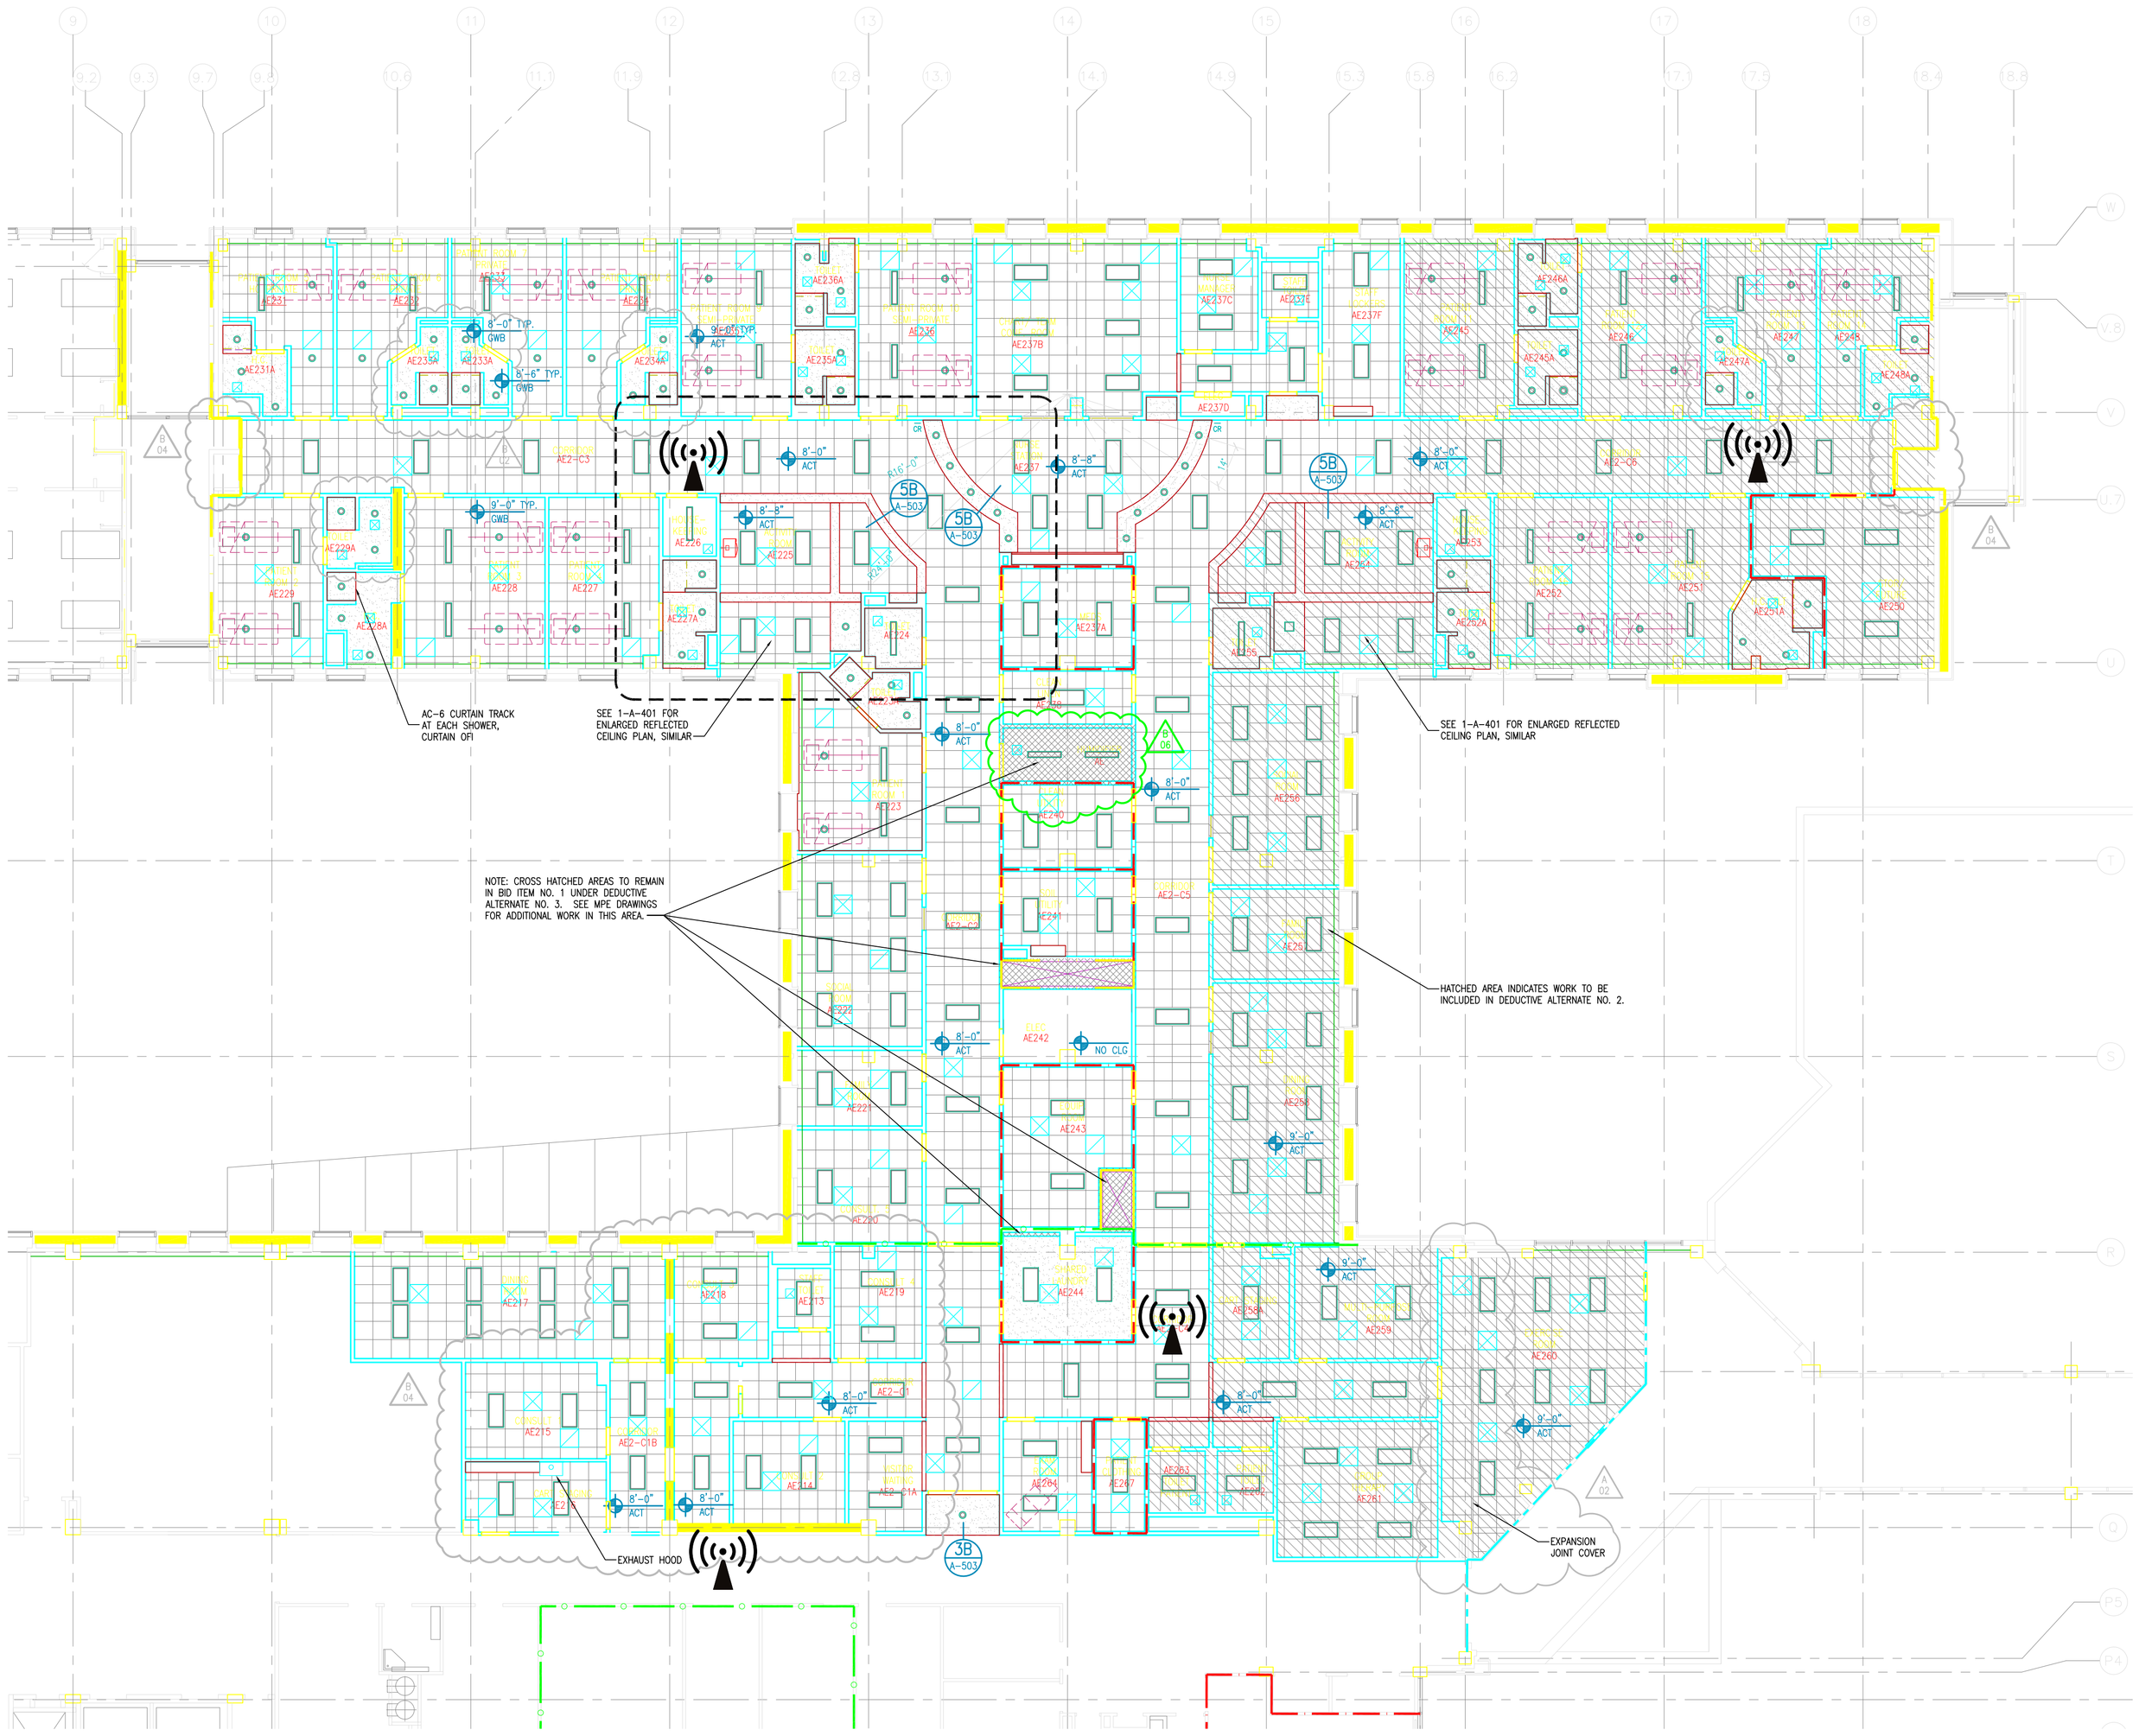

1F SECOND FLOOR REFLECTED CEILING PLAN
SCALE: 1/8" = 1'-0"

GENERAL NOTES:

1. ALL CEILING HEIGHTS SHALL BE 9'-0" UNLESS OTHERWISE NOTED.
2. ALL SOFFIT HEIGHTS SHALL BE 7'-2" UNLESS OTHERWISE NOTED.
3. COORDINATE ALL ABOVE CEILING WORK PRIOR TO START OF CONSTRUCTION AND FABRICATION OF COMPONENTS.
4. SEE FIRE PROTECTION DRAWINGS FOR SPRINKLER DESIGN CRITERIA.

REFLECTED CEILING LEGEND:

- 2'x4' FLUORESCENT LIGHT FIXTURE
- 1'x4' FLUORESCENT LIGHT FIXTURE
- DOWN LIGHT
- UNDER COUNTER LIGHT FIXTURE
- EXIT SIGN
- HEIGHT / MATL. — CEILING HEIGHT SYMBOL
- 2'X2' ACOUSTIC TILE
- GYPSUM WALLBOARD CEILING OR SOFFIT
- MECHANICAL CEILING DIFFUSER
- MECHANICAL CEILING RETURN
- MECHANICAL CEILING EXHAUST
- ACCESS PANEL 18" x 18" UNLESS OTHERWISE NOTED, COORDINATE SWING WITH DIFFUSER OPERATION

FULLY SPRINKLERED

Revisions	Date
BULLETIN NO. 4	11-06-08
BULLETIN NO. 2 – TOILET ROOM REVISIONS	10-10-08

CONSULTANTS:

ARCHITECT/ENGINEERS:

TRO Jung | Brannen
ARCHITECTURE | INTERIOR DESIGN | ENGINEERING | MASTER PLANNING
119 South Main Street, Suite 200, Memphis, TN 38103
Tel 901.260.9600 Fax 901.521.1337 www.trojungbrannen.com

Drawing Title: SECOND FLOOR REFLECTED CEILING PLAN - 1/8"= 1'-0"

Approved Project Director

Project Title: INPATIENT MENTAL HEALTH RENOVATION

Location: VAMC, Memphis, Tennessee

Date: December 31, 2007 | Checked | Drawn

Project Number: 614-309

Building Number: 1

Drawing Number: 1-AC102

Dwg. 10 of 23

KEY PLAN: AW AE | F G | D H | BW BE | CW CE | N

VA FORM 08-6231, OCT 1978