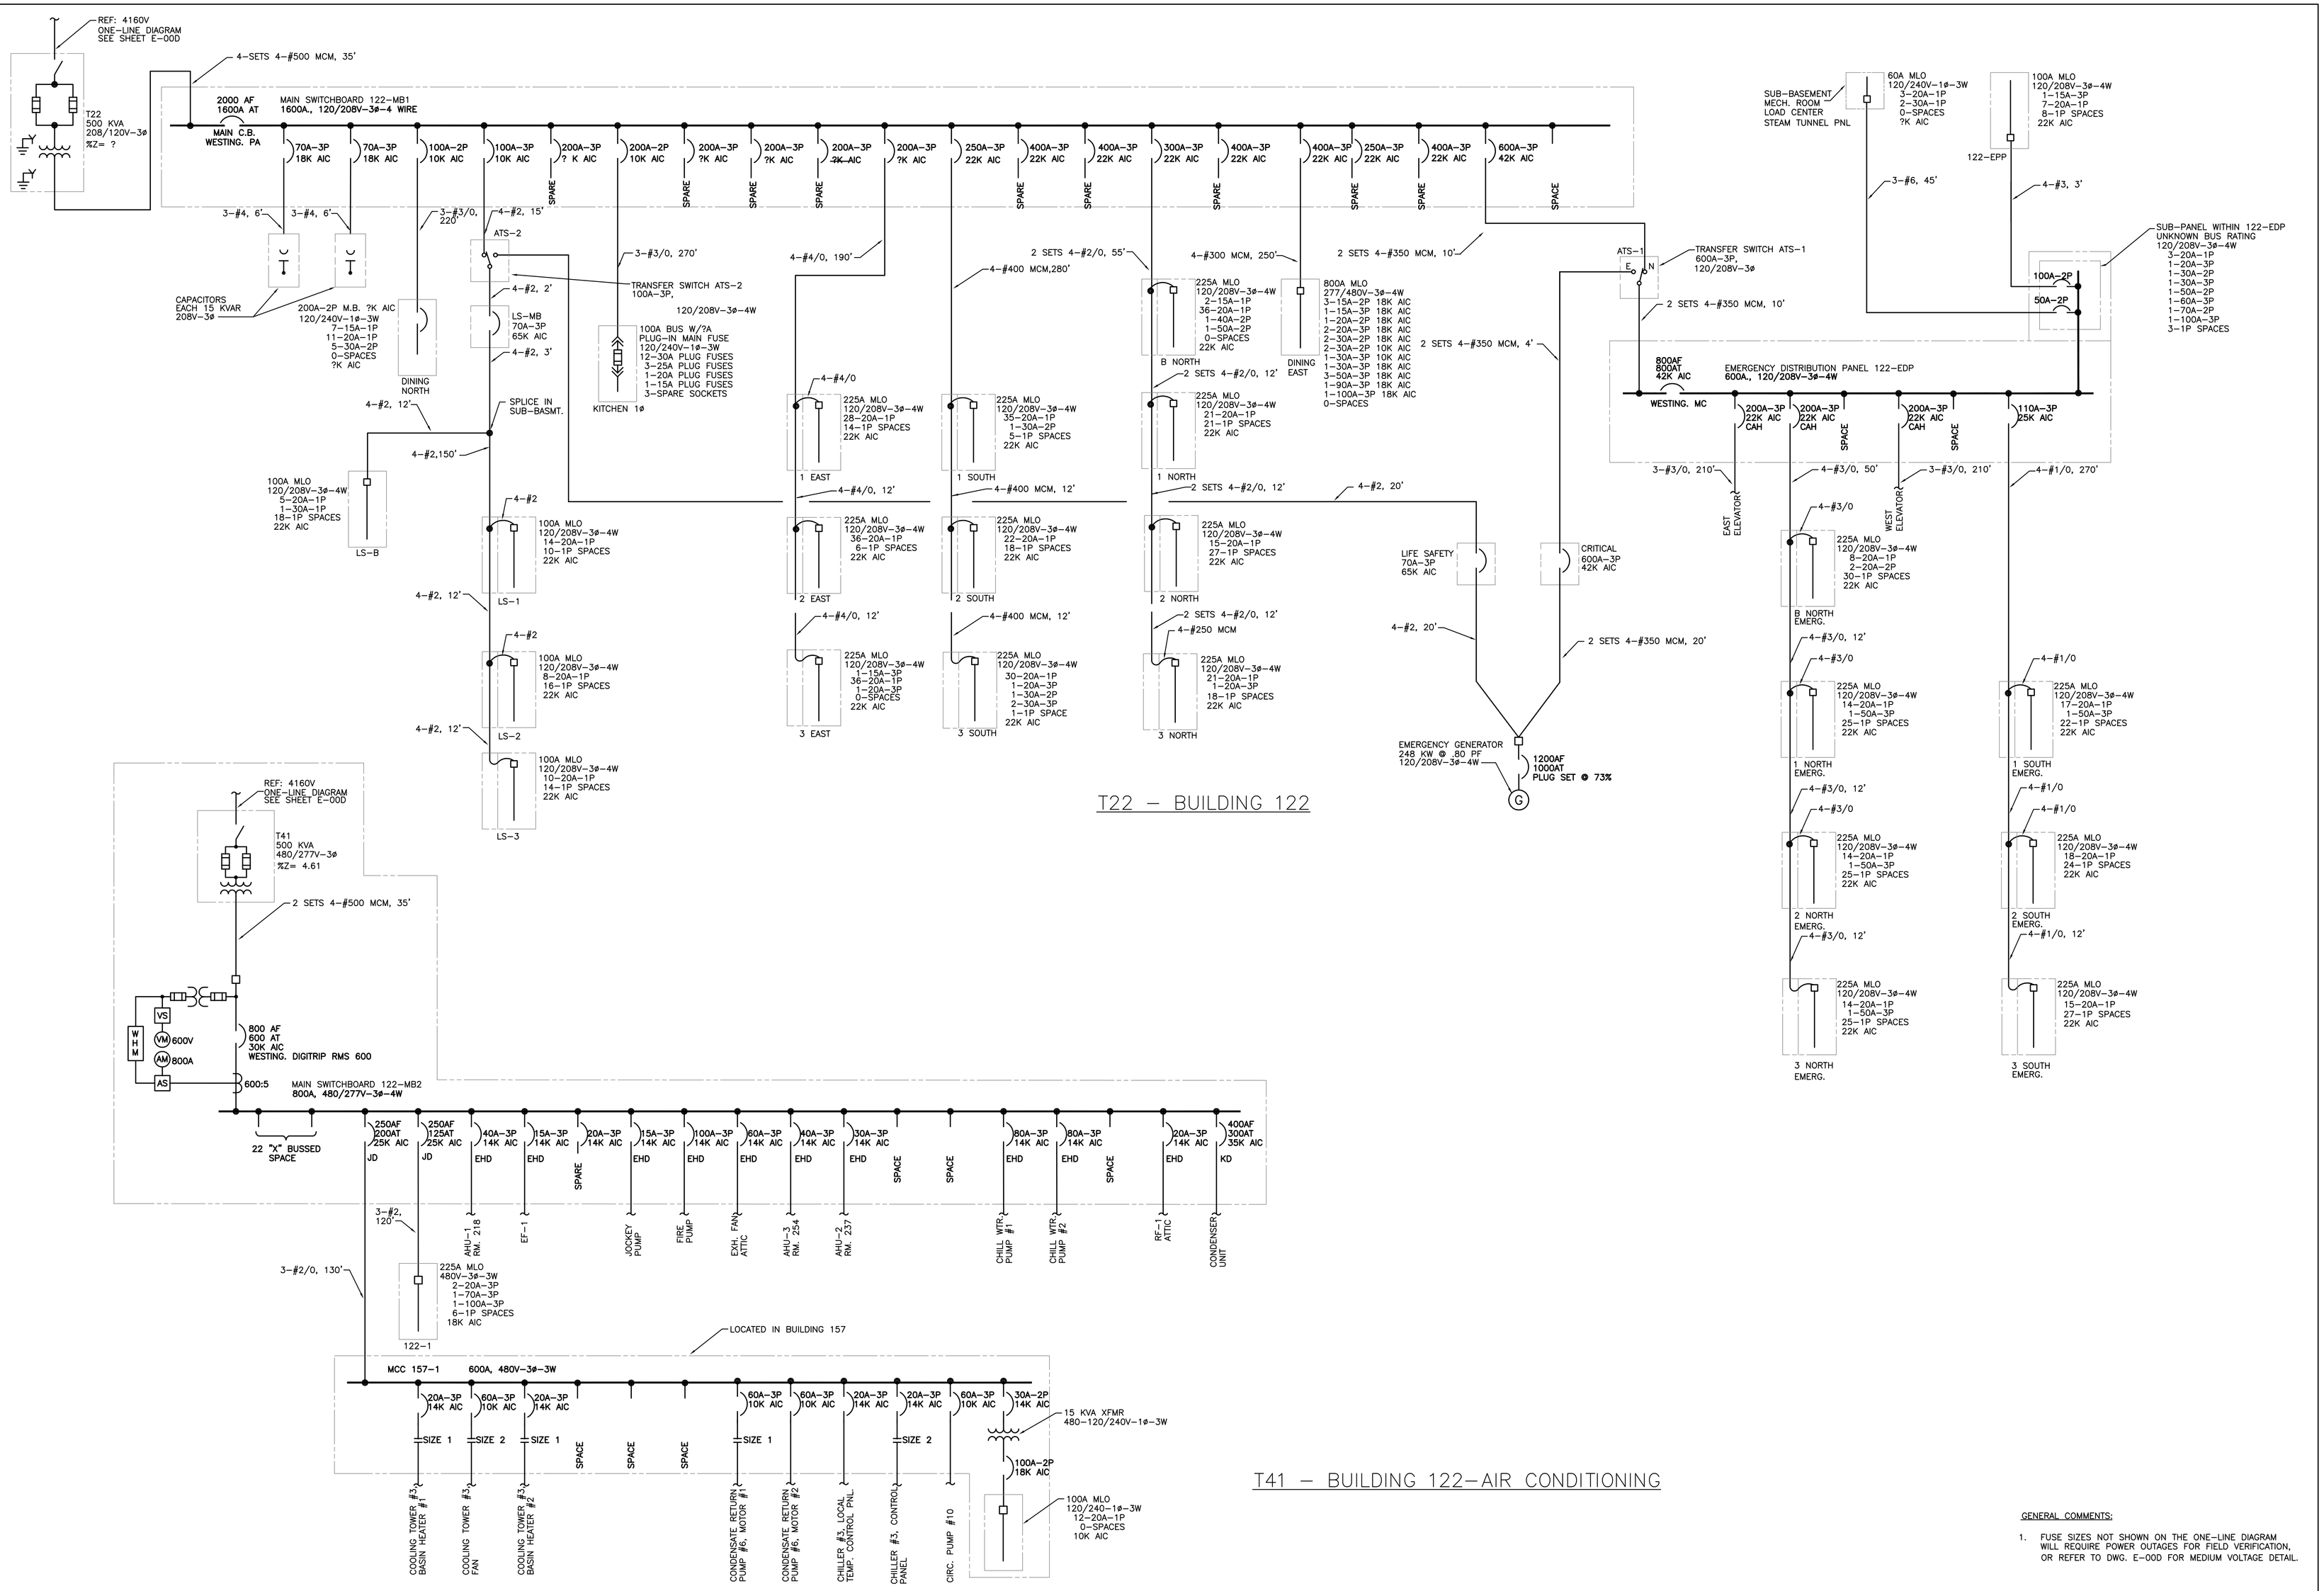

GENERAL COMMENTS:

1. FUSE SIZES NOT SHOWN ON THE ONE-LINE DIAGRAM WILL REQUIRE POWER OUTAGES FOR FIELD VERIFICATION, OR REFER TO DWG. E-00D FOR MEDIUM VOLTAGE DETAIL.

Revisions	Date

Drawing Title: XFMR T22-BLDG 122 XFMR T41-BLDG 122,157 ELECTRICAL ONE-LINE

Project Title: VA LEAVENWORTH ELECTRICAL STUDY

Date: 01/30/09

Project No. 4611.0150

Approved: Division Chief

Approved: Service Director

Building Number 122,157 | Checked PG | Drawn JG

Location DDE VAMC LEAVENWORTH, KANSAS

DRAWING NO. E-122,157

Dwg. 27 of 39

Office of Facilities

Veterans Administration