


M1 M-DECK MECHANICAL PLAN - SMOKE DAMPERS
1/8" = 1'-0"

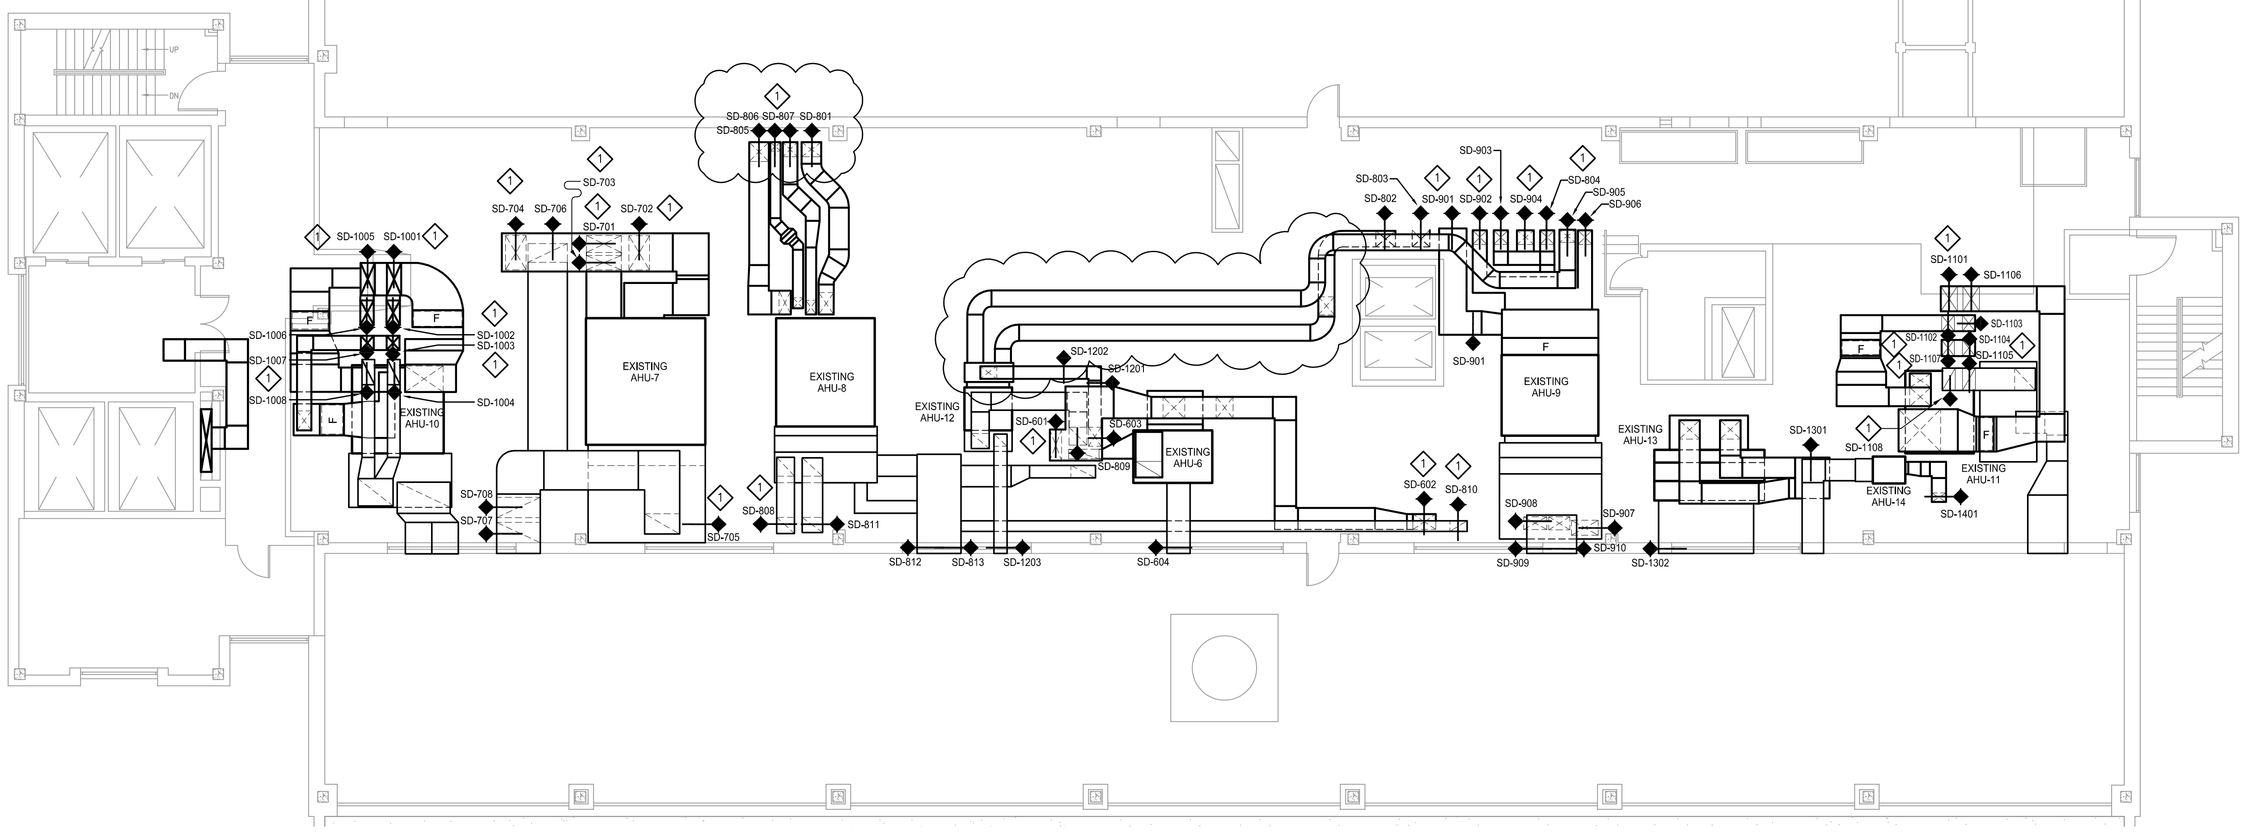


1 DAMPER AND OR ACCESS DOOR REQUIRES WORK. REFER TO TABLE ON SHEET M-101.

M2 M-DECK MECHANICAL PLAN - FIRE DAMPERS
1/8" = 1'-0"

| | |
|---|---|
| - | - |
| - | - |
| - | - |
| - | - |
| - | - |
| RECORD DRAWING SUBMISSION | 03/19/2015 |
| CONSTRUCTION DOCUMENTS SUBMISSION | 08/27/2014 |
| DESIGN DEVELOPMENT SUBMISSION | 07/10/2014 |
| SCHEMATIC DESIGN SUBMISSION | 05/15/2014 |
| Revisions: | Date |

CONSULTANTS:

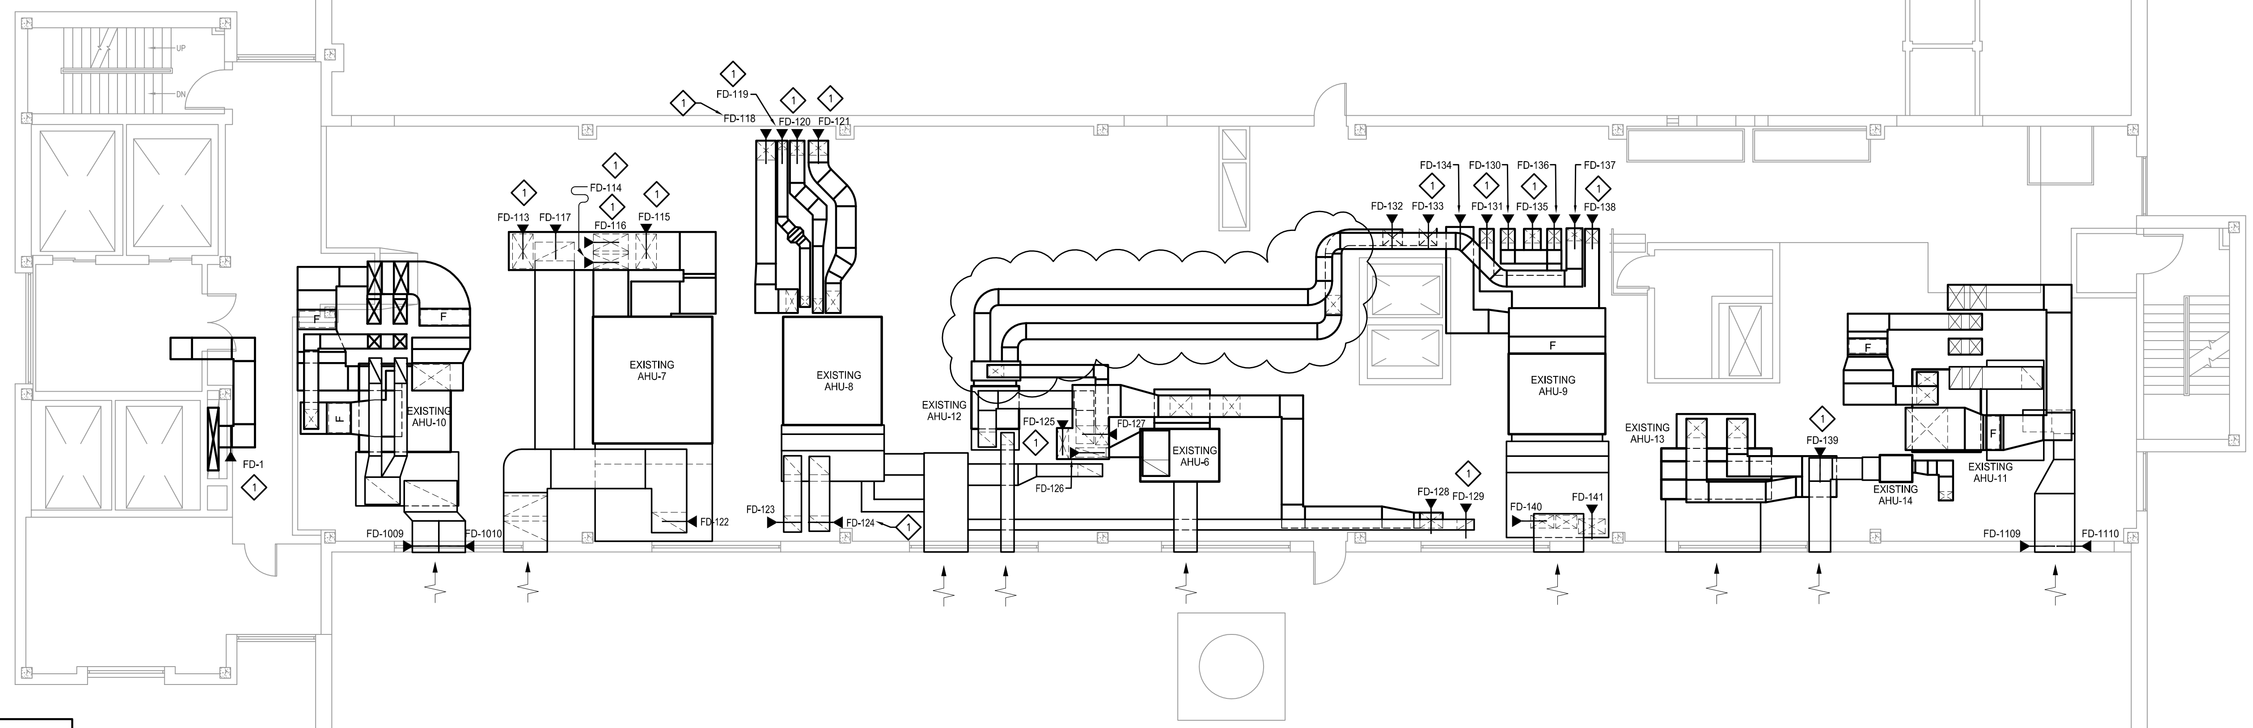
STEPANEK-LEWIS AND ASSOCIATES
2257 Twelve Oaks Way (813) 991-1248
Suite 103 fax (813) 991-0566
Wesley Chapel, Florida 33544 john@stepaneklewis.com


Sign / Seal

MATTHEW D. LEWIS, PE #56189

ARCHITECT/ENGINEERS:


DESIGN STYLES ARCHITECTURE, INC.
1708 EAST COLUMBUS DRIVE, TAMPA, FL 33605
P. 813.241.6700 / F. 247.3757
DESIGNSTYLESARCHITECTURE.COM #AA0003393

design styles **architecture+**
1708 east columbus drive
tampa, fl 33605
p 813.241.6700
f 813.247.3757
designstylesarchitecture.com
#AA0003393

MIDWESTERN CONSTRUCTION SERVICES, INC.
18505 DORMAN ROAD, LITHIA, FL 33547
P. 813.477.6986 / F. 813.655.9064
MIDWESTERNCONSTRUCTIONSERVICES.COM #CBC1250393

***Midwestern Construction Services, Inc.***


Drawing Title
MECHANICAL PLAN
M-DECK

Approved: Project Director
--
--
VAPAHCS PLANNING AND ENGINEERING

Project Title
Repair Fire Damper Deficiencies

Location
-- 5201 Raymond Street Orlando Florida

Date: MARCH 19, 2015 | Checked by: MDL | Drawn by: JPS

Project Number: 675-13-801

Building Number: 500

Drawing Number: MH-501
Dwg. 29 of 29

Office of Construction and Facilities Management
Department of Veterans Affairs

VA FORM 08-6231