



three inches = one foot
one and one half inches = one foot
one inch = one foot
three quarters inch = one foot
one half inch = one foot
one quarter inch = one foot
three eighths inch = one foot
one eighth inch = one foot
one eighth inch = one foot

NOTES
A. REFER TO E-001 FOR ELECTRICAL LEGEND, ABBREVIATIONS, AND GENERAL NOTES.

- KEY NOTES**
- 1. NEW VERTICAL CLASSROOM UNIT. ROUTE NEW 208V, 1PH CIRCUIT BACK TO PANEL IN BASEMENT AS INDICATED.
 - 2. BOX OUT ALONG FLOOR FOR NEW PIPING AND ELECTRICAL; REFER TO 13.MP501 FOR BOX DETAILS.
 - 3. NEW FAN COIL UNIT, 120V CIRCUIT TO REMAIN. RE-WIRE MAY BE REQUIRED TO CORRECT LOCATION IN PANEL.
 - 4. ROUTE NEW CIRCUIT UP TO FCU ON FLOOR ABOVE.
 - 5. ROUTE NEW CIRCUIT TO PANEL 'A', CIRCUIT 20 BELOW.

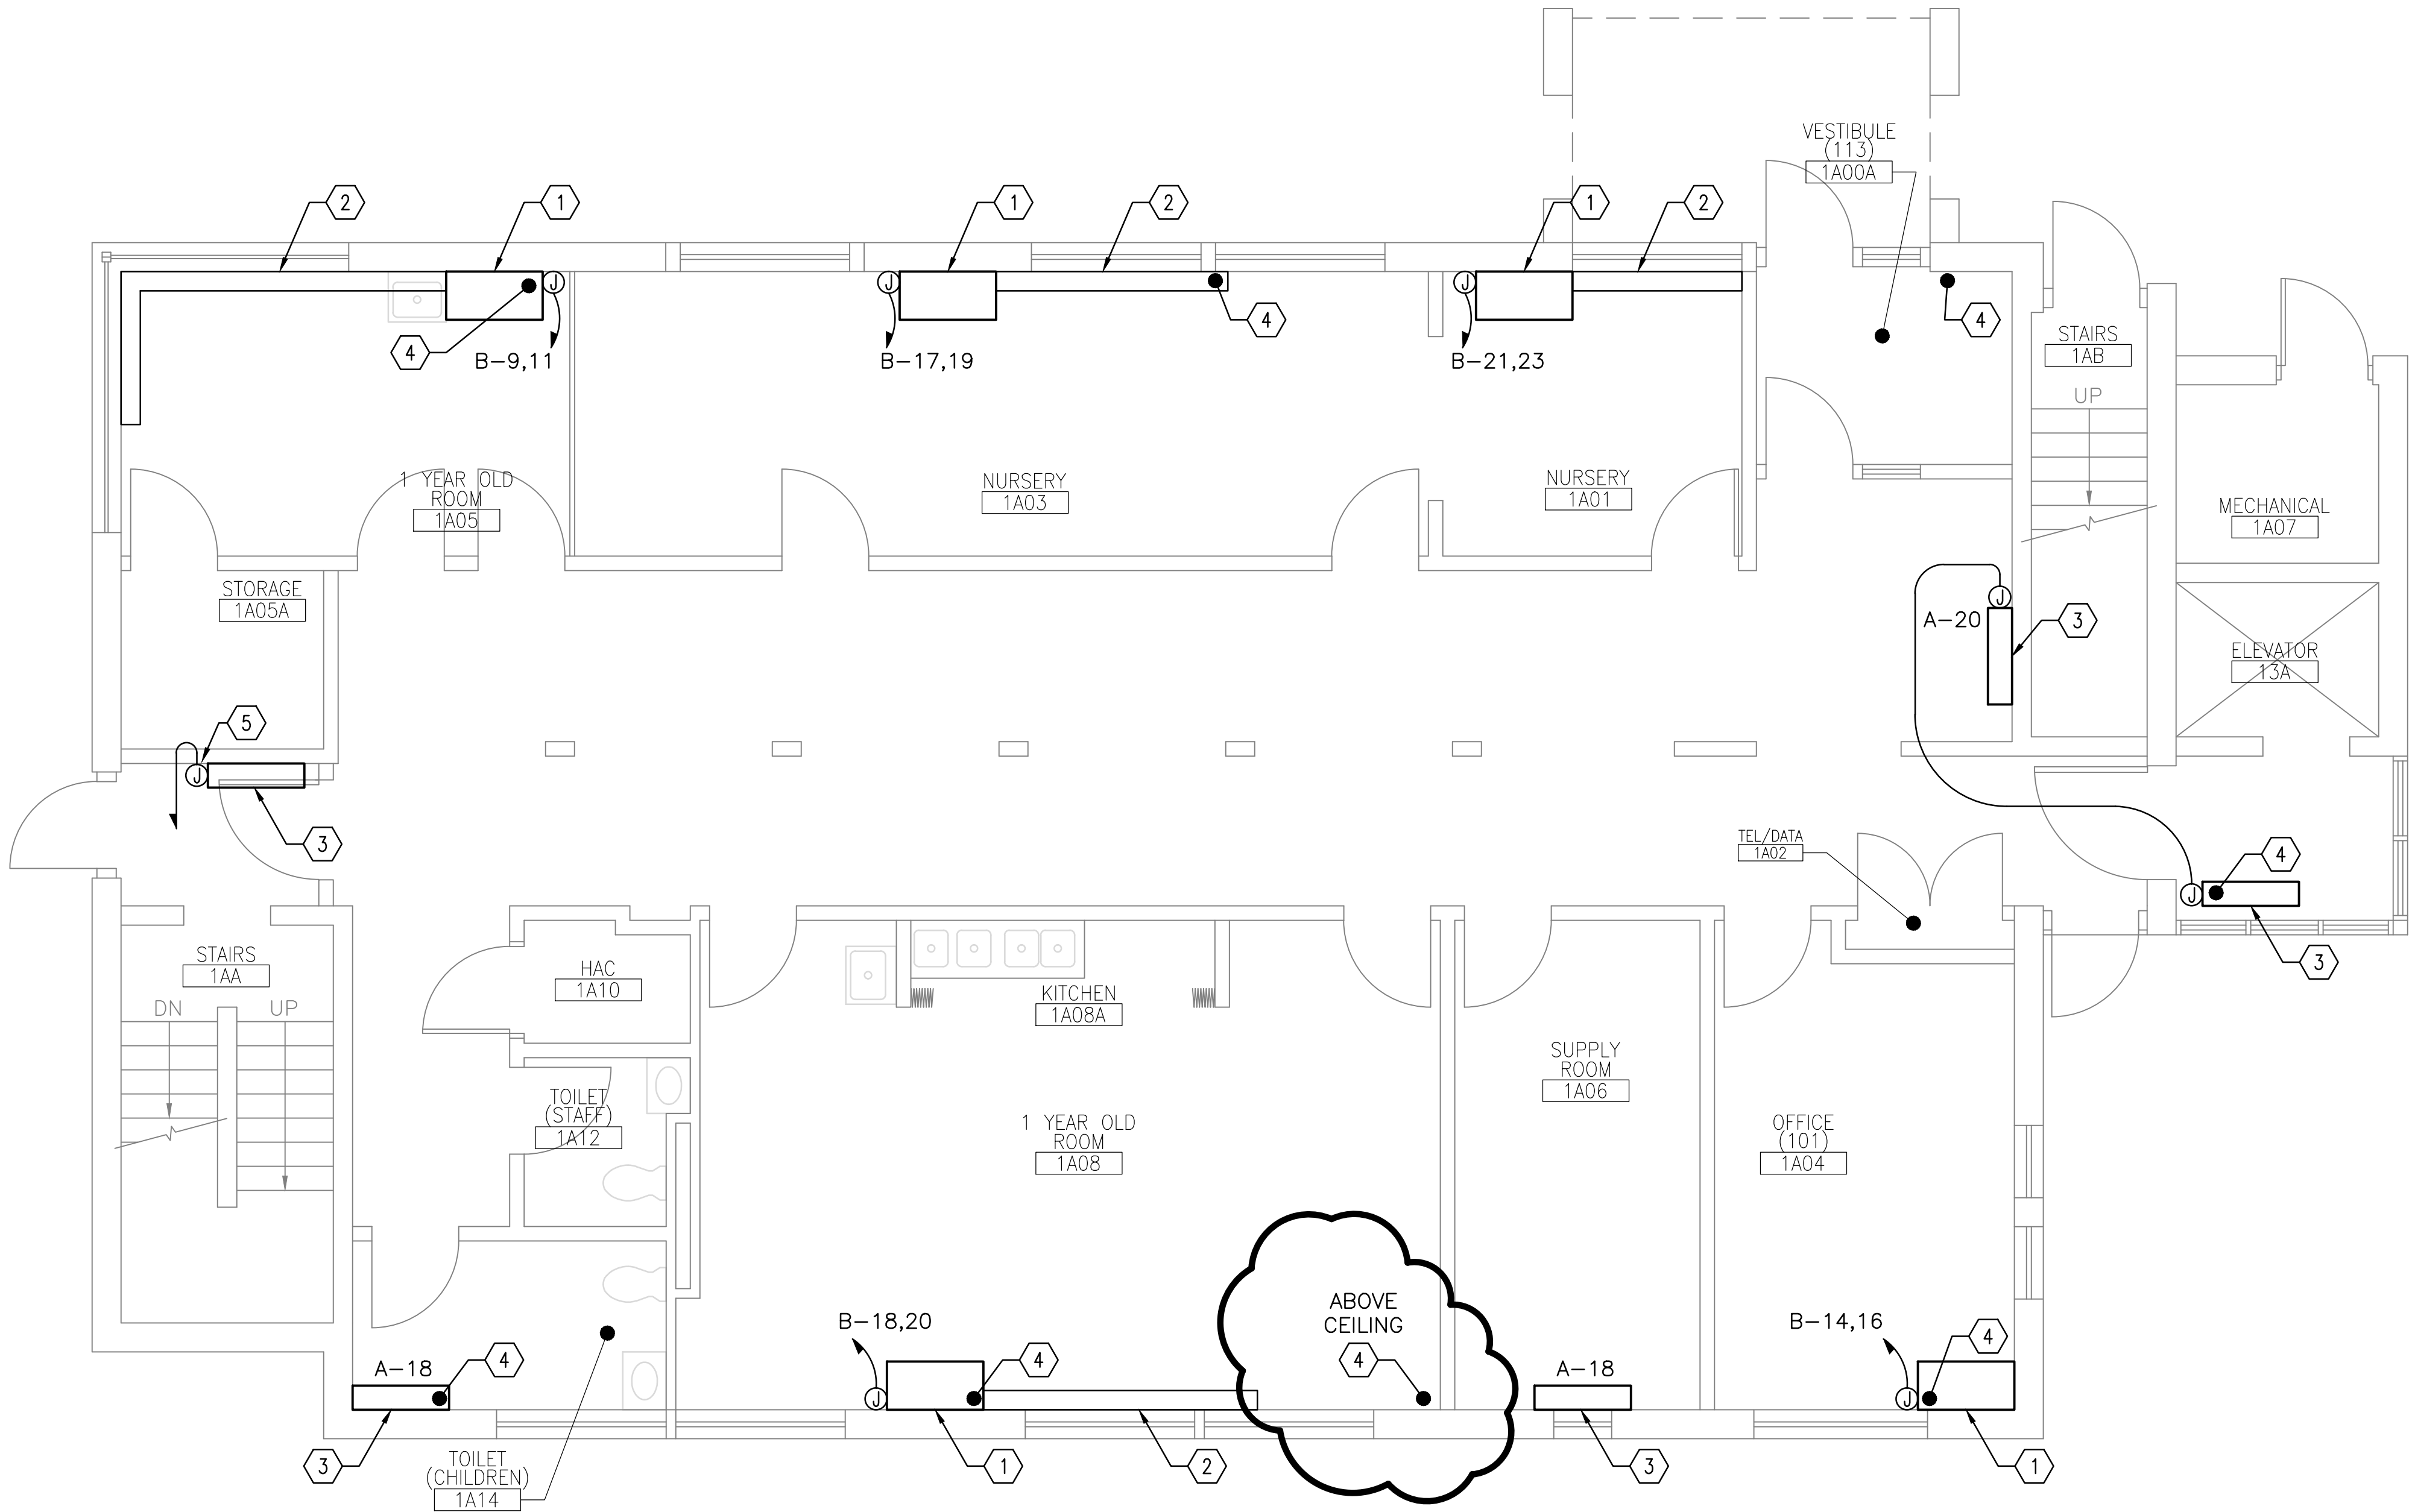

F3 FLOOR PLAN
SCALE 1/4" = 1'-0"

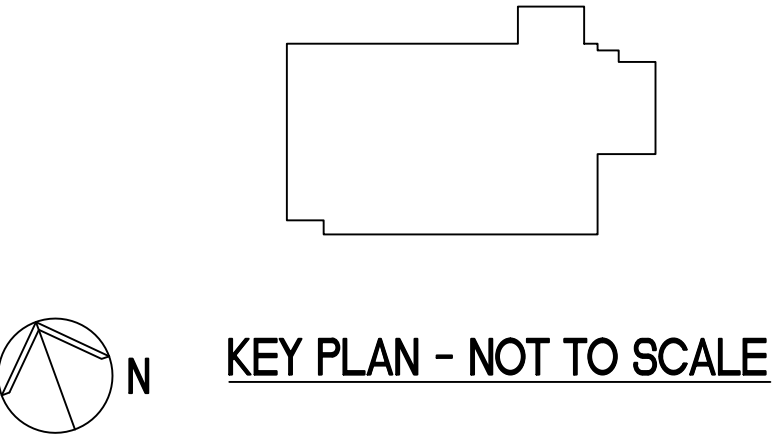

KEY PLAN - NOT TO SCALE

FULLY SPRINKLERED
BID DOCUMENTS
FOR CONSTRUCTION

--	--	