
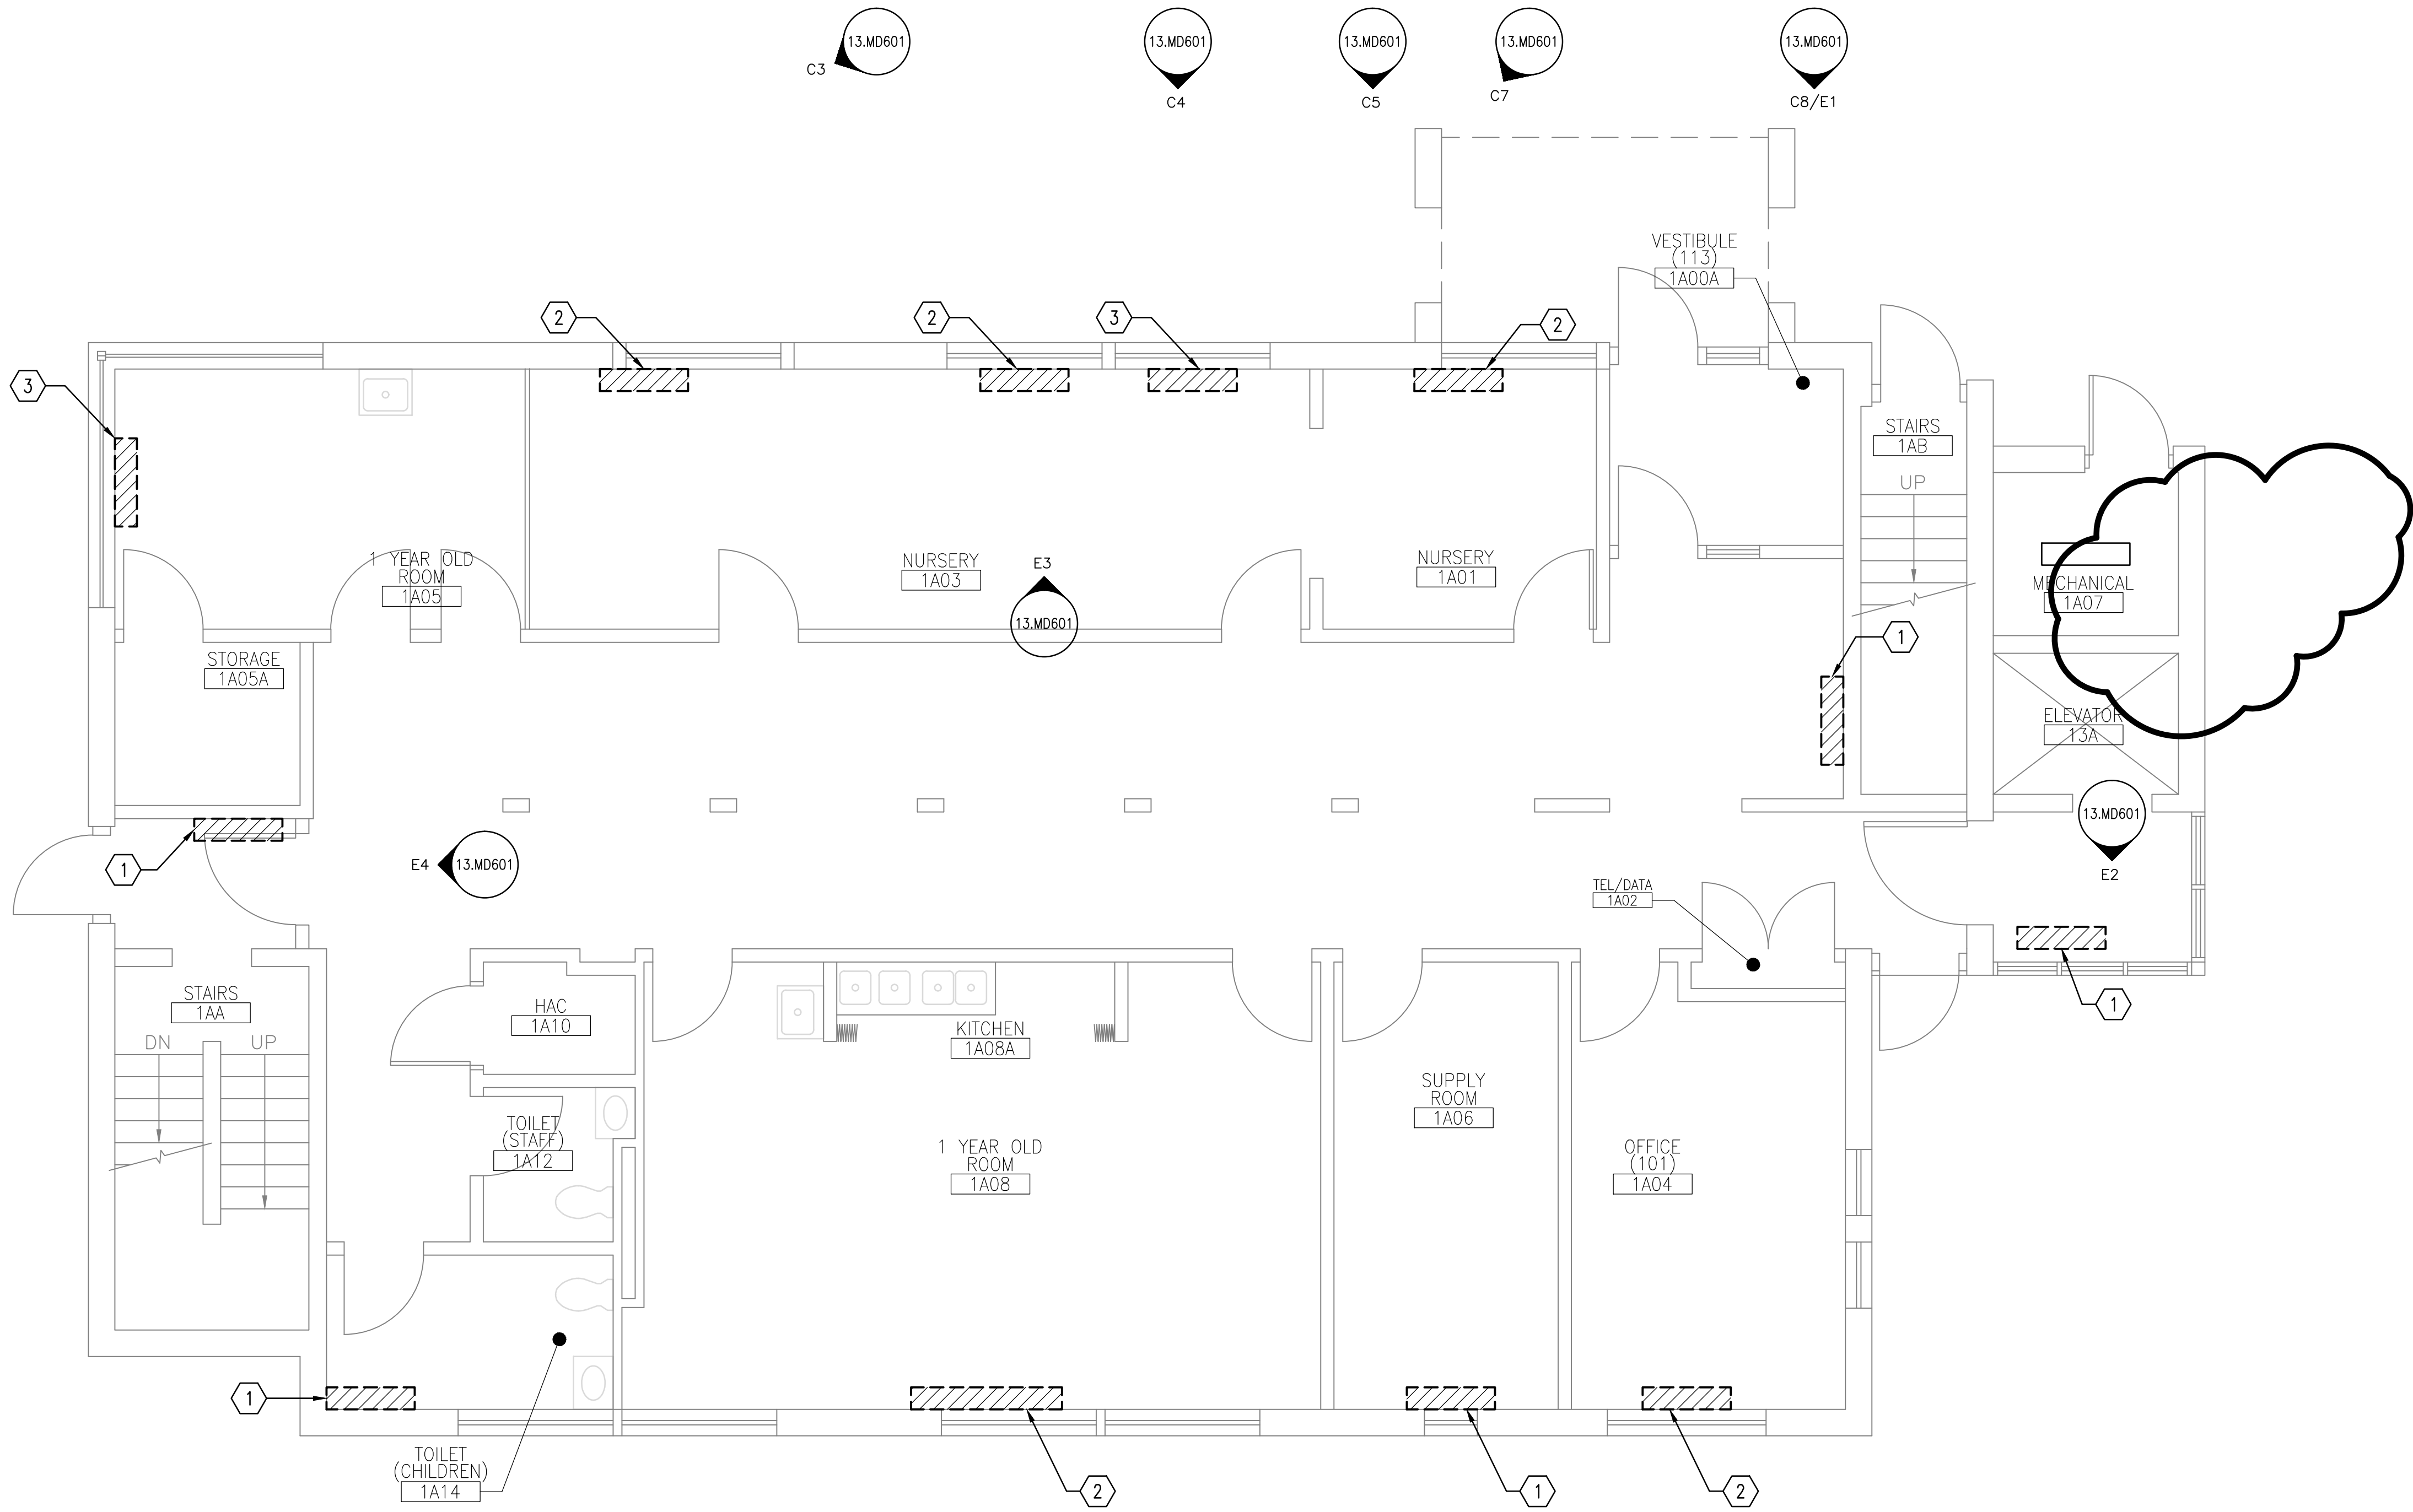



three inches = one foot
one and one half inches = one foot
one inch = one foot
three quarters inch = one foot
one half inch = one foot
one quarter inch = one foot
one eighth inch = one foot

- NOTES**
- A. REFER TO E-001 FOR ELECTRICAL LEGEND, ABBREVIATIONS, AND GENERAL NOTES.
- B. REFER TO SHEET 13.MD601 FOR PHOTOGRAPHS OF WORK AREA.

- KEY NOTES**
1. REMOVE EXISTING FAN COIL UNITS. EXISTING CIRCUITS TO REMAIN AND BE REUSED AS INDICATED UNLESS NOTED OTHERWISE.
2. REMOVE CIRCUIT BACK TO PANEL AND PREPARE FOR NEW 208V/1 PH CIRCUIT TO NEW FCU LOCATION.
3. REMOVE EXISTING FAN COIL UNITS. CIRCUITS TO BE PULLED BACK TO PANEL.

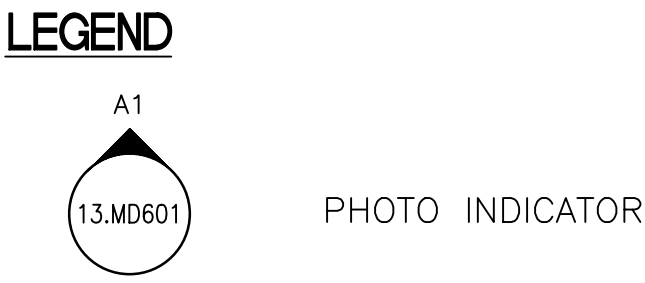

F3 FLOOR PLAN
SCALE 1/4" = 1'-0"

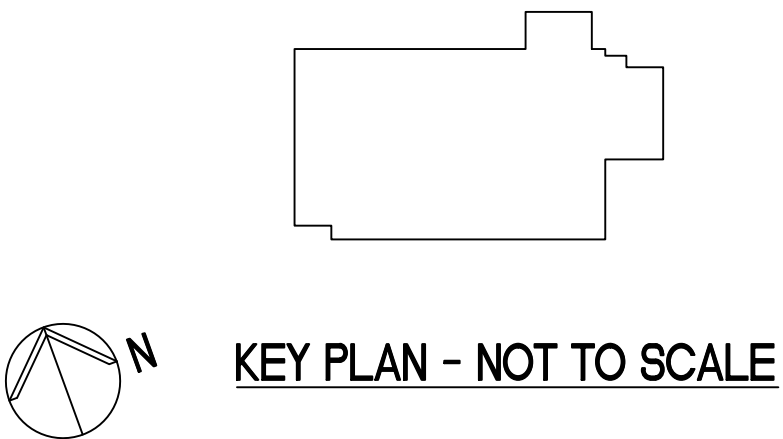

FULLY SPRINKLERED
BID DOCUMENTS
FOR CONSTRUCTION

																																																																																																																																																																																																																																																																																																																																																																																																																																																																																																																																																																																																																																																																																																																																																																																																																																																																																																																																																																																																																																																																																																																																																																																																																																																																																																																																																																																																																																																																																																																																																																																																																					</
--	--	----