


Current layout 3358

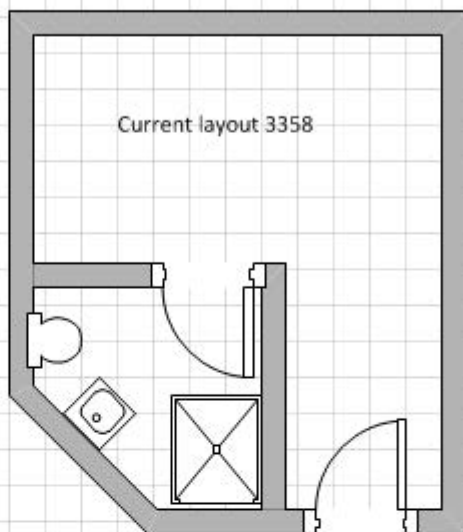

Proposed Layout 3358

