


REP LEGEND/CLIN SOW

(D) REPAIR 4550 L.F. OF THE STONE CAPS WHERE THE FENCE POST DO NOT ALIGN WITH THE JOINTS. CAPS THAT DO NOT MEET THIS CONDITION SHALL BE REPLACED.

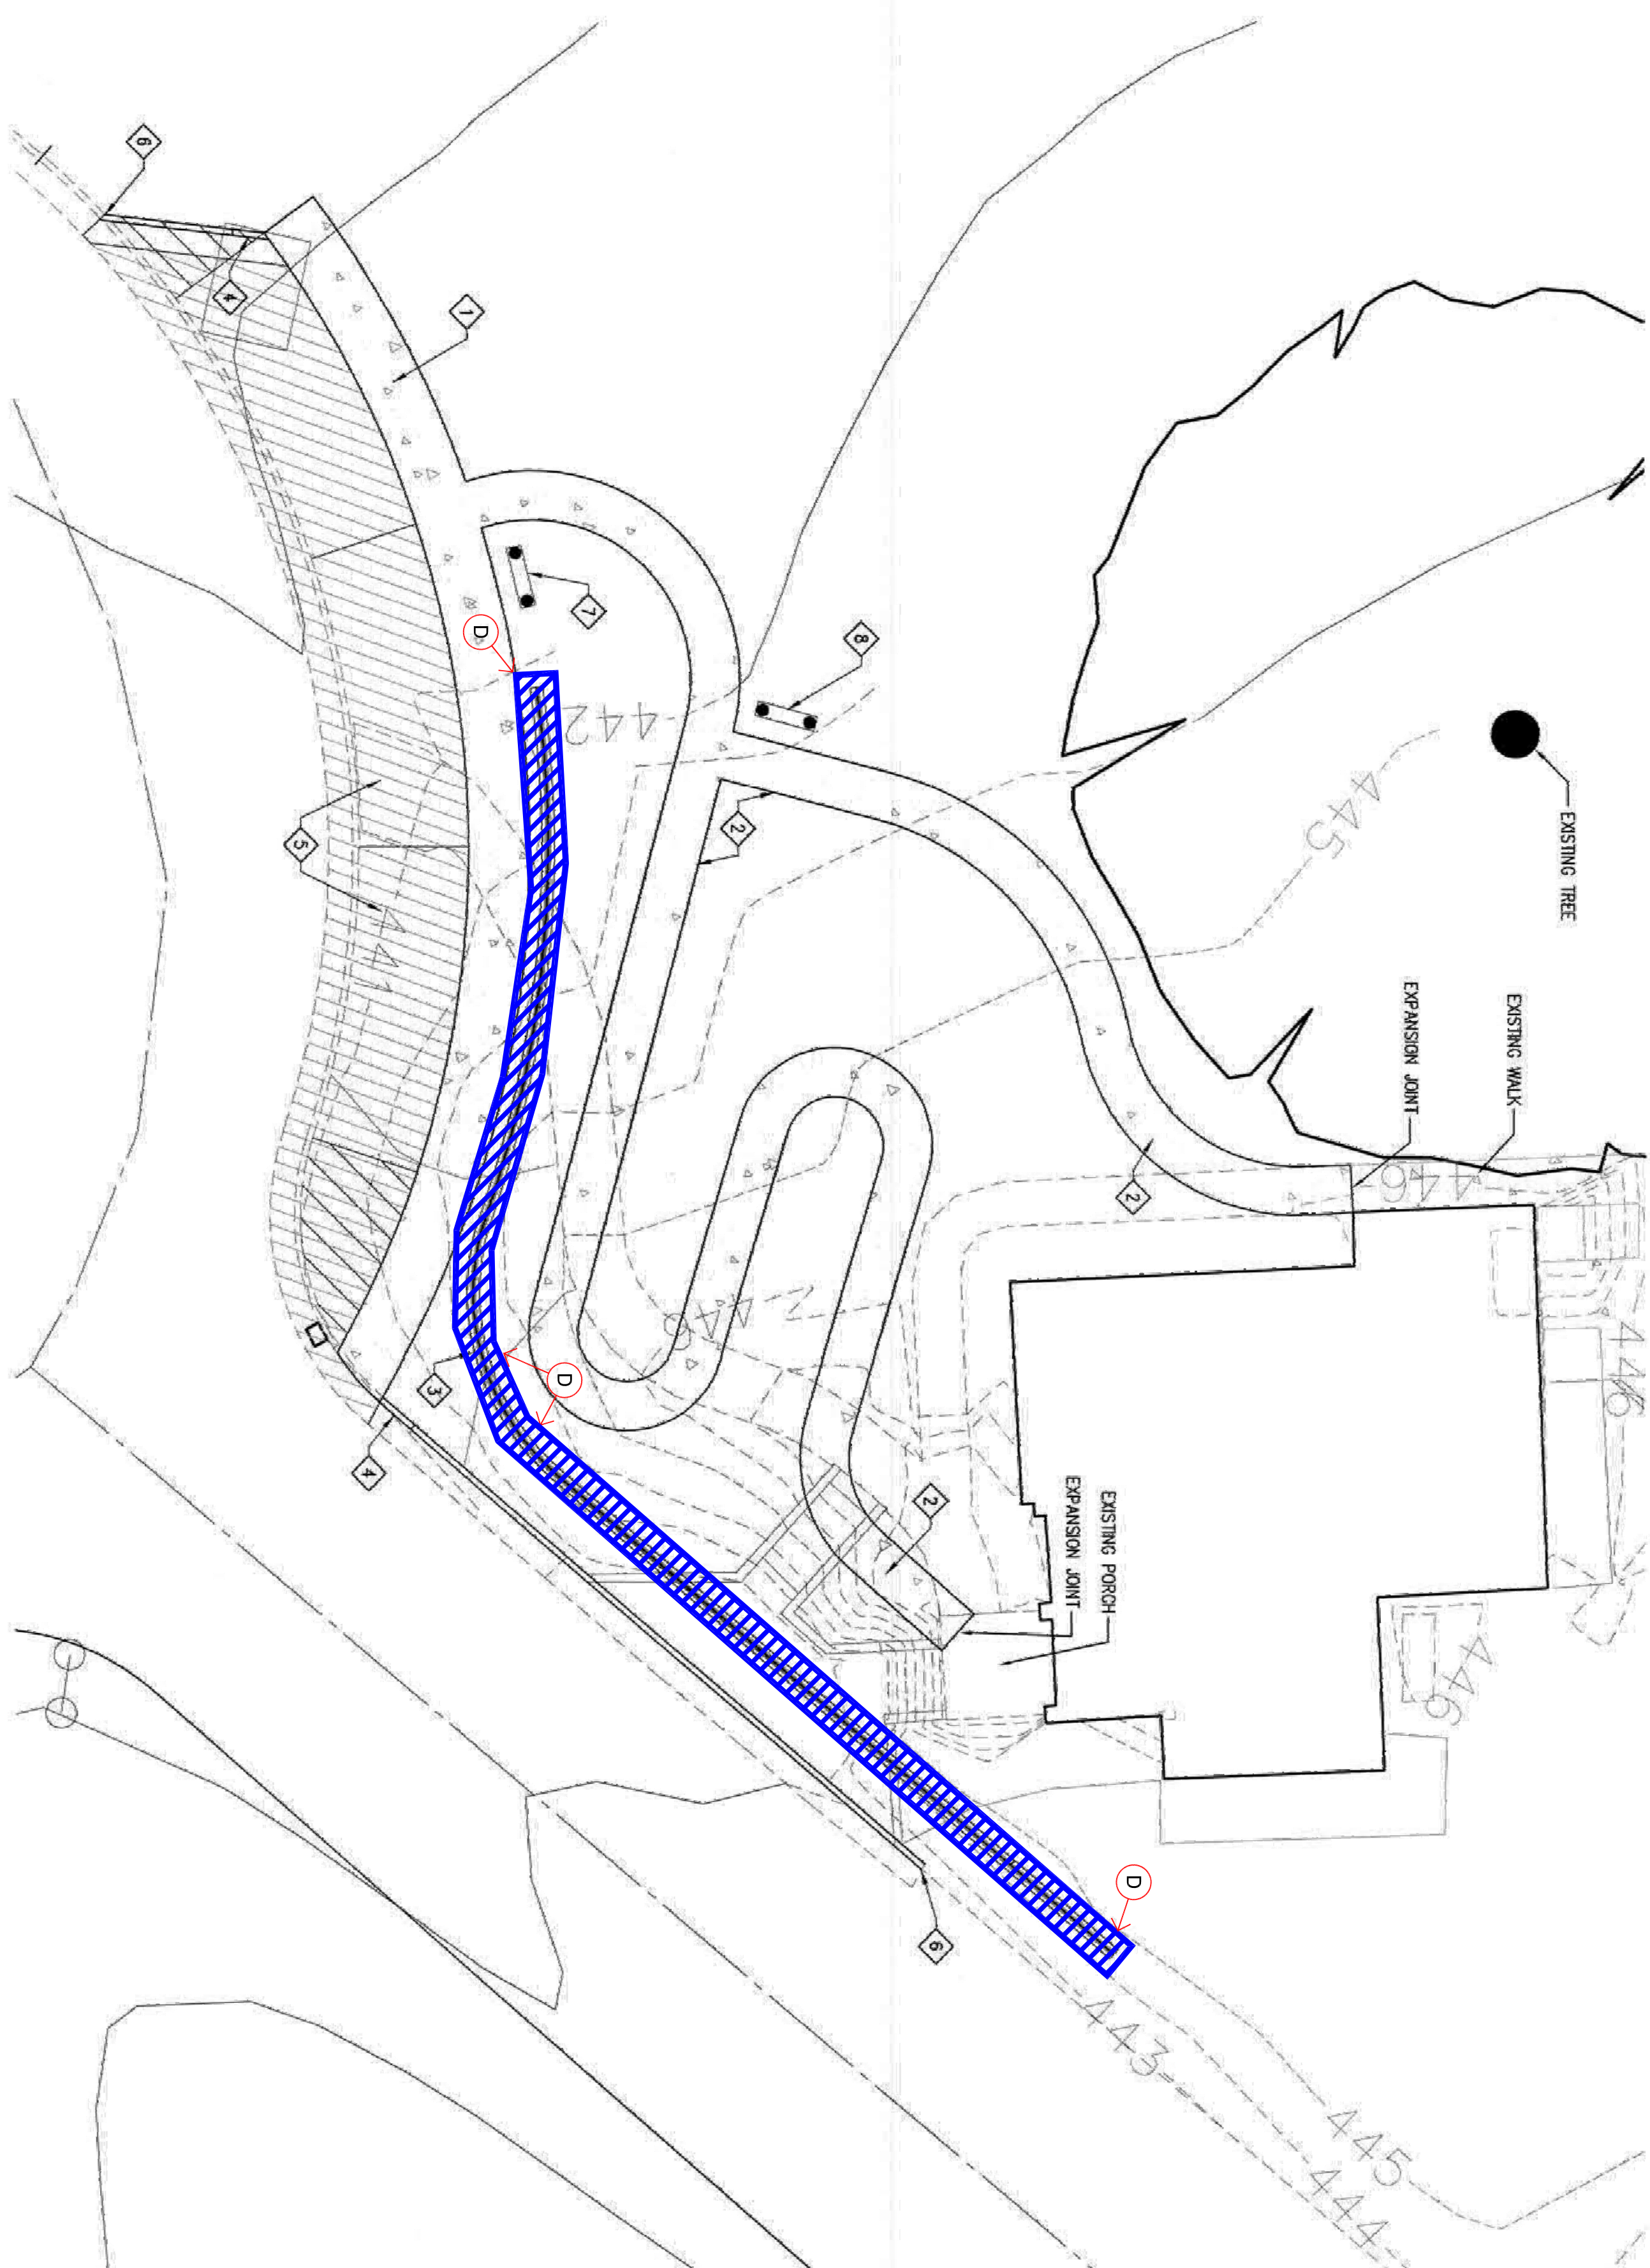


KEY NOTES:

SITE PLAN KEY NOTES:

1. NEW 5' WIDTH SIDEWALK - SEE DETAIL H/ L-17
2. NEW 4' WIDTH SIDEWALK - SEE DETAIL H/ L-17
3. NEW 12" WIDH CAST-IN-PLACE CONCRETE WALL - SEE DETAIL A/ L-23
4. TRANSITION CURB FLUSH TO NEW ASPHALT - SEE DETAIL B/ L-17
5. NEW ASPHALT PAVING - SEE DETAILS C/ L-17 AND D/ L-17
6. NEW CURB AND GUTTER, TIE TO EXISTING - SEE DETAILS A/ L-17
7. INSTALL NEW ADMINISTRATION LOCATION SIGN - SEE DETAIL 1/ L-19 TYPE A.5
8. INSTALL NEW DOUBLE SPOED RESTROOM SIGN - SEE DETAIL 1/ L-19 TYPE A.6a & A.6b

GENERAL NOTES:

1. SEE SHEET X-1 FOR CUL, LEGEND, ABBREVIATIONS, AND GENERAL NOTES.
2. CONTRACTOR IS RESPONSIBLE FOR ALL WORK SHOWN UNLESS SPECIFICALLY INDICATED OTHERWISE.
3. CONTRACTOR SHALL VISIT THE SITE PRIOR TO CONSTRUCTION TO DETERMINE THE EXTENT OF THE PROJECT.
4. CONTRACTOR SHALL CONTACT ARKANSAS ONE CUL AT 811 PRIOR TO ANY WORK. CONTRACTOR IS RESPONSIBLE FOR FIELD LOCATING AND PROTECTING ALL UTILITIES. CONTACT THE ENGINEER IN THE EVENT THAT THE UTILITIES DO NOT MATCH THE PLAN DIMENSIONS.
5. ALL WORK SHALL BE PERFORMED BY AN ARKANSAS REGISTERED PROFESSIONAL SURVEYOR.

| | | | |
|--|--|-----------------------|--|
| ENGINEER | | SURVEYOR | |
| Revisions | | Date | |
| <div><div>NATIONAL CEMETERY ADMINISTRATION</div></div> | | | |
| Drawing Title | | Project Title | |
| ADMINISTRATION BUILDING SITE PLAN | | CEMETERY IMPROVEMENTS | |
| Approved: Director, Technical Support Service | | Building Number | |
| Approved: Chief, Architectural & Engineering Division | | Checked MII | |
| | | Drawn JLM | |
| Location | | DRAWING NO. | |
| FORT SMITH, ARKANSAS | | L-2 | |
| | | RFP-3 of 5 | |
| Date | | Project No. | |
| 8-7-15 | | 847CM3016B | |