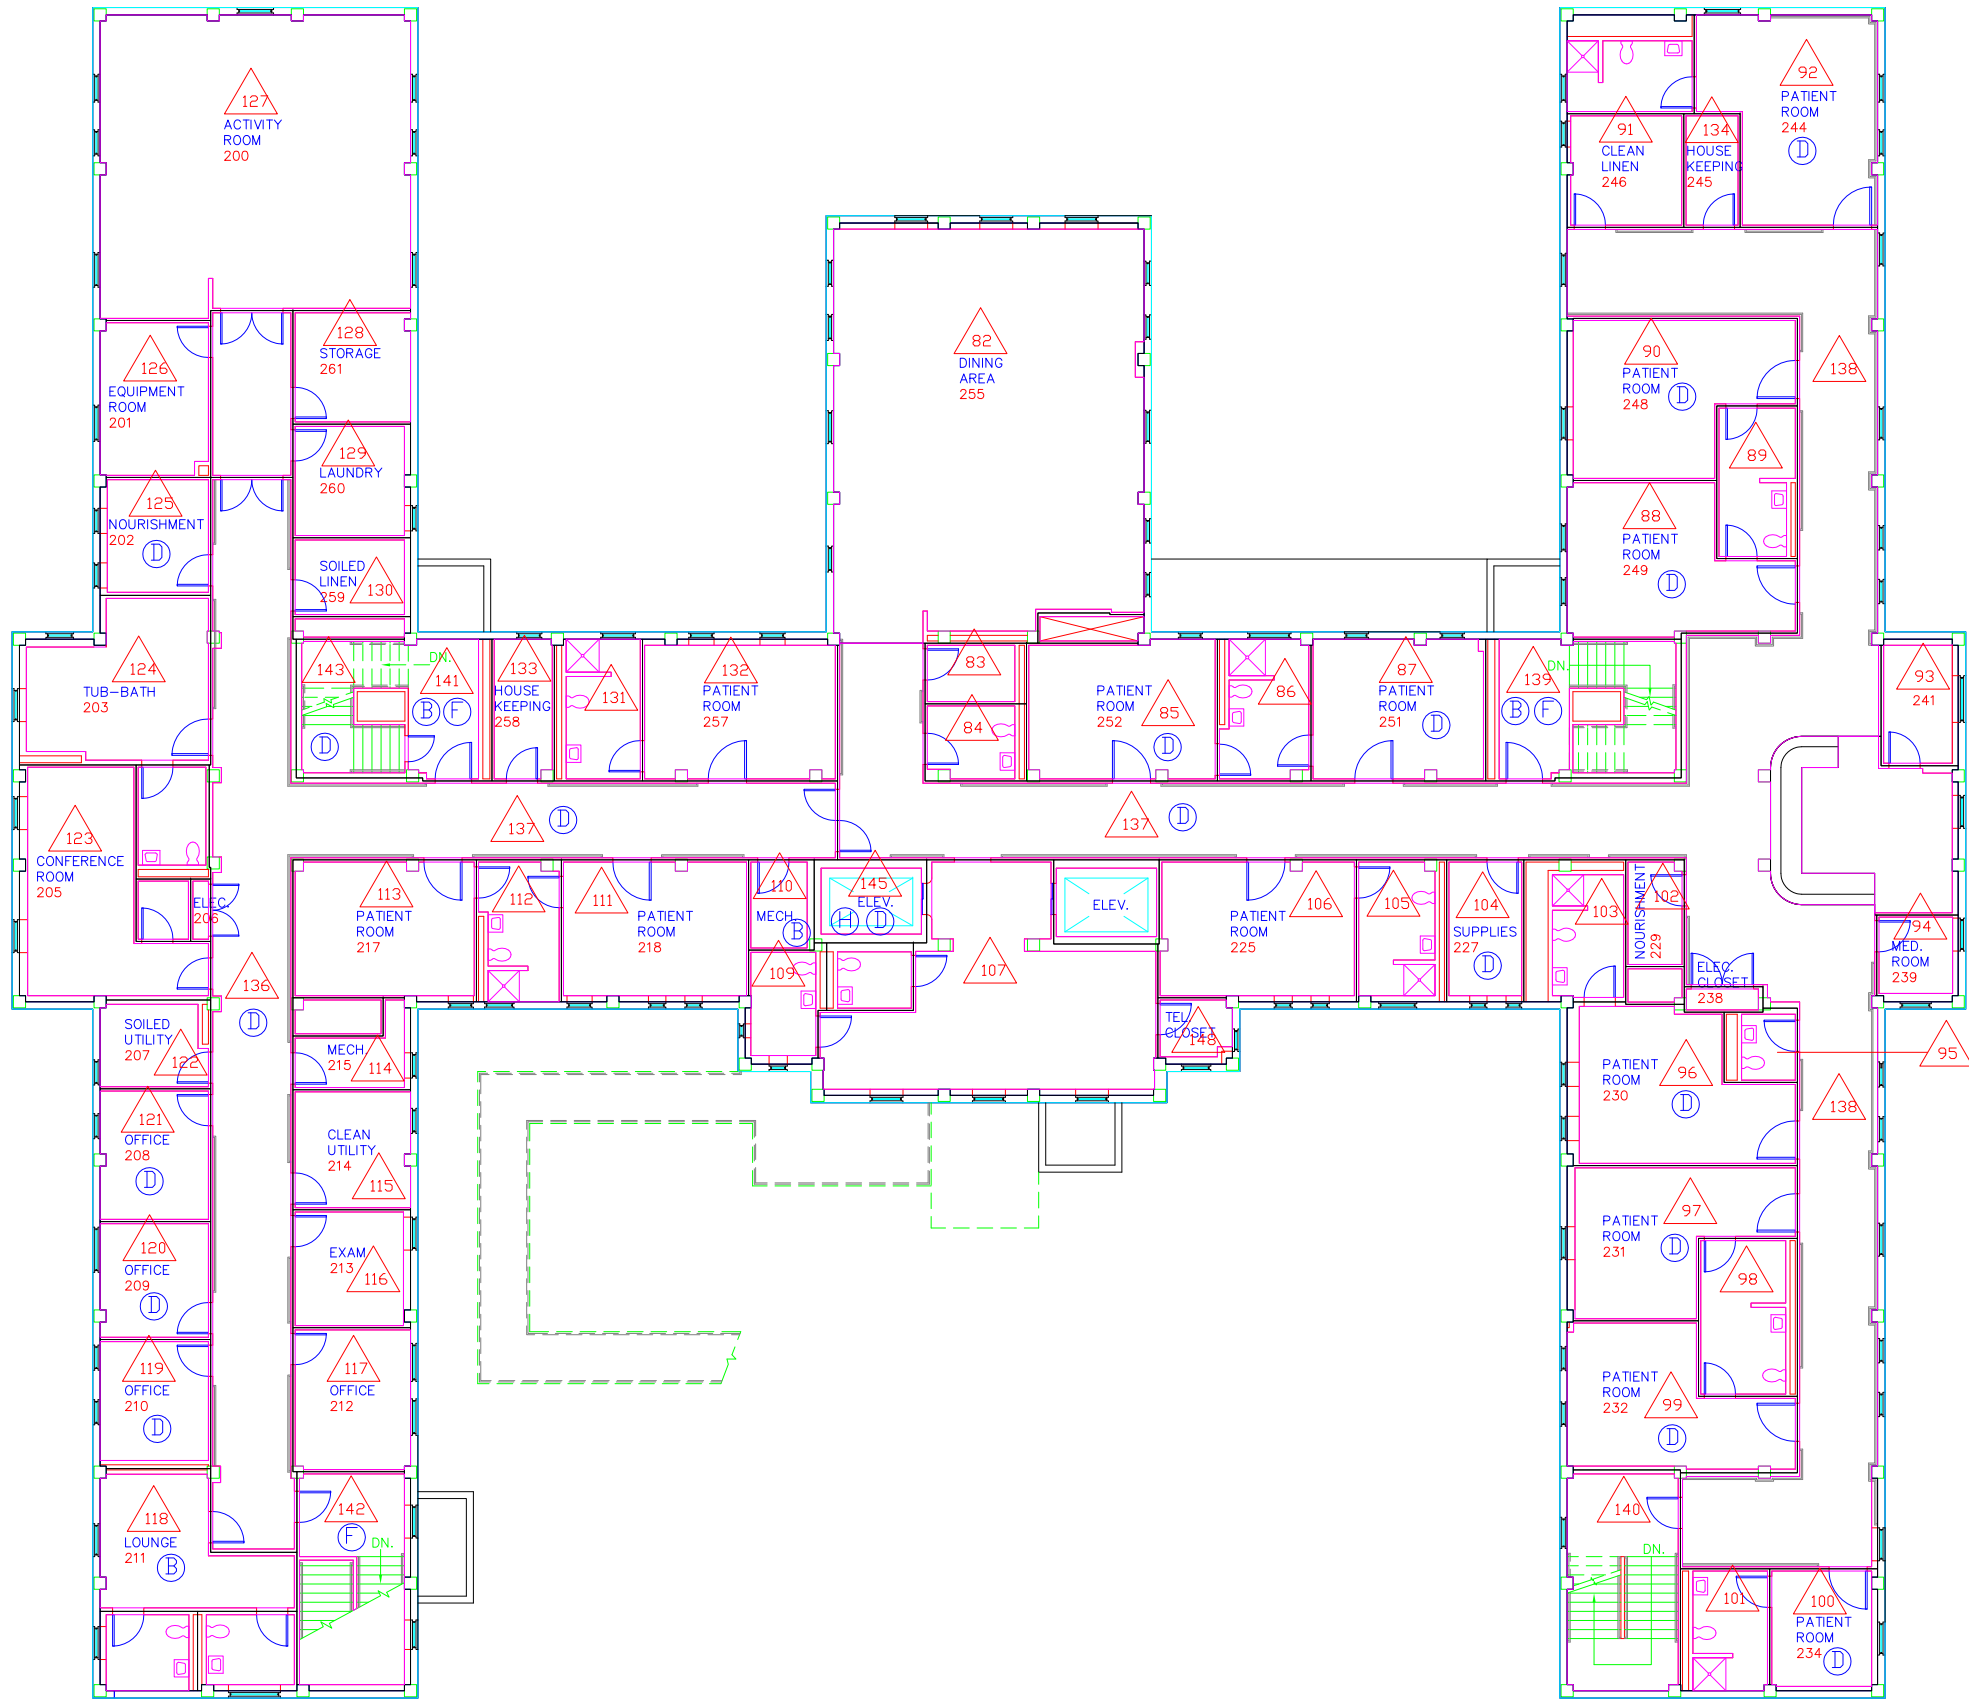

ASBESTOS CONTAINING MATERIALS

A. FLOOR TILE
B. AIR CELL PIPE INSULATION
C. MUDDED PIPE FITTINGS
D. ASSUMED PIPE AND PIPE FITTING INSULATION
E. ACOUSTIC WALL TILE
F. ASSUMED FLOOR TILE
G. ASSUMED ELEVATOR FIRE DOORS
H. WHITE DUCT SEAM SEALANT
I. WHITE PIPE SEAM SEALANT
J. ASSUMED ELEVATOR WALL INSULATION
K. ASSUMED ELEVATOR DOOR INSULATION
L.ASSUMED ROOFING

△ – AREA DESIGNATION

○ – ASBESTOS CONTAINING MATERIAL DESIGNATION

Revisions	Date

AEROSOL MONITORING & ANALYSIS, INC.
1331 ASHTON ROAD, P.O. BOX 646
HANOVER, MARYLAND 21076
WEBSITE: WWW.AMACONSULTING.COM
PHONE: 410-684-3327
FAX: 410-684-3384

Professional Seal

Drawing Title	SECOND FLOOR PLAN ARCHITECTURAL
Project Title	AS-BUILT Drawings
Date	05-02-2005
Project No.	
Drawing No.	
Approved:	
Approved:	
Building Number	14H
Checked	
Drawn	
Location	VAMC, PERRYPOINT, MARYLAND

VAMC, PERRYPOINT

Department of Veterans Affairs

VA FORM 08-6231, OCT 1978