NORTH

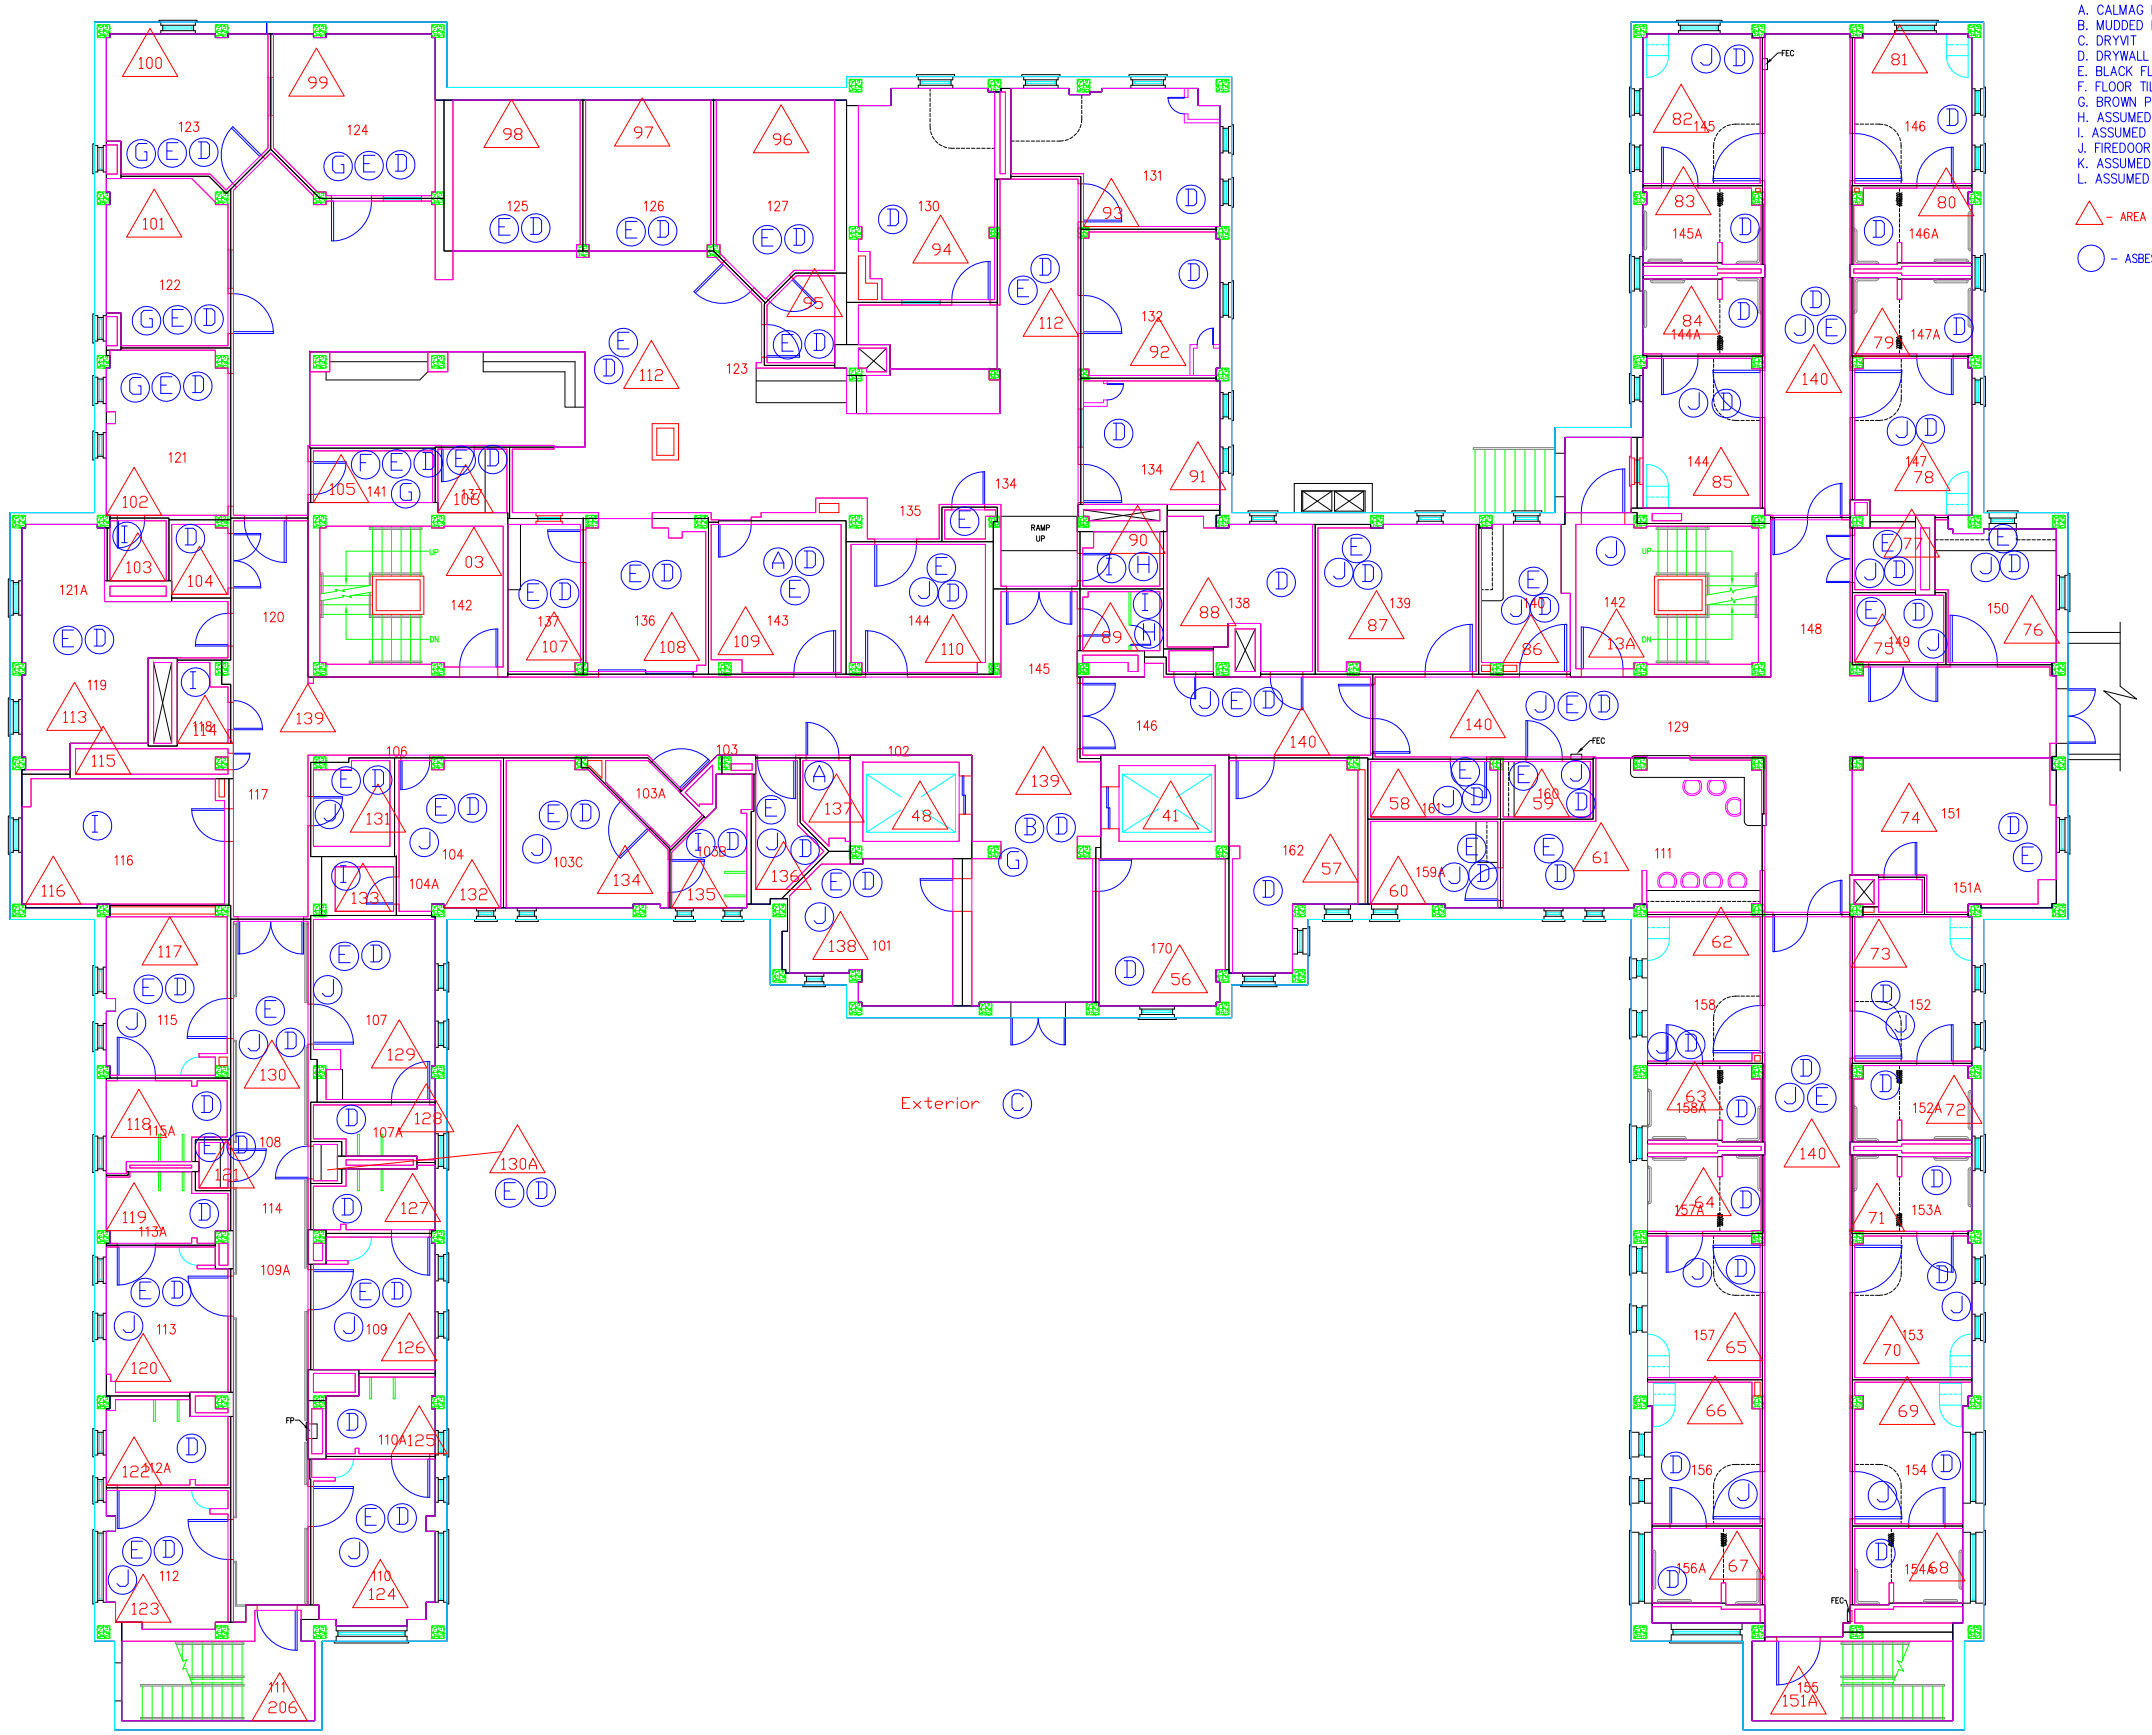

ASBESTOS CONTAINING MATERIALS

A. CALMAG PIPE INSULATION
B. MUDDED FITTINGS
C. DRYVIT
D. DRYWALL and JOINT COMPOUND
E. BLACK FLOOR TILE MASTIC
F. FLOOR TILE
G. BROWN PIN DOT MASTIC
H. ASSUMED MIRROR MASTIC
I. ASSUMED PIPE and FITTING INSULATION
J. FIREDOOR
K. ASSUMED ELEVATOR CAB INSULATION
L. ASSUMED ELEVATOR DOOR INSULATION

△ – AREA DESIGNATION

○ – ASBESTOS CONTAINING MATERIAL DESIGNATION

Revisions	Date

AEROSOL MONITORING & ANALYSIS, INC.
1331 ASHTON ROAD, P.O. BOX 646
HANOVER, MARYLAND 21076
WEBSITE: WWW.AMACONSULTING.COM
PHONE: 410-684-3327
FAX: 410-684-3384

Professional Seal

Drawing Title: FIRST FLOOR PLAN ARCHITECTURAL

Approved:

Approved:

Project Title: AS-BUILT Drawings

Building Number: 19H | Checked | Drawn

Location: VAMC PERRYPOINT MARYLAND

Date: 03-10-2011

Project No.

Drawing No.

VAMC, PERRYPOINT

Department of Veterans Affairs

VA FORM 08-6231, OCT 1978