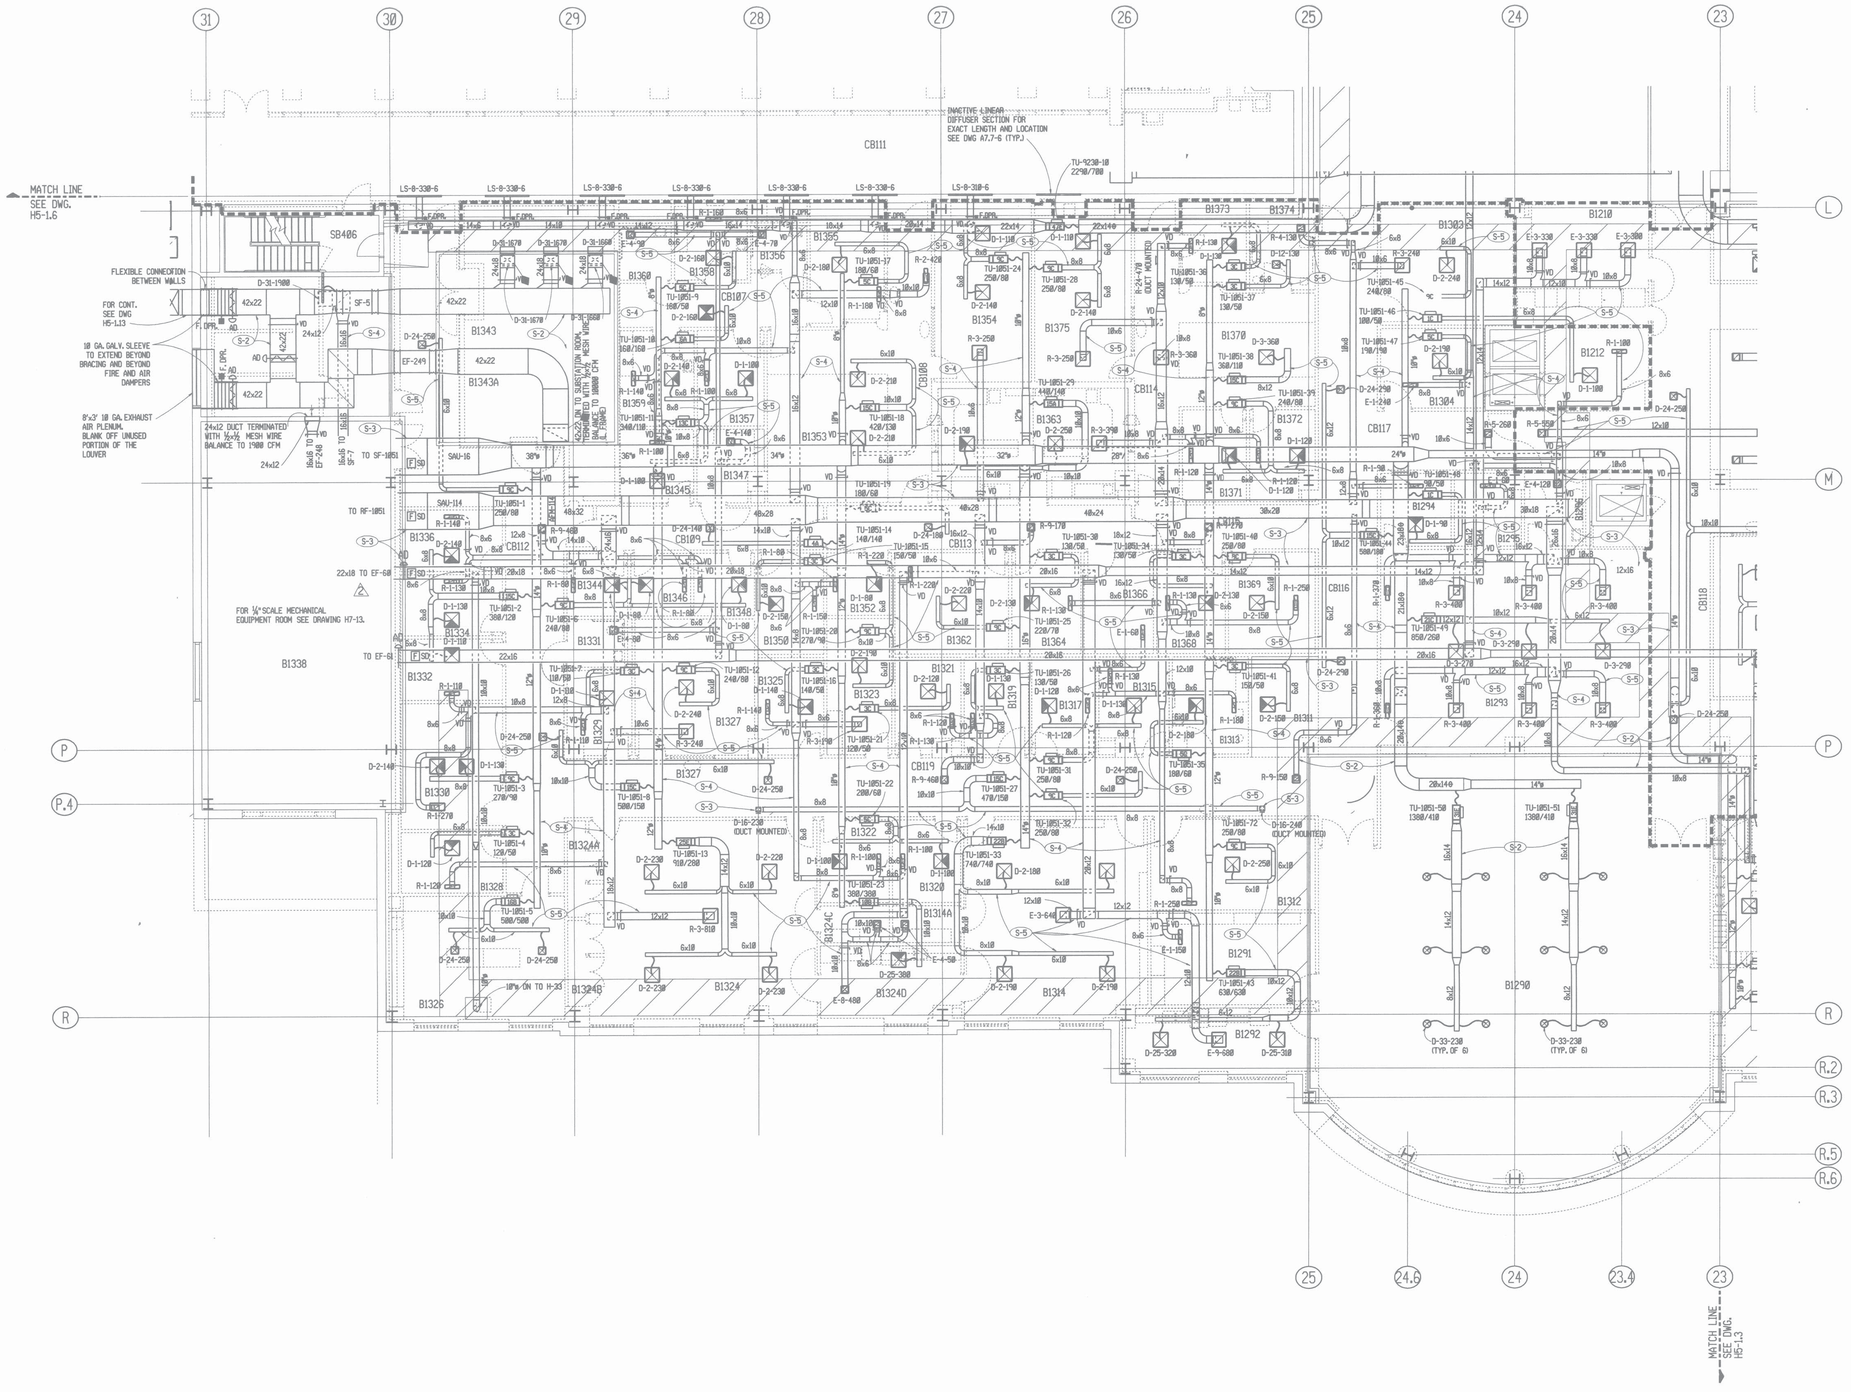

ROOM LEGEND

No.	ROOM NAME
B1210	VENDING
B1212	SPD TERMINAL - CLEAN
B1290	RECREATION - MULTIPURPOSE
B1291	STORAGE - MULTIPURPOSE
B1292	KITCHEN - SERVING PREP.
B1293	ACTIVITY/GAME ROOM
B1294	OFFICE, CLINICAL DIETITIAN
B1295	STORAGE
B1296	TOILET - PATIENT M.
B1303	CONFERENCE - PROFESSIONAL
B1304	SPD TERMINAL - SOILED
B1311	OFFICE, SECRETARY/WAITING
B1312	GROUP THERAPY
B1313	EXAM/TREAT/CONSULT
B1314	ACTIVITY/DINING SPACE
B1314A	STORAGE - ACTIVITIES PROGRAM
B1315	OFFICE, PSYCHIATRIST
B1317	OFFICE, PSYCHOLOGIST
B1319	QUIET ROOM - PATIENT
B1320	OFFICE, OCCUPATIONAL THERAPIST
B1321	OFFICE, PSYHCOLOGIST
B1322	OFFICE, OCCUPATIONAL THERAPIST
B1323	MEDICATION
B1324	ACTIVITY - SOCIAL
B1324A	CLOSET
B1324B	CLOSET
B1324C	STORAGE - ACTIVITY PROGRAM
B1324D	ACTIVITY - KITCHEN
B1325	OFFICE, EDUCATIONAL THERAPIST
B1326	ACTIVITY - EDUCATIONAL THERAPY
B1327	GROUP THERAPY
B1328	OFFICE, PHYSICIAN ASSIST.
B1329	OFFICE, NURSE
B1330	ACTIVITY - QUIET AREA
B1331	TOILET - PATIENT
B1332	OFFICE, PSYCHOLOGIST
B1334	OFFICE, SOCIAL WORKER
B1336	RECEPTIONIST
B1338	MECHANICAL ROOM
B1340	ELECTRICAL ROOM
B1342	ELECTRICAL ROOM
B1343	SUBSTATION
B1343A	ELECTRICAL ROOM
B1344	OFFICE, COUNSELOR - REHAB.
B1345	OFFICE, COUNSELOR - REHAB.
B1346	OFFICE, COUNSELOR - REHAB.
B1347	H. A. C.
B1348	OFFICE, COUNSELOR - REHAB.
B1350	OFFICE, CLECK - STATISTICAL
B1352	OFFICE, COUNSELOR - REHAB.
B1353	WAITING
B1354	CONFERENCE - GROUP THERAPY
B1355	RECEPTION
B1356	TOILET-PATIENT URINE SPECIMEN
B1357	OFFICE, PSYCHOLOGIST
B1358	EXAM/TREAT/CONSULT
B1359	OFFICE, PHYSICIAN
B1360	TOILET - PATIENT
B1362	OFFICE, SECRETARY
B1363	PHARMACY - PREPACKAGING
B1364	OFFICE, COORD.
B1366	STORAGE/UTILITY
B1368	OFFICE, SOCIAL WORKER
B1369	OFFICE, CHIEF - EXAM/TREATMENT
B1370	WAITING
B1371	OFFICE, TECHNICIAN - REHAB.
B1372	OFFICE, TECHNICIAN - REHAB.
B1373	RECEPTION
B1374	EXAM/TREAT/CONSULT
B1375	CONFERENCE - GROUP THERAPY
CB107	CORRIDOR
CB108	CORRIDOR
CB109	CORRIDOR
CB111	CORRIDOR
CB112	CORRIDOR
CB113	CORRIDOR
CB114	CORRIDOR
CB115	CORRIDOR
CB116	CORRIDOR
CB117	CORRIDOR
CB118	CORRIDOR
CB119	CORRIDOR
SB406	STAIR NO. 6

GENERAL NOTES:
ALL MANUAL DAMPERS ON SUPPLY DUCTWORK LOCATED IN DISTRIBUTION ZONE S-4 HAVE NOT BEEN INSTALLED

Revisions	Date
RECORD DRAWINGS	09-15-97
RECORD DRAWINGS	10-11-96
AMENDMENT NO. 2	

FULLY PROTECTED BY AUTOMATIC SPRINKLER SYSTEM

DEPARTMENTS – THIS DRAWING:

00202 DRUG DEPENDENCE TREATMENT CLINIC
00260 OUTPATIENT PSYCHIATRIC – DAY TREATMENT
00288 PHARMACY SERVICE
00269 RECREATION SERVICE
00300 DAY HOSPITAL
08000 ALCOHOL DEPENDENCE TREATMENT CLINIC

SH&G Project No. 4999L

SH&G
Smith, Hinchman & Grylls Associates, Inc.
Architects Engineers Planners
150 West Jefferson, Suite 100
Detroit, Michigan 48226
313/983-3600

STATE OF MICHIGAN THEODORE M. SUTHERLAND REGISTERED ARCHITECT NO. 22953

Key Plan

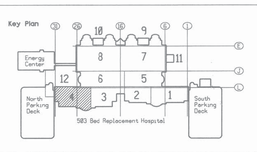

Building North

Drawing Title: FIRST FLOOR PLAN ZONE 4 - HVAC
Scale: 1/8"=1'-0"
Approved: Area Project Manager
J. P. Idzinak

Project Title: 503 BED REPLACEMENT HOSPITAL
Building Number: 100
Location: Detroit, Michigan
Checked:
Drawn: SMS

Date: 7-1-91
Project No.: 553-080
DRAWING NO.: H5-1.4R
Dwg. Of

Veterans Administration

PLOT FILE: /usr/cglagin/parms/valhv4.dgn 17-SEP-1997 14:53

three inches = one foot
one and one-half inches = one foot
one inch = one foot
three-quarters inch = one foot
one-half inch = one foot
three-eighths inch = one foot
one-quarter inch = one foot
one-eighth inch = one foot