REVISIONS				
LET	DESCRIPTION	PREP'D BY	DATE	APPROVED
REV. A	AS-BUILT DRWG. NO CORRECTIONS	GREG	4OCT82	MURDOCK

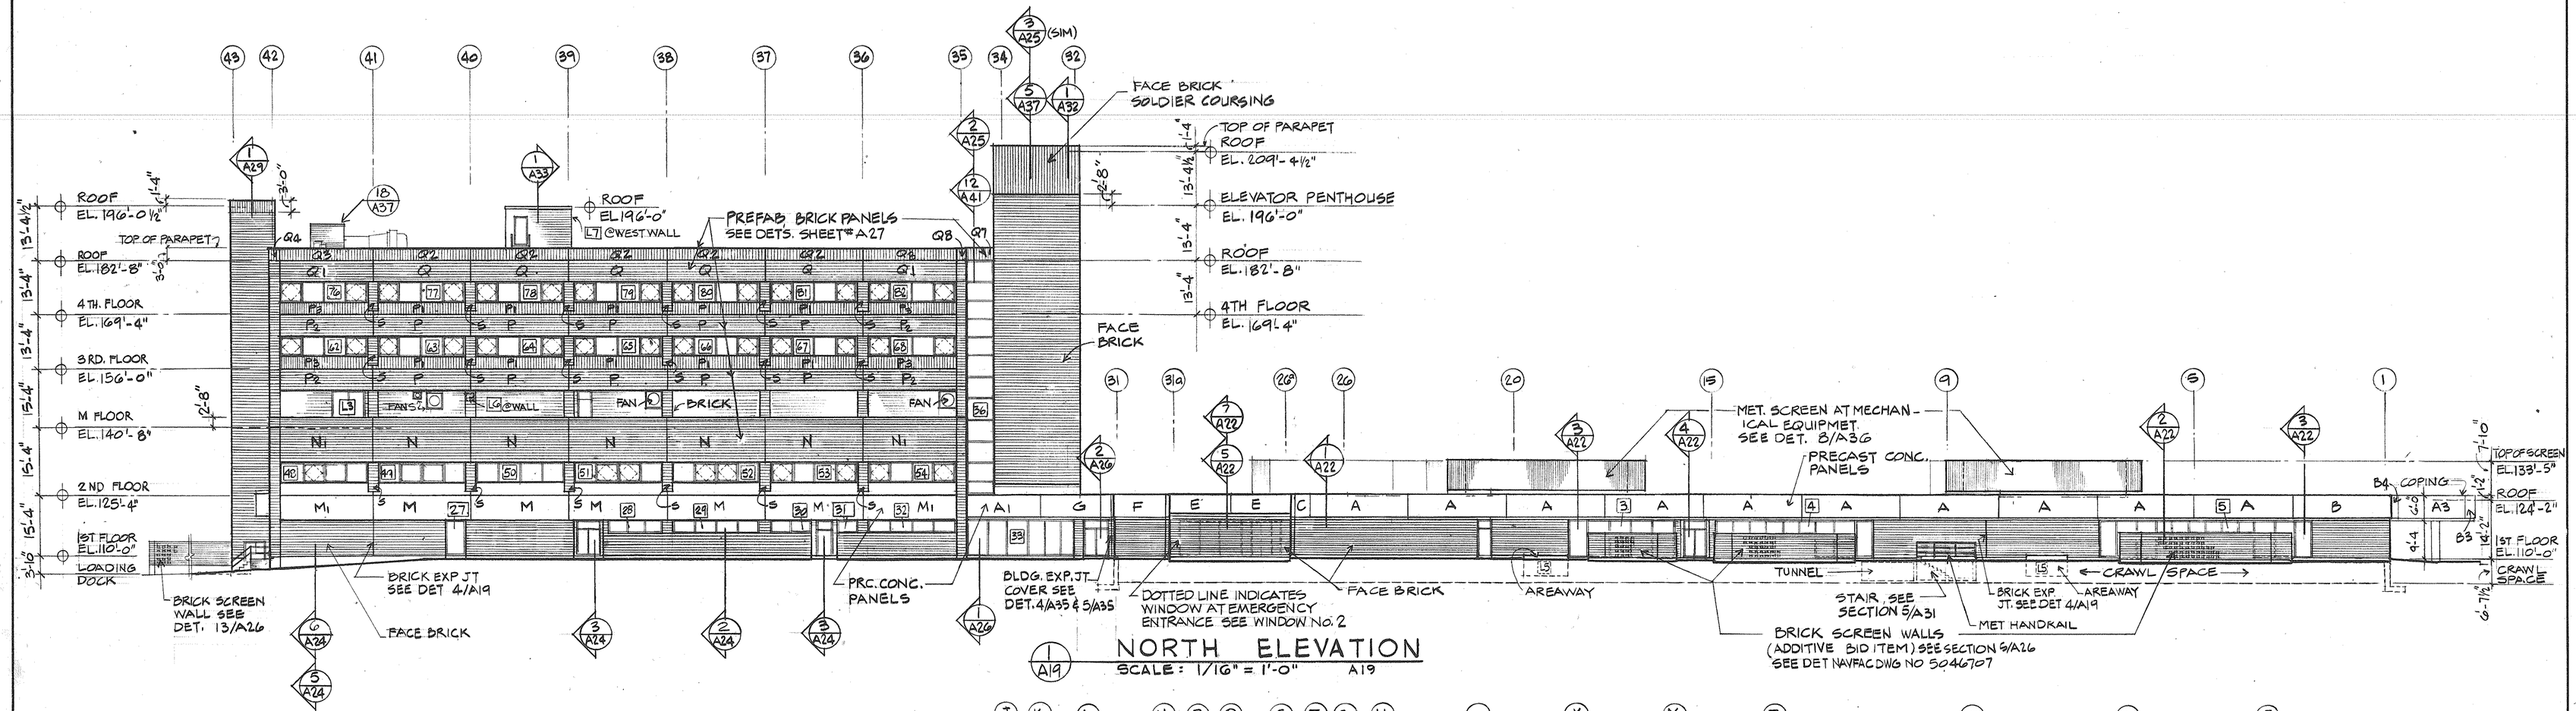

1/A19 NORTH ELEVATION
SCALE: 1/16" = 1'-0" A19

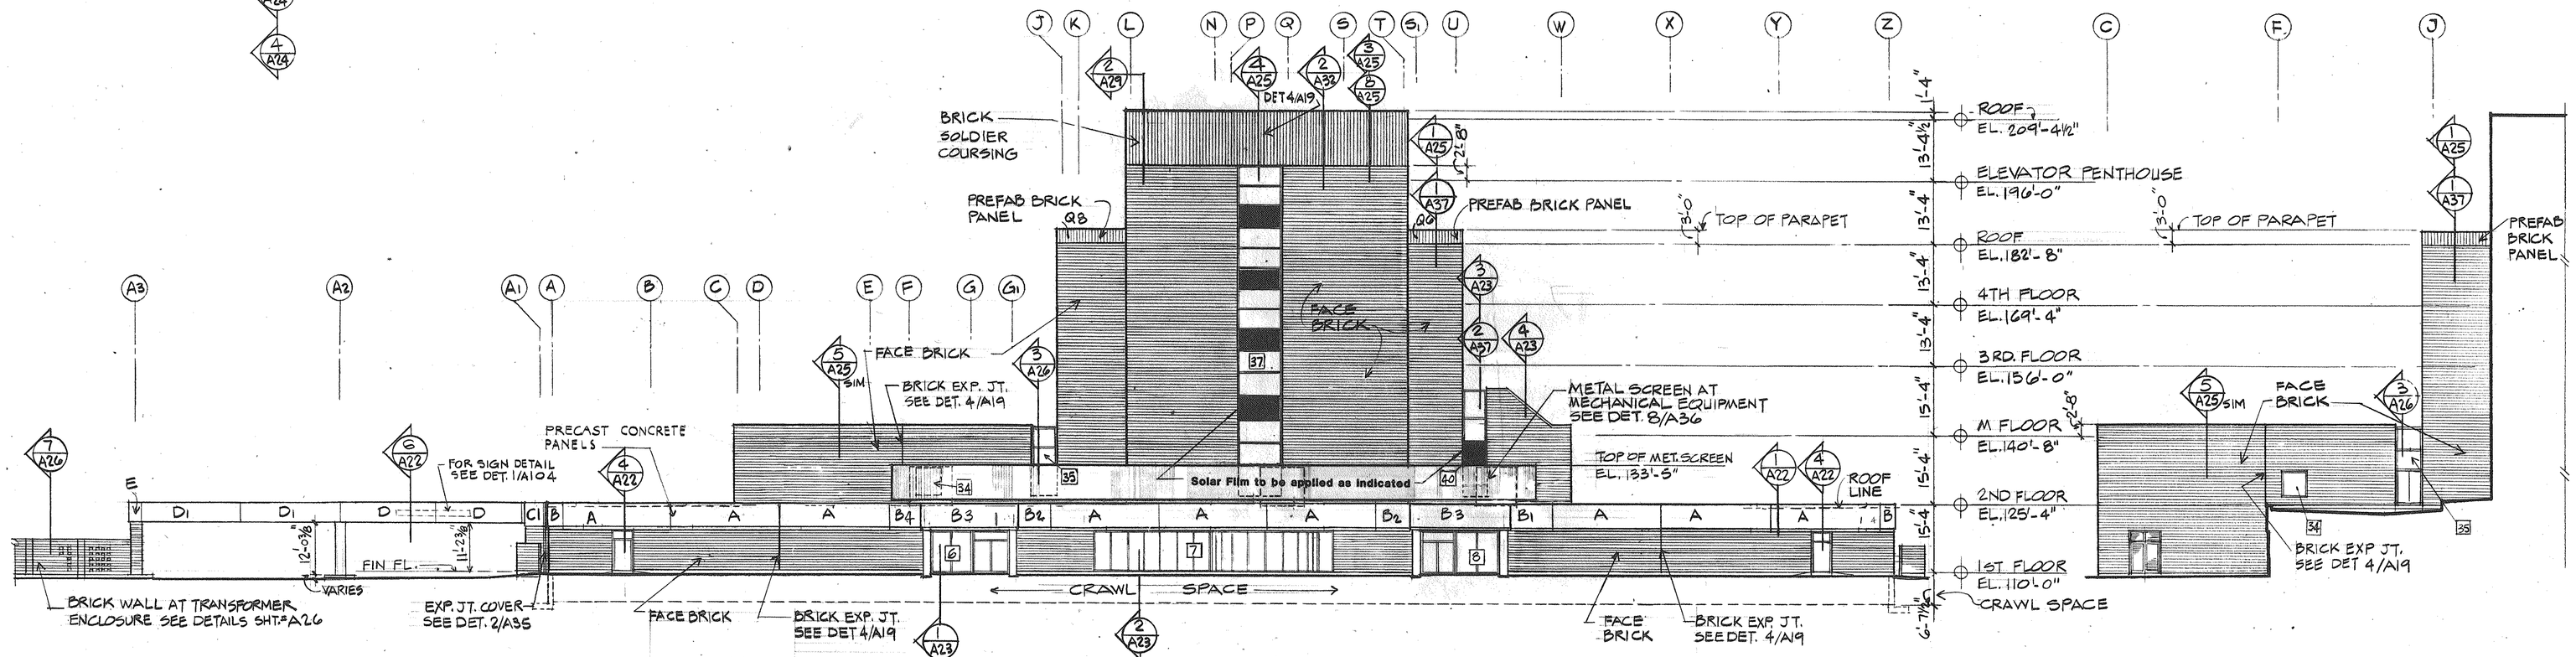

2/A19 WEST ELEVATION
SCALE: 1/16" = 1'-0" A19

3/A19 PARTIAL ELEVATION
SCALE 1/16" = 1'-0" A19

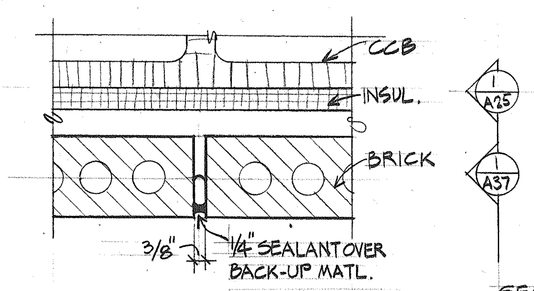

4/A19 DETAIL
SCALE 3" = 1'-0" A19, A20, A21

UPPER REFERENCE IS SECTION AT UPPER PART OF WALL.

LOWER REFERENCE IS SECTION AT LOWER PART OF WALL

SECTION REFERENCE LEGEND

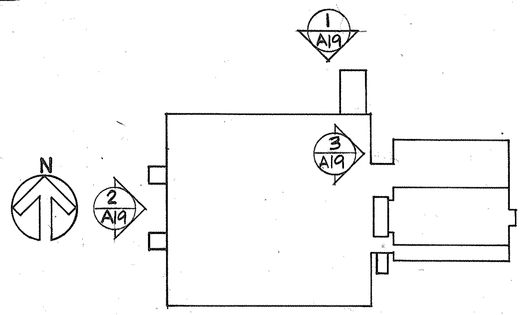

KEY PLAN

GRAPHIC SCALES
1/16" = 1'-0" 8' 0 10' 20' 30' 40'

RECORD DRAWING
DATE 11-1-82

NOTE:
ONLY WORK REQUIRED UNDER CONTRACT N62467-81-C-2516, WORK ORDER NO. 11, DEC. 1981, ARE THE INDICATED SOLAR FILM FOR THE WINDOWS

ROGERS, LOVELOCK, FRITZ, ROGERS & BUTLER
LOPATKA, McQUAIG & WALL CORPORATION
ARCHITECTS - ENGINEERS - PLANNERS
WINTER PARK, FLORIDA 32789

DEPARTMENT OF THE NAVY NAVAL FACILITIES ENGINEERING COMMAND
SOUTHERN DIVISION
CHARLESTON, S. C.

NAVAL REGIONAL MEDICAL CENTER ORLANDO, FLORIDA

HOSPITAL REPLACEMENT

EXTERIOR ELEVATIONS SHEET 1 OF 2

DSGN JAMMAL DR JAMMAL CHK MURDOCK
SUPV MURDOCK CH ENGR MARTEN
SUBMITTED BY 28 FEB 77
FIRM MEMBER (TITLE) PARTNER
SOUTHERN DIV - DESIGN DIVISION
PDE DIR

APPROVED DATE
OFFICER IN CHARGE
APPROVED DATE
EFD FOR COMMANDER, NAVFAC

A19

SIZE	CODE IDENT NO.	NAVFAC DRAWING NO.
F	80091	5046700
SCALE 1/16" = 1'-0"		CONSTR CONTR NO. N62467-75-C-0340
		SPEC 06-75-0340 SHEET 109 OF

K&E 19 1183 10-75 W3259* END-SOUTH DIV-4-11012-15 CAROLINA EAF P452