VERIFY ALL BEAM SIZES, ELEVATIONS WITH STRUCTURAL DRAWINGS.

REVISIONS				
LET	DESCRIPTION	PREP'D BY	DATE	APPROVED
REV. A	AS-BUILT DRWG. NO CORRECTIONS	GREG	4OCT82	MURDOCK

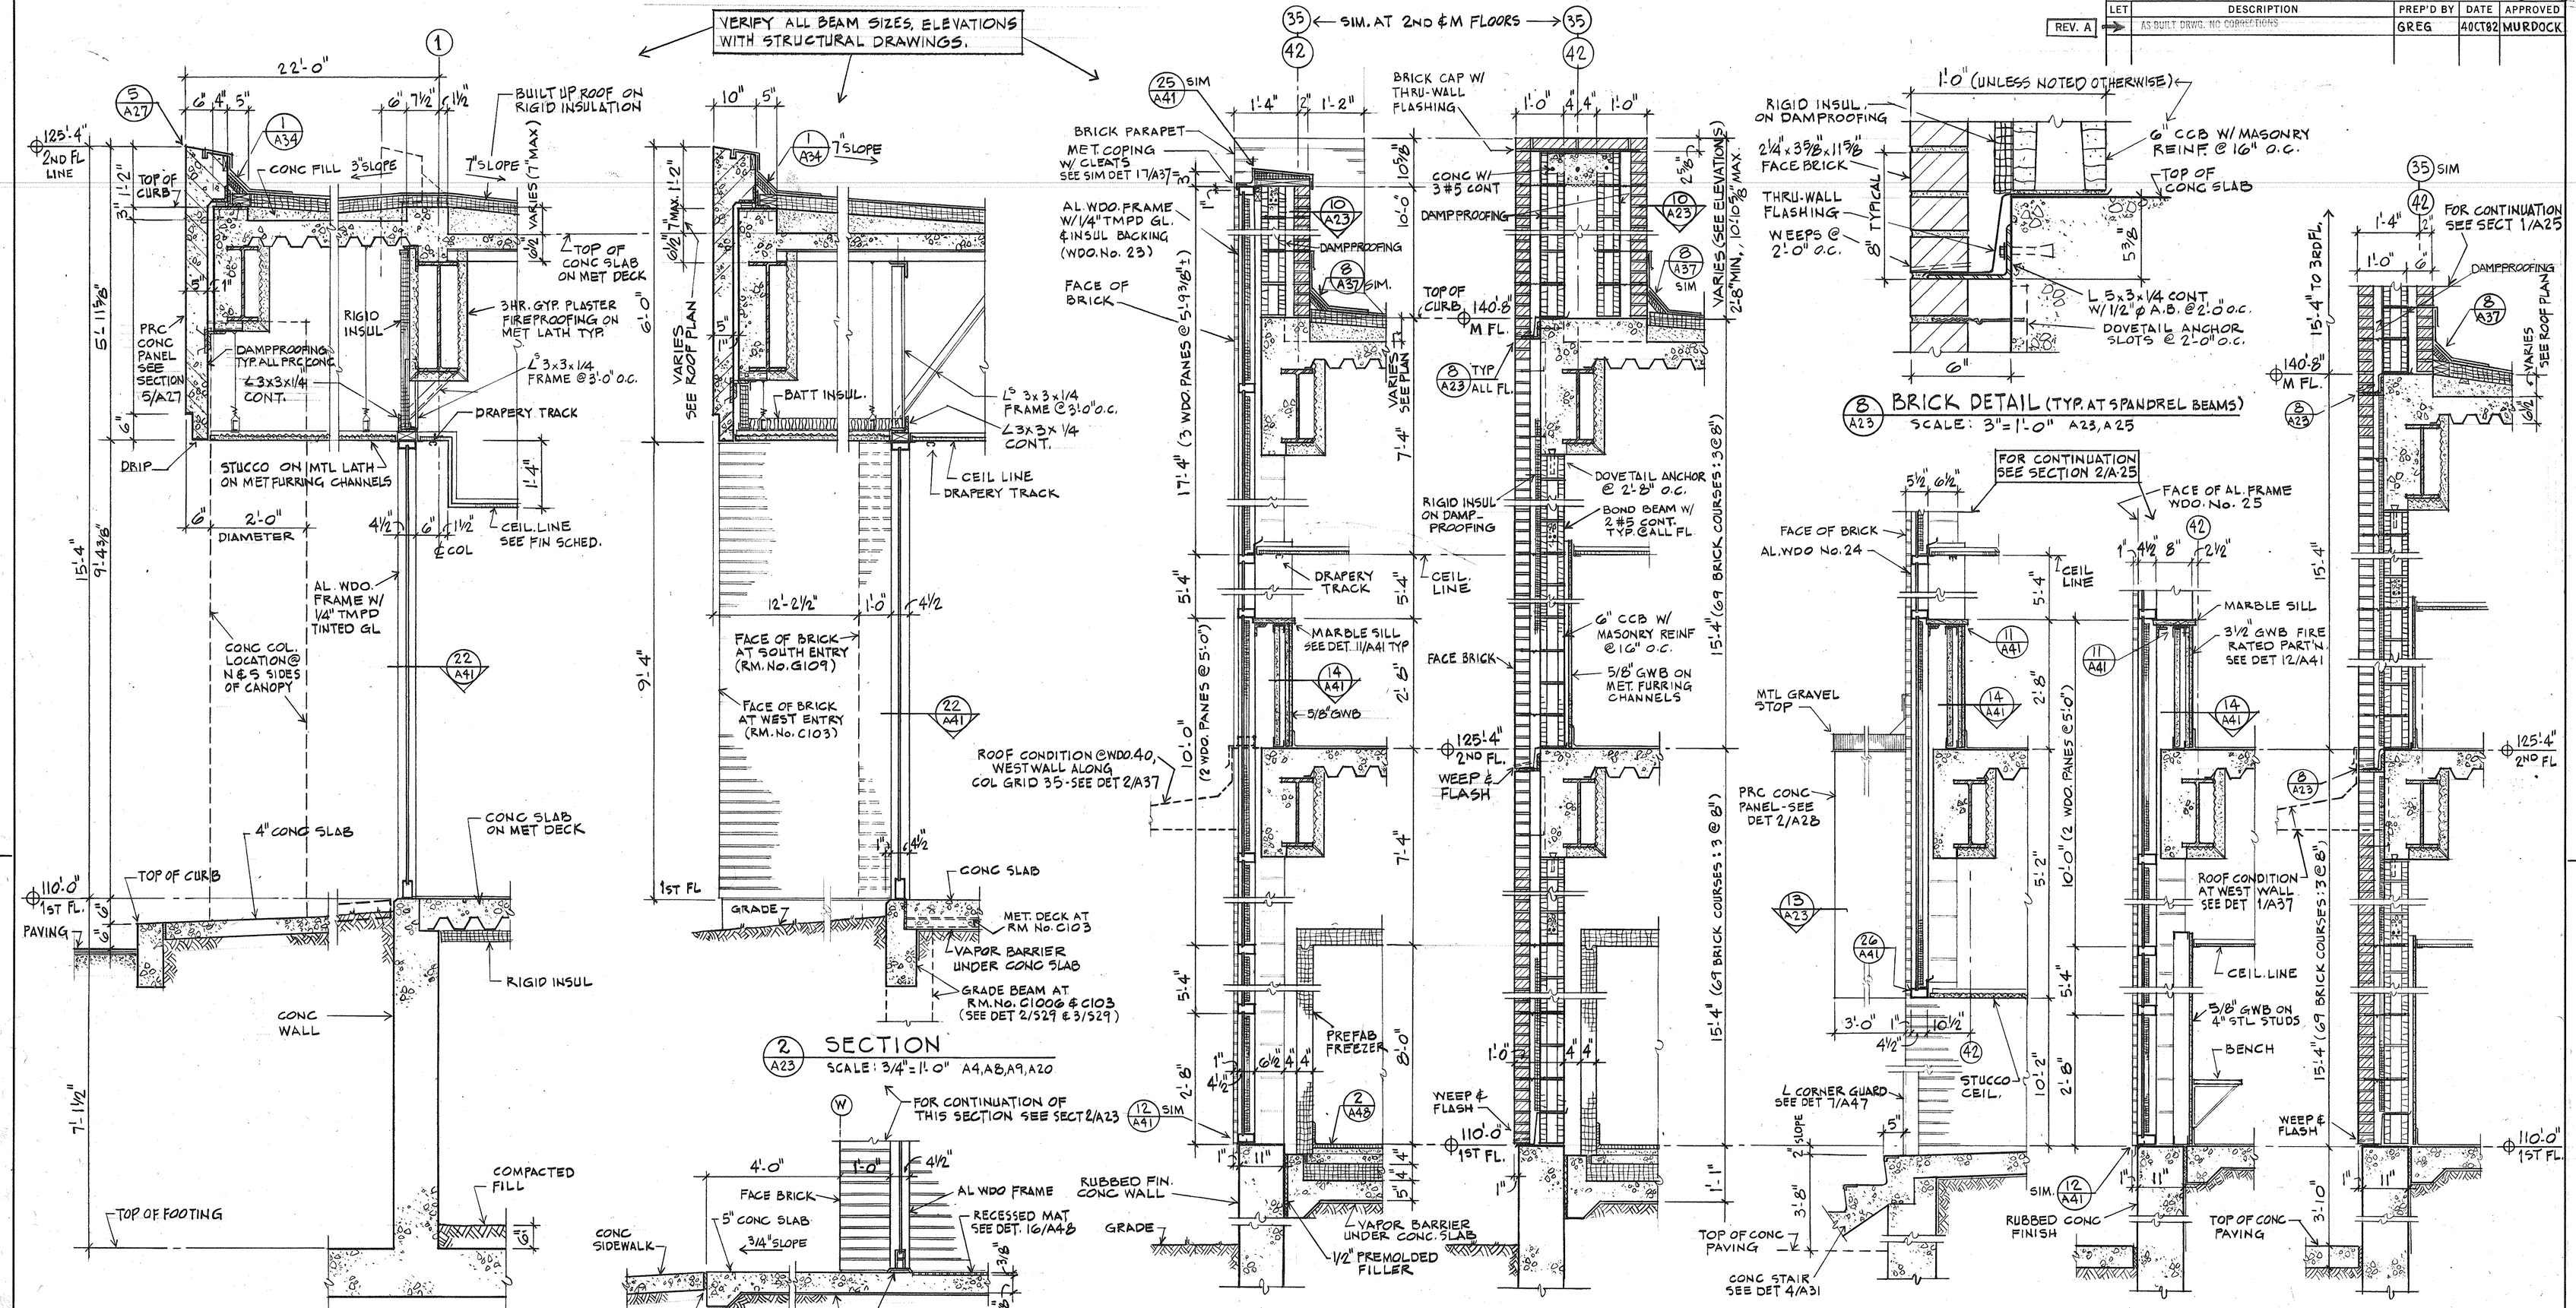

NOTE: SEE WALL SECTION 1/A23 FOR TYPICAL NOTES.

RECORD DRAWING DATE 11-1-82

GRAPHIC SCALES
3/4" = 1'-0" 12" 0 1' 2' 3'
3" = 1'-0" 6" 0 6"

ROGERS, LOVELOCK, FRITZ, ROGERS & BUTLER
LOPATKA, McQUAIG & WALL CORPORATION
ARCHITECTS - ENGINEERS - PLANNERS
WINTER PARK, FLORIDA 32789

DEPARTMENT OF THE NAVY — NAVAL FACILITIES ENGINEERING COMMAND
SOUTHERN DIVISION
CHARLESTON, S. C.

DSGN GARCIA/GARCIA CHK MURDOCK
SUPV MURDOCK CH ENGR MARTEN
SUBMITTED BY: DATE 28 FEB 77
FIRM MEMBER (TITLE) PARTNER
SOUTHERN DIV — DESIGN DIVISION
PDE DIR

NAVAL REGIONAL MEDICAL CENTER — ORLANDO, FLORIDA

HOSPITAL REPLACEMENT

WALL SECTIONS - SHEET 2 OF 5

A23

APPROVED DATE
OFFICER IN CHARGE
APPROVED DATE
EFD FOR COMMANDER, NAVFAC

SIZE	CODE IDENT NO.	NAVFAC DRAWING NO.
F	80091	5046704
SCALE AS SHOWN		CONSTR CONTR NO. N62467-75-C-0340
		SPEC 06-75-0340 SHEET 113 OF

K&E 18 1133 5-73 2830+ 6ND-SOUTH DIV-4-11012-13 CAROLINA E&P