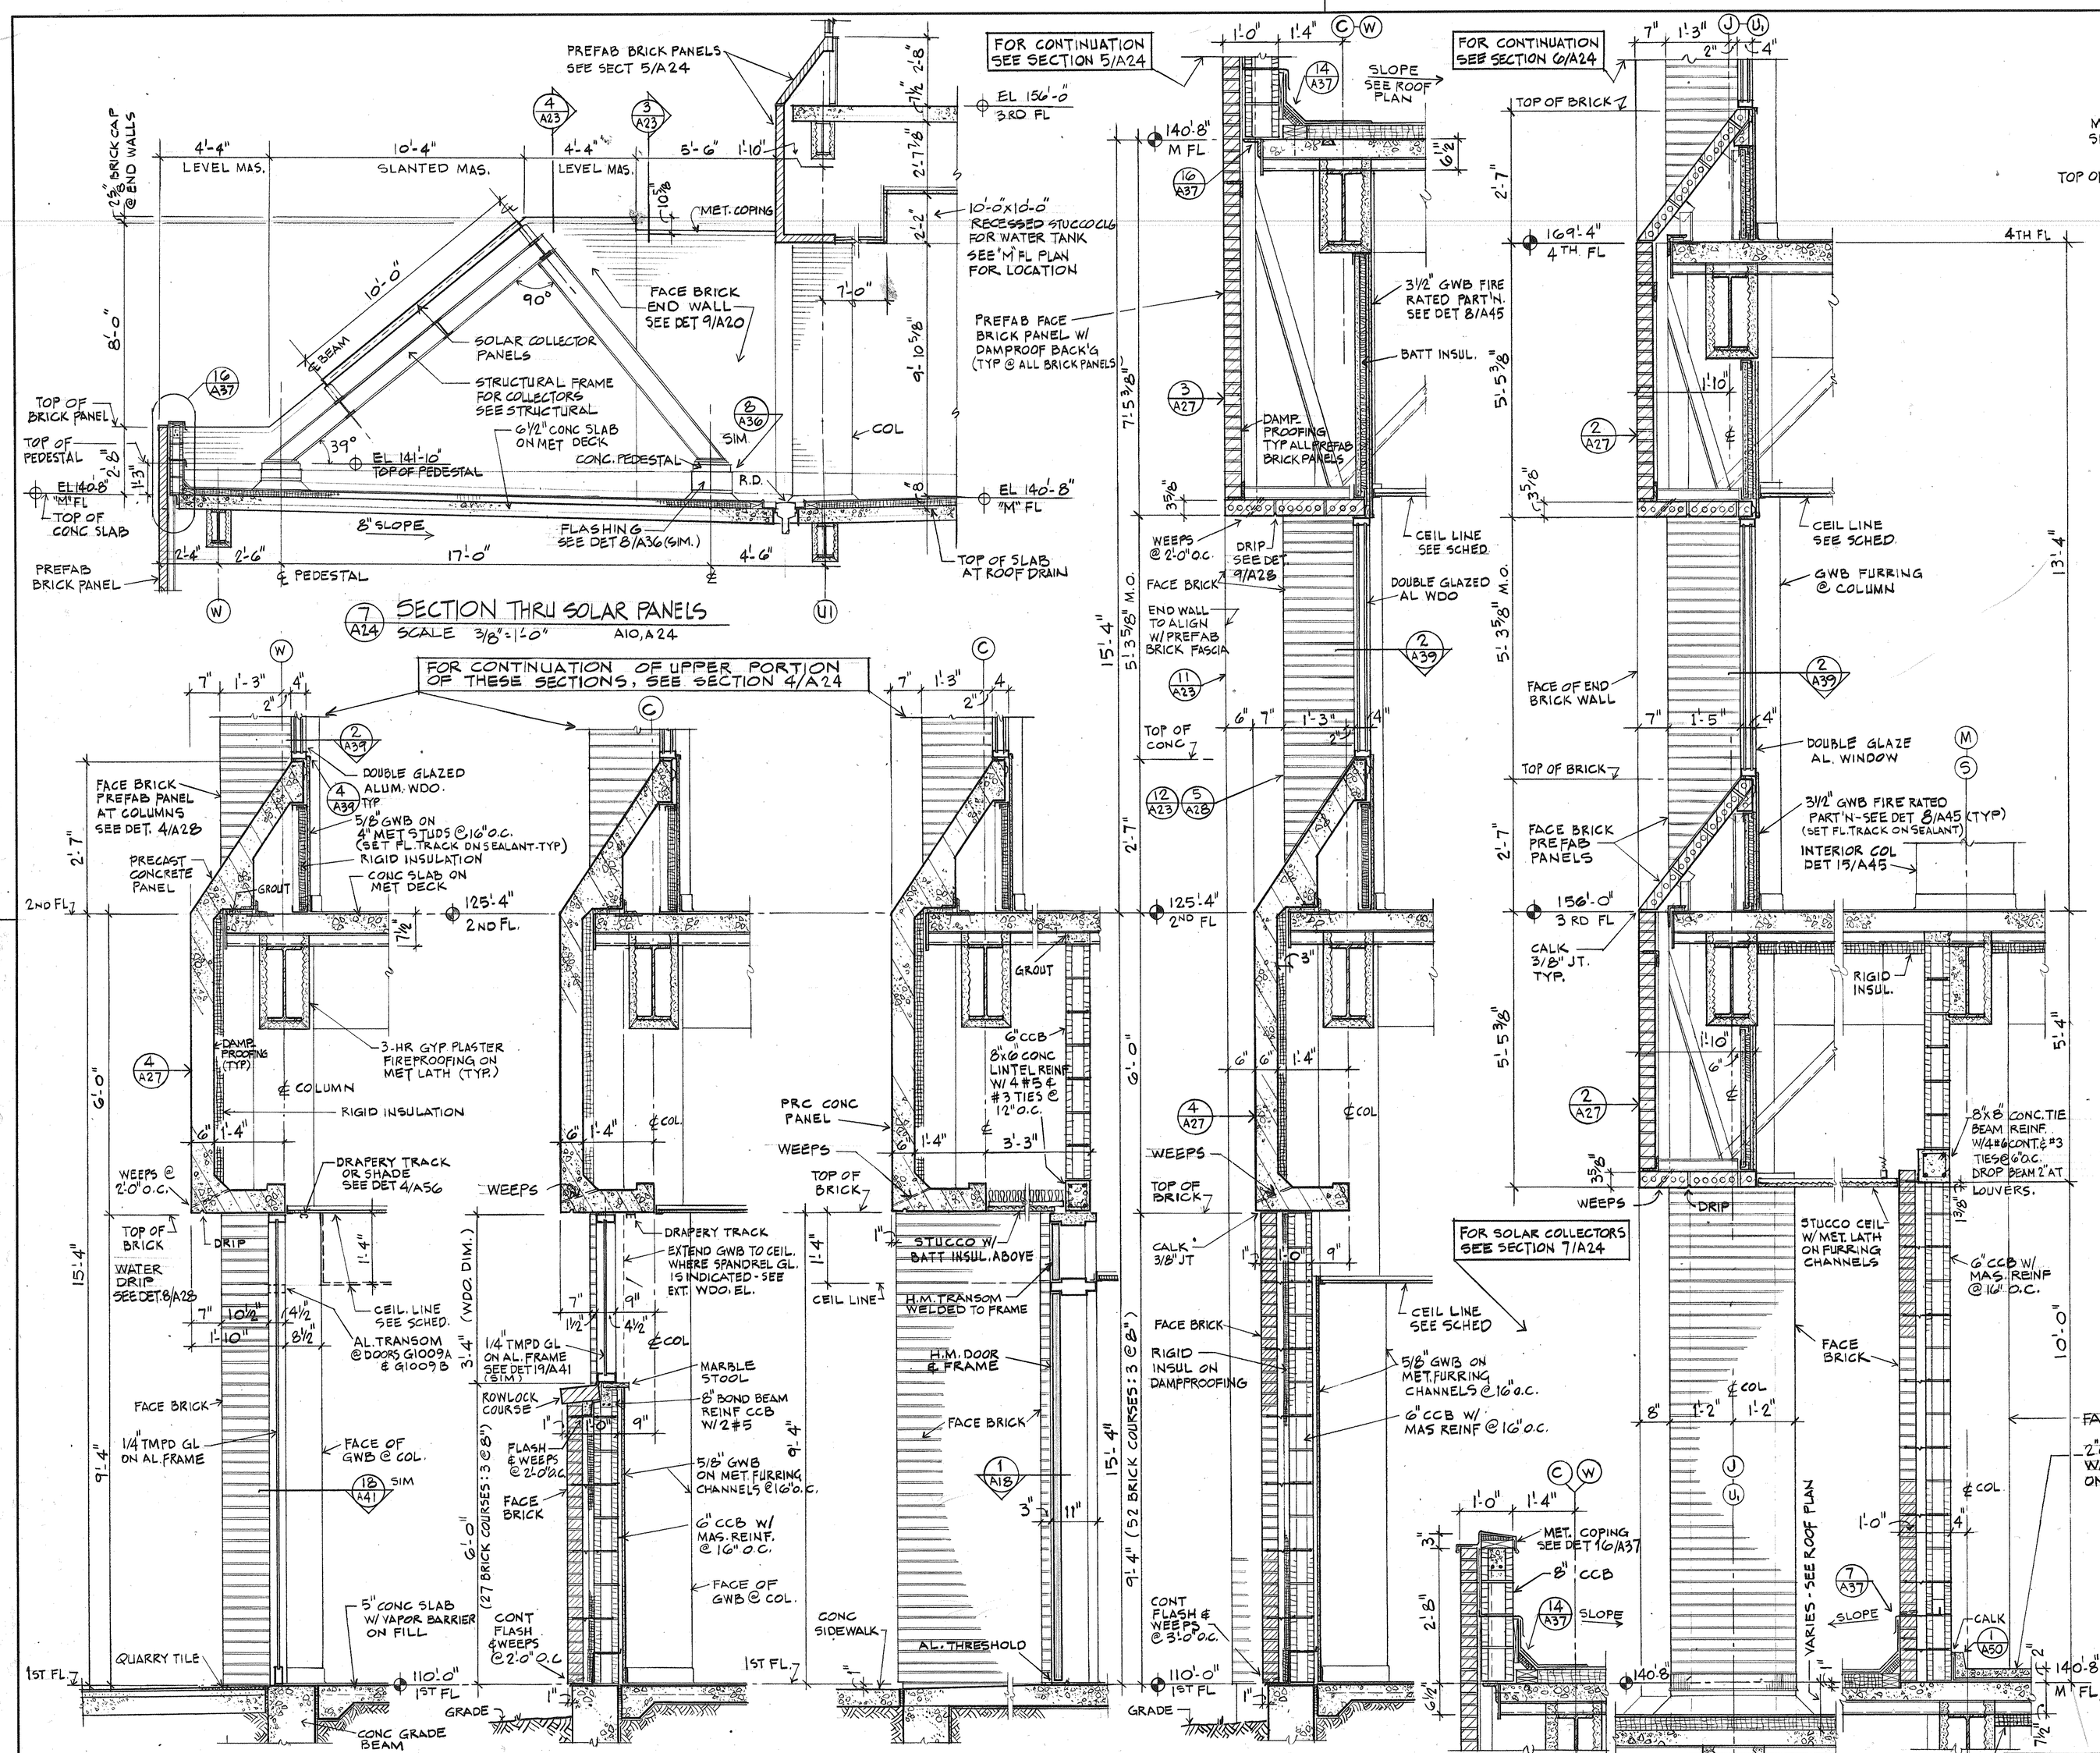

REVISIONS				
LET	DESCRIPTION	PREP'D BY	DATE	APPROVED
REV A	AS BUILT DRWG. NO CORRECTIONS	RAY	4 OCT 84	MURDOCK

GRAPHIC SCALES

3/8" = 1'-0" 12" 0 1' 2' 3' 4' 5' 6' 7'

3/4" = 1'-0" 12" 0 1' 2' 3'

RECORD DRAWING DATE 11-1-82

ROGERS, LOVELOCK, FRITZ, ROGERS & BUTLER
LOPATKA, McQUAIG & WALL CORPORATION
ARCHITECTS - ENGINEERS - PLANNERS
WINTER PARK, FLORIDA 32789

DEPARTMENT OF THE NAVY — NAVAL FACILITIES ENGINEERING COMMAND
SOUTHERN DIVISION
CHARLESTON, S. C.

NAVAL REGIONAL MEDICAL CENTER — ORLANDO, FLORIDA

HOSPITAL REPLACEMENT

WALL SECTIONS - SHEET 3 OF 5

DSGN GARCIA DR JAMMALCHK MURDOCK
SUPV MURDOCK CH ENGR MARTIN
SUBMITTED DATE 28 FEB 77
FIRM MEMBER (TITLE) PARTNER
SOUTHERN DIV — DESIGN DIVISION
PDE DIR.
APPROVED DATE
OFFICER IN CHARGE
APPROVED DATE
EFD FOR COMMANDER, NAVFAC

A24

SIZE	CODE IDENT NO.	NAVFAC DRAWING NO.
F	80091	5046705
SCALE AS SHOWN		CONSTR CONTR NO. N62467-75-C-0340
		SPEC 06-75-0340 SHEET 114 OF

K&E 19 1153 10-75 W3059* 6ND-SOUTH DIV-4-11012-13 CAROLINA E&F P452