REVISIONS				
LET	DESCRIPTION	PREP'D BY	DATE	APPROVED
REV. A	AS-BUILT DRWG: NO CORRECTIONS	GREG	4OCT82	MURDOCK

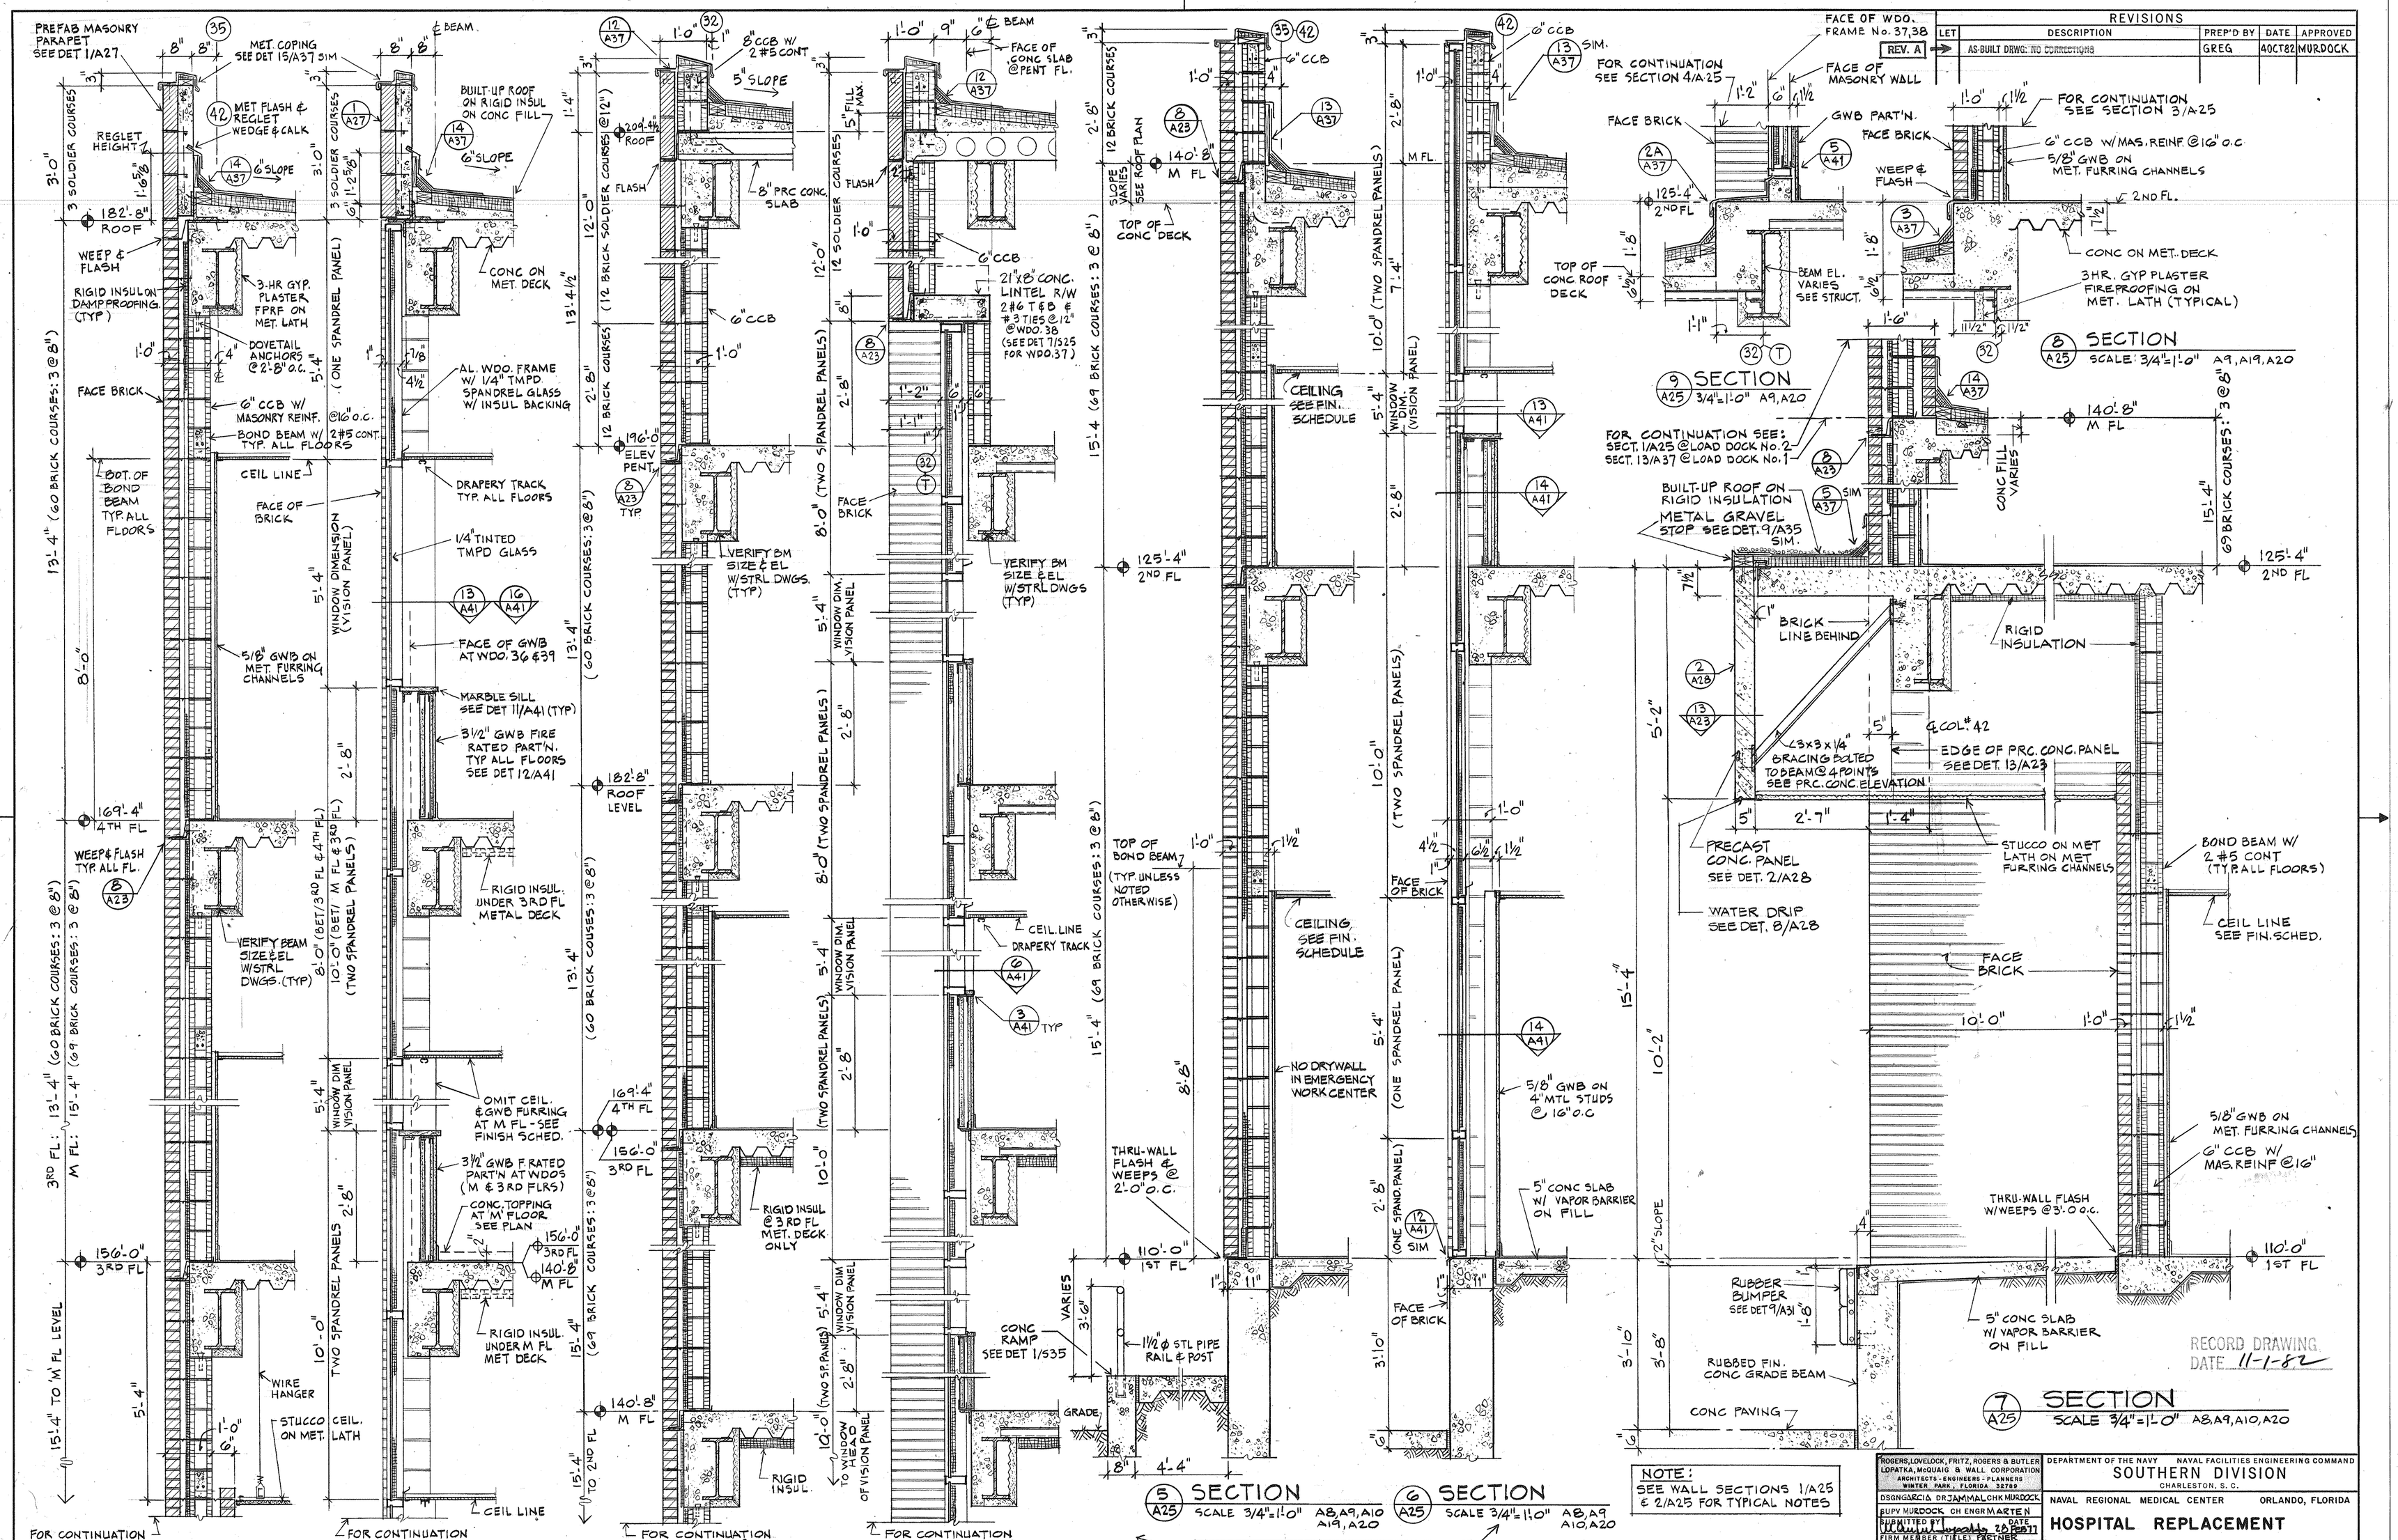

ROGERS, LOVELOCK, FRITZ, ROGERS & BUTLER
LOPATKA, McQUAIG & WALL CORPORATION
ARCHITECTS - ENGINEERS - PLANNERS
WINTER PARK, FLORIDA 32789

DSGN GARCIA DR JAMMAL CHK MURDOCK
SUPV MURDOCK CH ENGR MARTEN
SUBMITTED BY DATE
FIRM MEMBER (TIELE) PETNER
SOUTHERN DIV — DESIGN DIVISION
PDE DIR

DEPARTMENT OF THE NAVY — NAVAL FACILITIES ENGINEERING COMMAND
SOUTHERN DIVISION
CHARLESTON, S. C.

NAVAL REGIONAL MEDICAL CENTER — ORLANDO, FLORIDA

HOSPITAL REPLACEMENT

WALL SECTIONS - SHEET 4 OF 5

APPROVED — DATE
OFFICER IN CHARGE
APPROVED — DATE
EFD FOR COMMANDER, NAVFAC

A25

SIZE	CODE IDENT NO.	NAVFAC DRAWING NO.
F	80091	5046706

CONSTR CONTR NO. N62467-75-C-0340

SCALE 3/4" = 1'-0" | SPEC 06-75-0340 | SHEET 115 OF

K&E 19 1153 10-75 W3250+ 6ND-SOUTH DIV-4-11012-15 CAROLINA E&F P452