REVISIONS				
LET	DESCRIPTION	PREP'D BY	DATE	APPROVED
REV. A	AS BUILT DRWG. NO CORRECTIONS	GREG	4OCT82	MURDOCK

NOTE:
SG: DENOTES SPANDREL GLASS

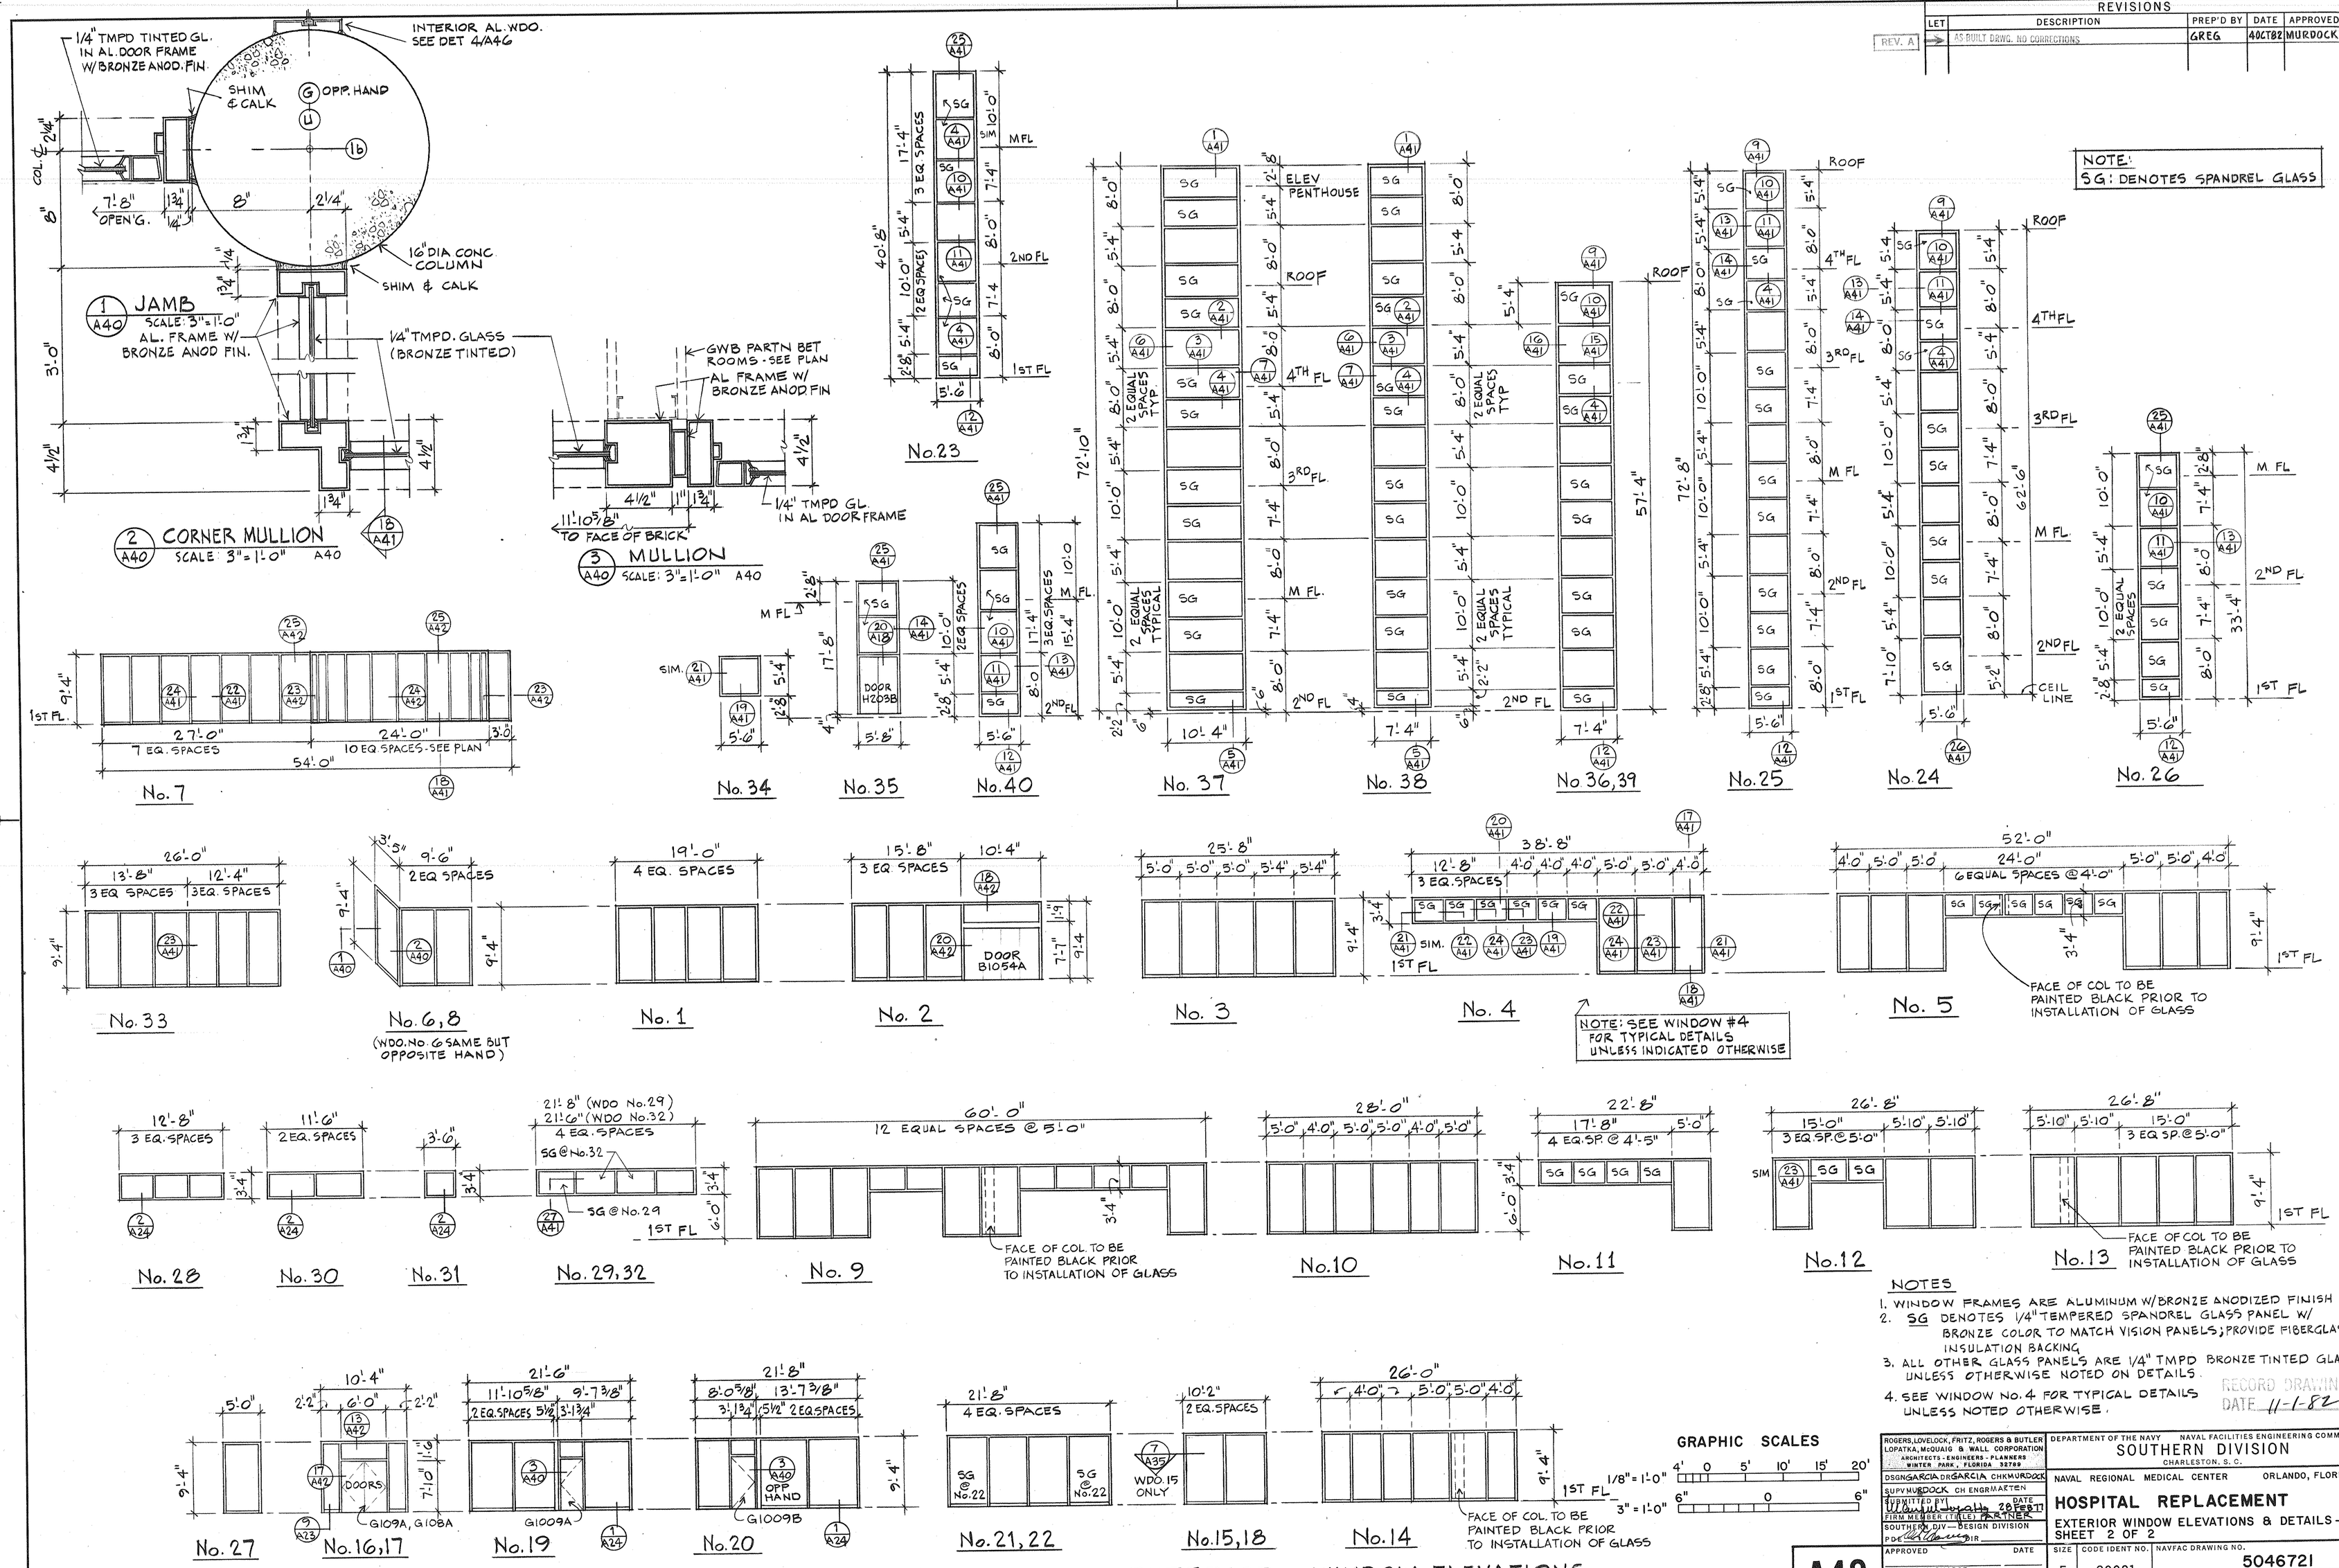

EXTERIOR WINDOW ELEVATIONS
SCALE: 1/8" = 1'-0" A19, A20

NOTES
1. WINDOW FRAMES ARE ALUMINUM W/BRONZE ANODIZED FINISH
2. SG DENOTES 1/4" TEMPERED SPANDREL GLASS PANEL W/ BRONZE COLOR TO MATCH VISION PANELS; PROVIDE FIBERGLASS INSULATION BACKING
3. ALL OTHER GLASS PANELS ARE 1/4" TMPD BRONZE TINTED GLASS UNLESS OTHERWISE NOTED ON DETAILS.
4. SEE WINDOW No. 4 FOR TYPICAL DETAILS UNLESS NOTED OTHERWISE.

RECORD DRAWING DATE 11-1-82

ROGERS, LOVELOCK, FRITZ, ROGERS & BUTLER
LOPATKA, McQUAIG & WALL CORPORATION
ARCHITECTS - ENGINEERS - PLANNERS
WINTER PARK, FLORIDA 32789
DSGN GARCIA DR GARCIA CHKMURDOCK
SUPV MURDOCK CH ENGR MARTEN
SUBMITTED BY [signature] DATE 28 FEB 77
FIRM MEMBER (TITLE) PARTNER
SOUTHERN DIV — DESIGN DIVISION
PDE [signature] DIR
APPROVED DATE
OFFICER IN CHARGE
APPROVED [signature] DATE
EFD FOR COMMANDER, NAVFAC

DEPARTMENT OF THE NAVY NAVAL FACILITIES ENGINEERING COMMAND
SOUTHERN DIVISION
CHARLESTON, S. C.
NAVAL REGIONAL MEDICAL CENTER ORLANDO, FLORIDA

HOSPITAL REPLACEMENT
EXTERIOR WINDOW ELEVATIONS & DETAILS - SHEET 2 OF 2

A40

SIZE	CODE IDENT NO.	NAVFAC DRAWING NO.
F	80091	5046721
SCALE AS SHOWN		CONSTR CONTR NO. N62467-75-C-0340
		SPEC 06-75-0340 SHEET 130 OF

K&E 19 1153 10-75 W3256* 6ND-SOUTH DIV-6-11012-15 CAROLINA E&F P452