REVISIONS				
LET	DESCRIPTION	PREP'D BY	DATE	APPROVED
REV. A	AS-BUILT DRWG. NO CORRECTIONS	GREG	4OCT82	MURDOCK

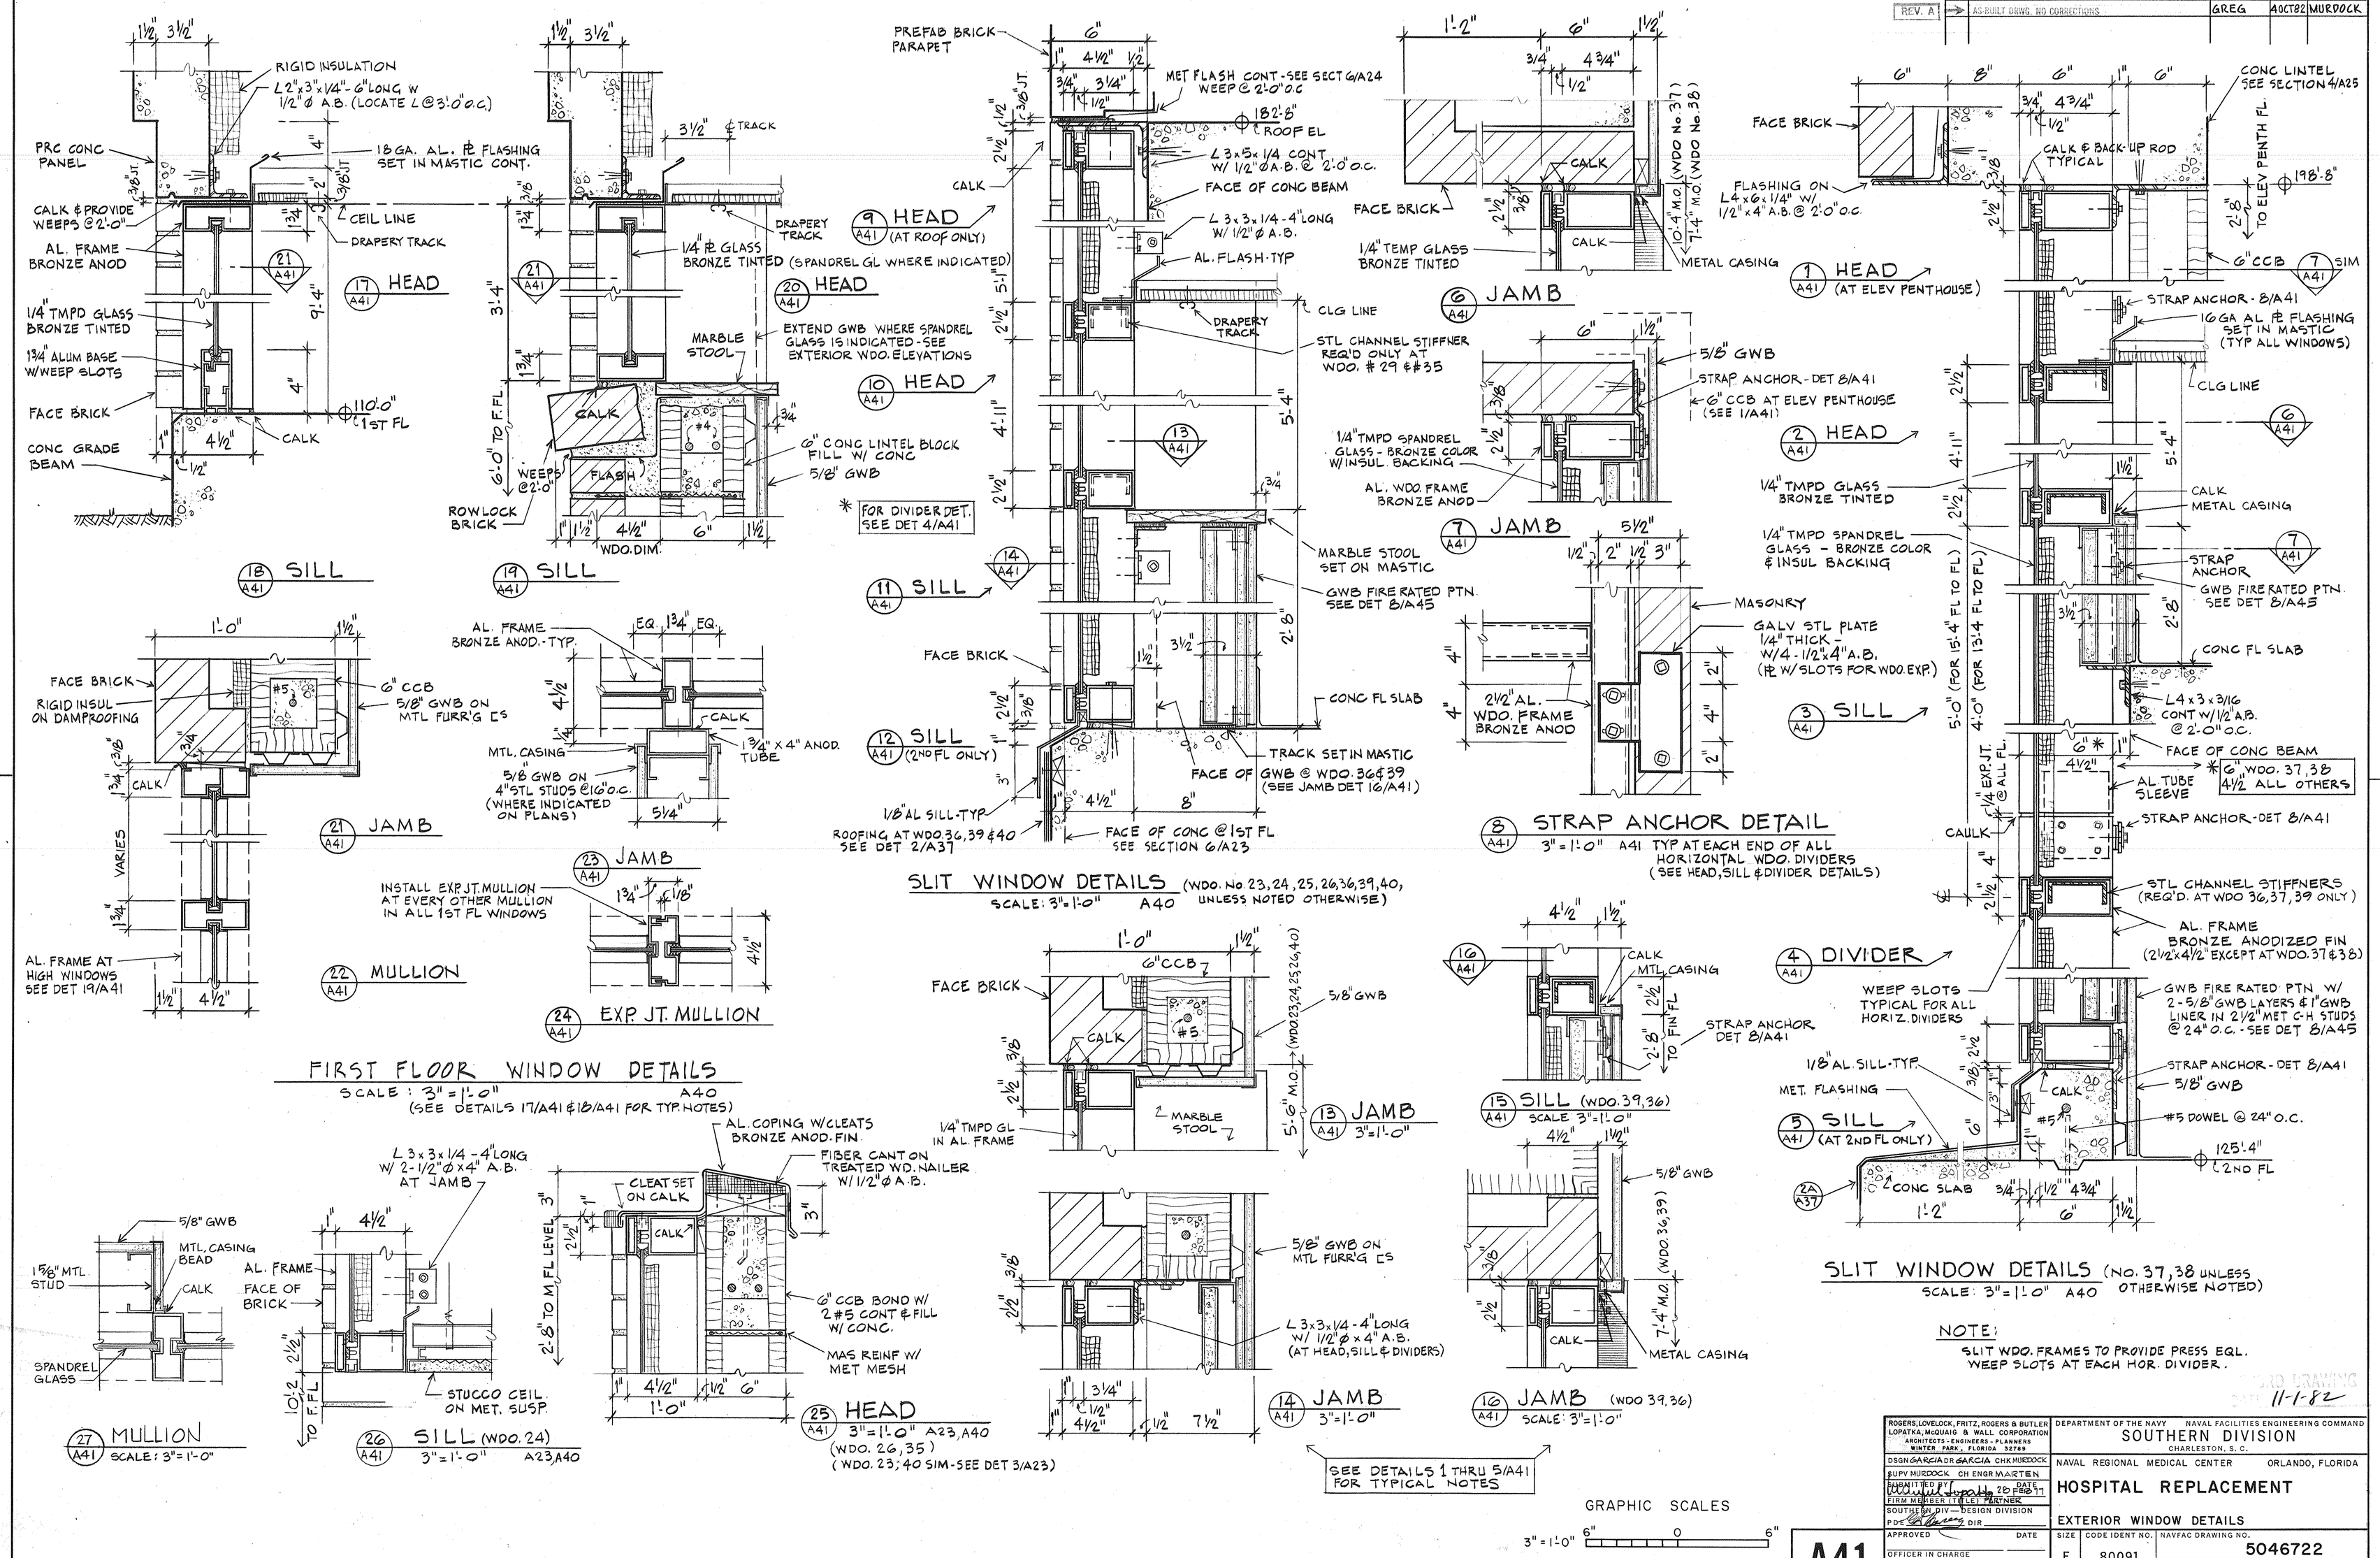

K&E 19 1153 10-75 W3258* 6ND-SOUTH DIV-4-11012-15 CAROLINA E&P P452