


CONCRETE FOOTING,
SEE PLAN AND
SCHEDULE _____

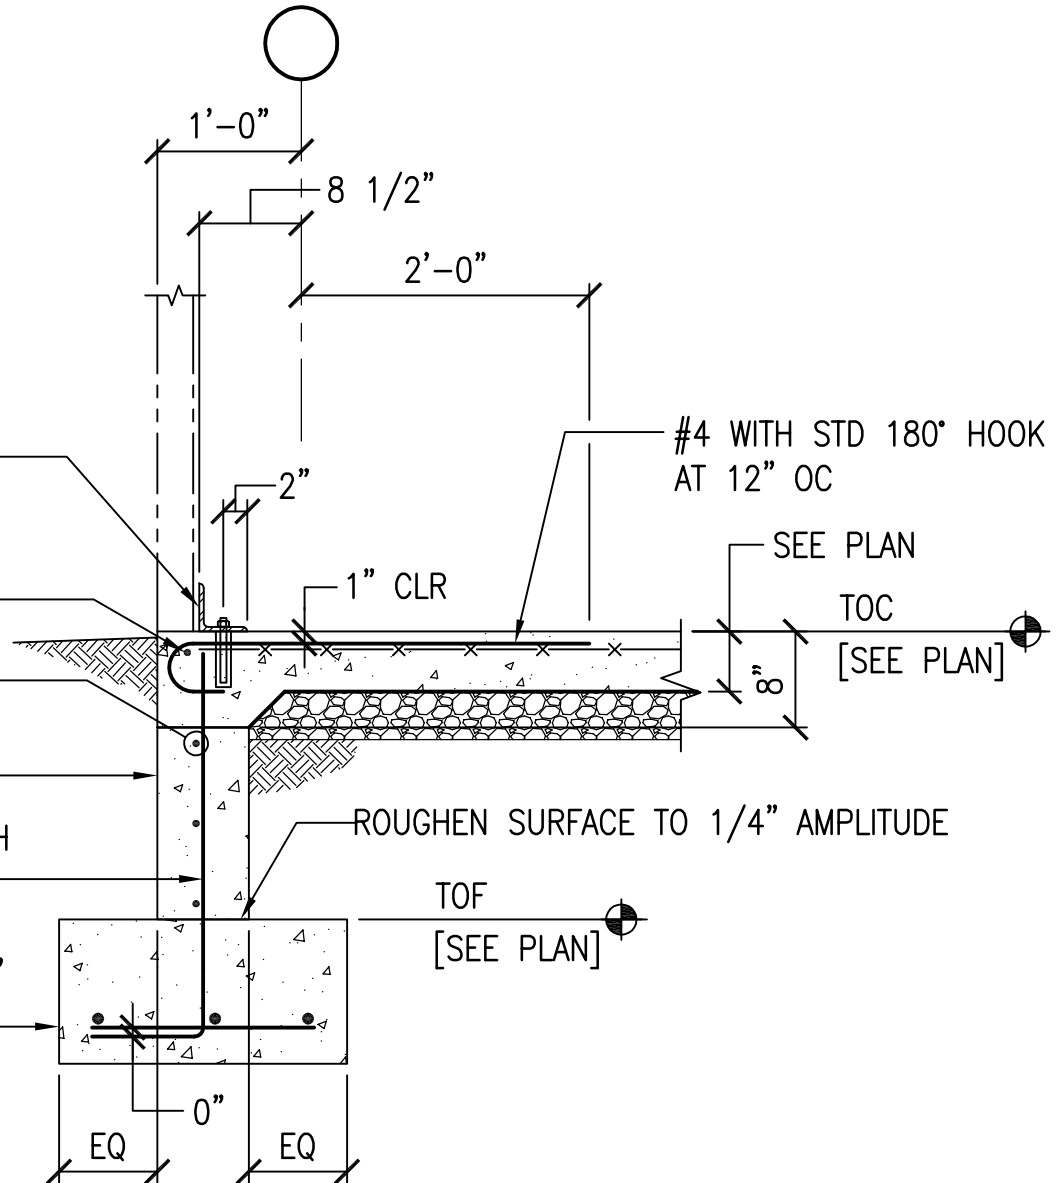

E6
SECTION
SB101 SCALE: 3/4" = 1'-0"

SCALE: $3/4" = 1'-0"$

$$3/4'' = 1'-0''$$


JOB TITLE:

INCREASE SHILLER CAPACITY HH McGUIRE VA MEDICAL CENTER

CLARK♦NEXSEN

**4525 Main Street, Suite 1400
Virginia Beach, Virginia 23462
757/455-5800
Fax: 757/455-5638
<http://www.clarknexsen.com>**

SHEET TITLE:

REVISÉD SECTION E6

THIS SKETCH REVISED AS SHEET SB101

DESIGNED

JES

DATE 01-14-2015

DRAWN

RLC

JOB NO. 5090

CHECKED

SCALE $3/4"=1'-0"$

DWG. NO.

SKS-1

SHT. 1 OF 2