

GENERAL SHEET NOTES

- A. REFER TO ALL PHASING SHEETS. GENERAL CONTRACTOR SHALL ENSURE THAT ALL CONTRACTORS ARE RESPONSIBLE FOR COORDINATION ACROSS ENTIRE SET OF CONSTRUCTION DOCUMENTS.
- B. REFER TO ARCHITECTURAL REFLECTED CEILING PLANS FOR EXACT LOCATION OF ALL CEILING FIXTURES.
- C. EMERGENCY EGRESS LIGHTING FIXTURES SHALL BE UNSWITCHED.

SHEET KEYNOTES

- 1. TIE FIXTURE TO CIRCUIT AND SWITCHING IN CORRIDOR. REFER TO SHEET EL101a FOR CONTINUATION.
- 2. REFER TO DETAILS C1/ES01 AND B4/ES01 FOR DETAILS OF HEADWALL, EXAM LIGHT SWITCHING REQUIREMENTS.
- 3. PROVIDE GENERATOR TRANSFER DEVICE (GTD) FOR SWITCHING FOR INDICATED LIGHT FIXTURE.
- 4. CONTROL ROOM AND WING "B" LIGHT SWITCHES. REFER TO DETAIL "E1" THIS SHEET FOR SWITCHES AND SWITCH ASSIGNMENTS.



COORDINATION DRAWINGS

SEE COVER SHEET FOR COORDINATION NOTES.

SYMBOLS LEGEND

- EXISTING WALL, DOOR, WINDOW, MILLWORK, FIXTURE OR OTHER FIXTURE OR ASSEMBLY TO BE REMOVED.
- EXISTING WALL, DOOR, WINDOW, MILLWORK, FIXTURE OR OTHER FIXTURE OR ASSEMBLY TO REMAIN.
- NEW WALL
- 2-HOUR RATED FIRE BARRIER
- 1-HOUR RATED FIRE BARRIER
- SMOKE-TIGHT WALL
- AREA OF WORK
- NO PIPING OR DUCTWORK SHALL BE ROUTED THROUGH ELECTRICAL AND/OR DATA ROOMS.
- EXISTING CONCRETE COLUMN

KEYPLAN

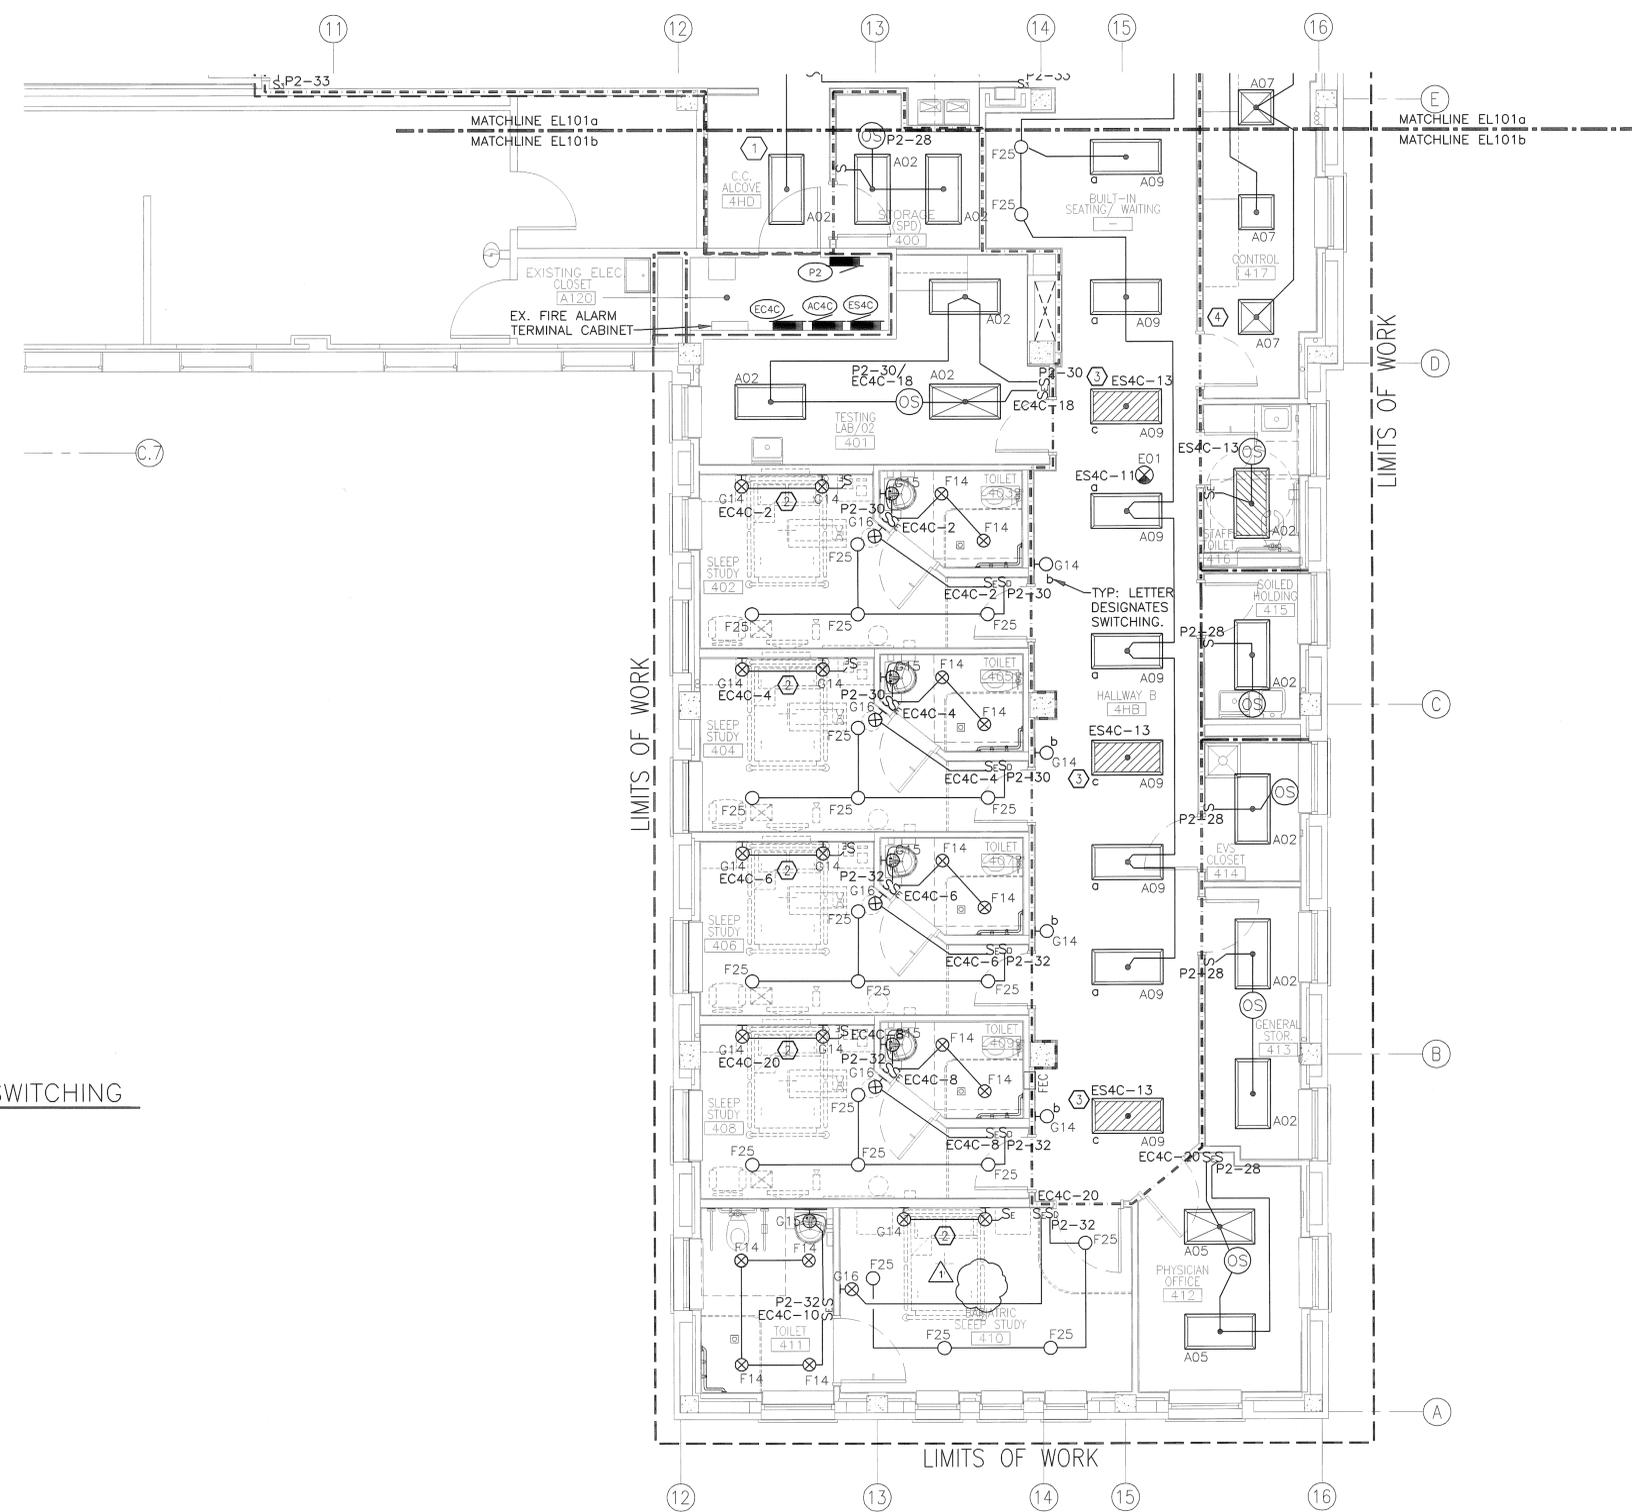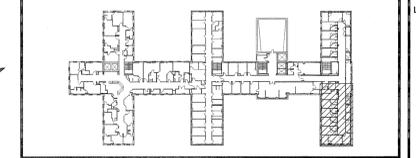


- P2-31 (CONTROL ROOM NORMAL)
- EC4C-18 (CONTROL ROOM CRITICAL)
- P2-33 (CORRIDOR NORMAL)
- P2-33 (CORRIDOR SCENCES)
- ES4C-13 (CORRIDOR LIFE SAFETY)

E1 PATIENT WING 'B' CONTROL ROOM/CORRIDOR SWITCHING
SCALE: NONE

F4 4TH FLOOR - LIGHTING PARTIAL - B FLOOR PLAN
SCALE: 1/4" = 1'-0"

REVISION NO.	REVISION DESCRIPTION	DATE
1	REVISION 1	01/20/2016

Department of Veterans Affairs
Create a Pulmonary Area with Sleep Labs
 2300 Ramsey St.
 Fayetteville, NC. 28301

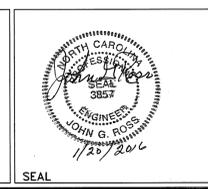

Architect/Engineer Address
HARRELL
 DESIGN GROUP, P.C.
 8016 TOWER POINT DRIVE
 CHARLOTTE, NC 28227
 P 704.814.1320
 F 704.321.0833
 www.harrellgroup.com
 COPYRIGHT © 2015 HARRELL DESIGN GROUP, PC
 HDC PROJECT # 13008

Recommended Approvals:	
1. MEDICAL DIRECTOR	6. OPERATIONS SERVICE LINE MANAGER
2. ASSOCIATE DIRECTOR	7. INFECTION CONTROL MANAGER
3. CHIEF OF STAFF	8. SAFETY MANAGER
4. ASSOC. DIRECTOR	9. GENERAL ENGINEER
5. SERVICE LINE MGRS.	10. COR

Drawing Title
4TH FLOOR - LIGHTING PARTIAL - B FLOOR PLAN

Project Title
CREATE A PULMONARY AREA WITH SLEEP LABS

Date
 11/13/2015

Project Number
 565-13-111

Drawn
 ELC

Building Number
 1

AutoCAD File Name
 DRAWING No.

Checked
 [Signature]

Reviewed
 [Signature]

Const. Contract No.
EL101b

Veterans Affairs