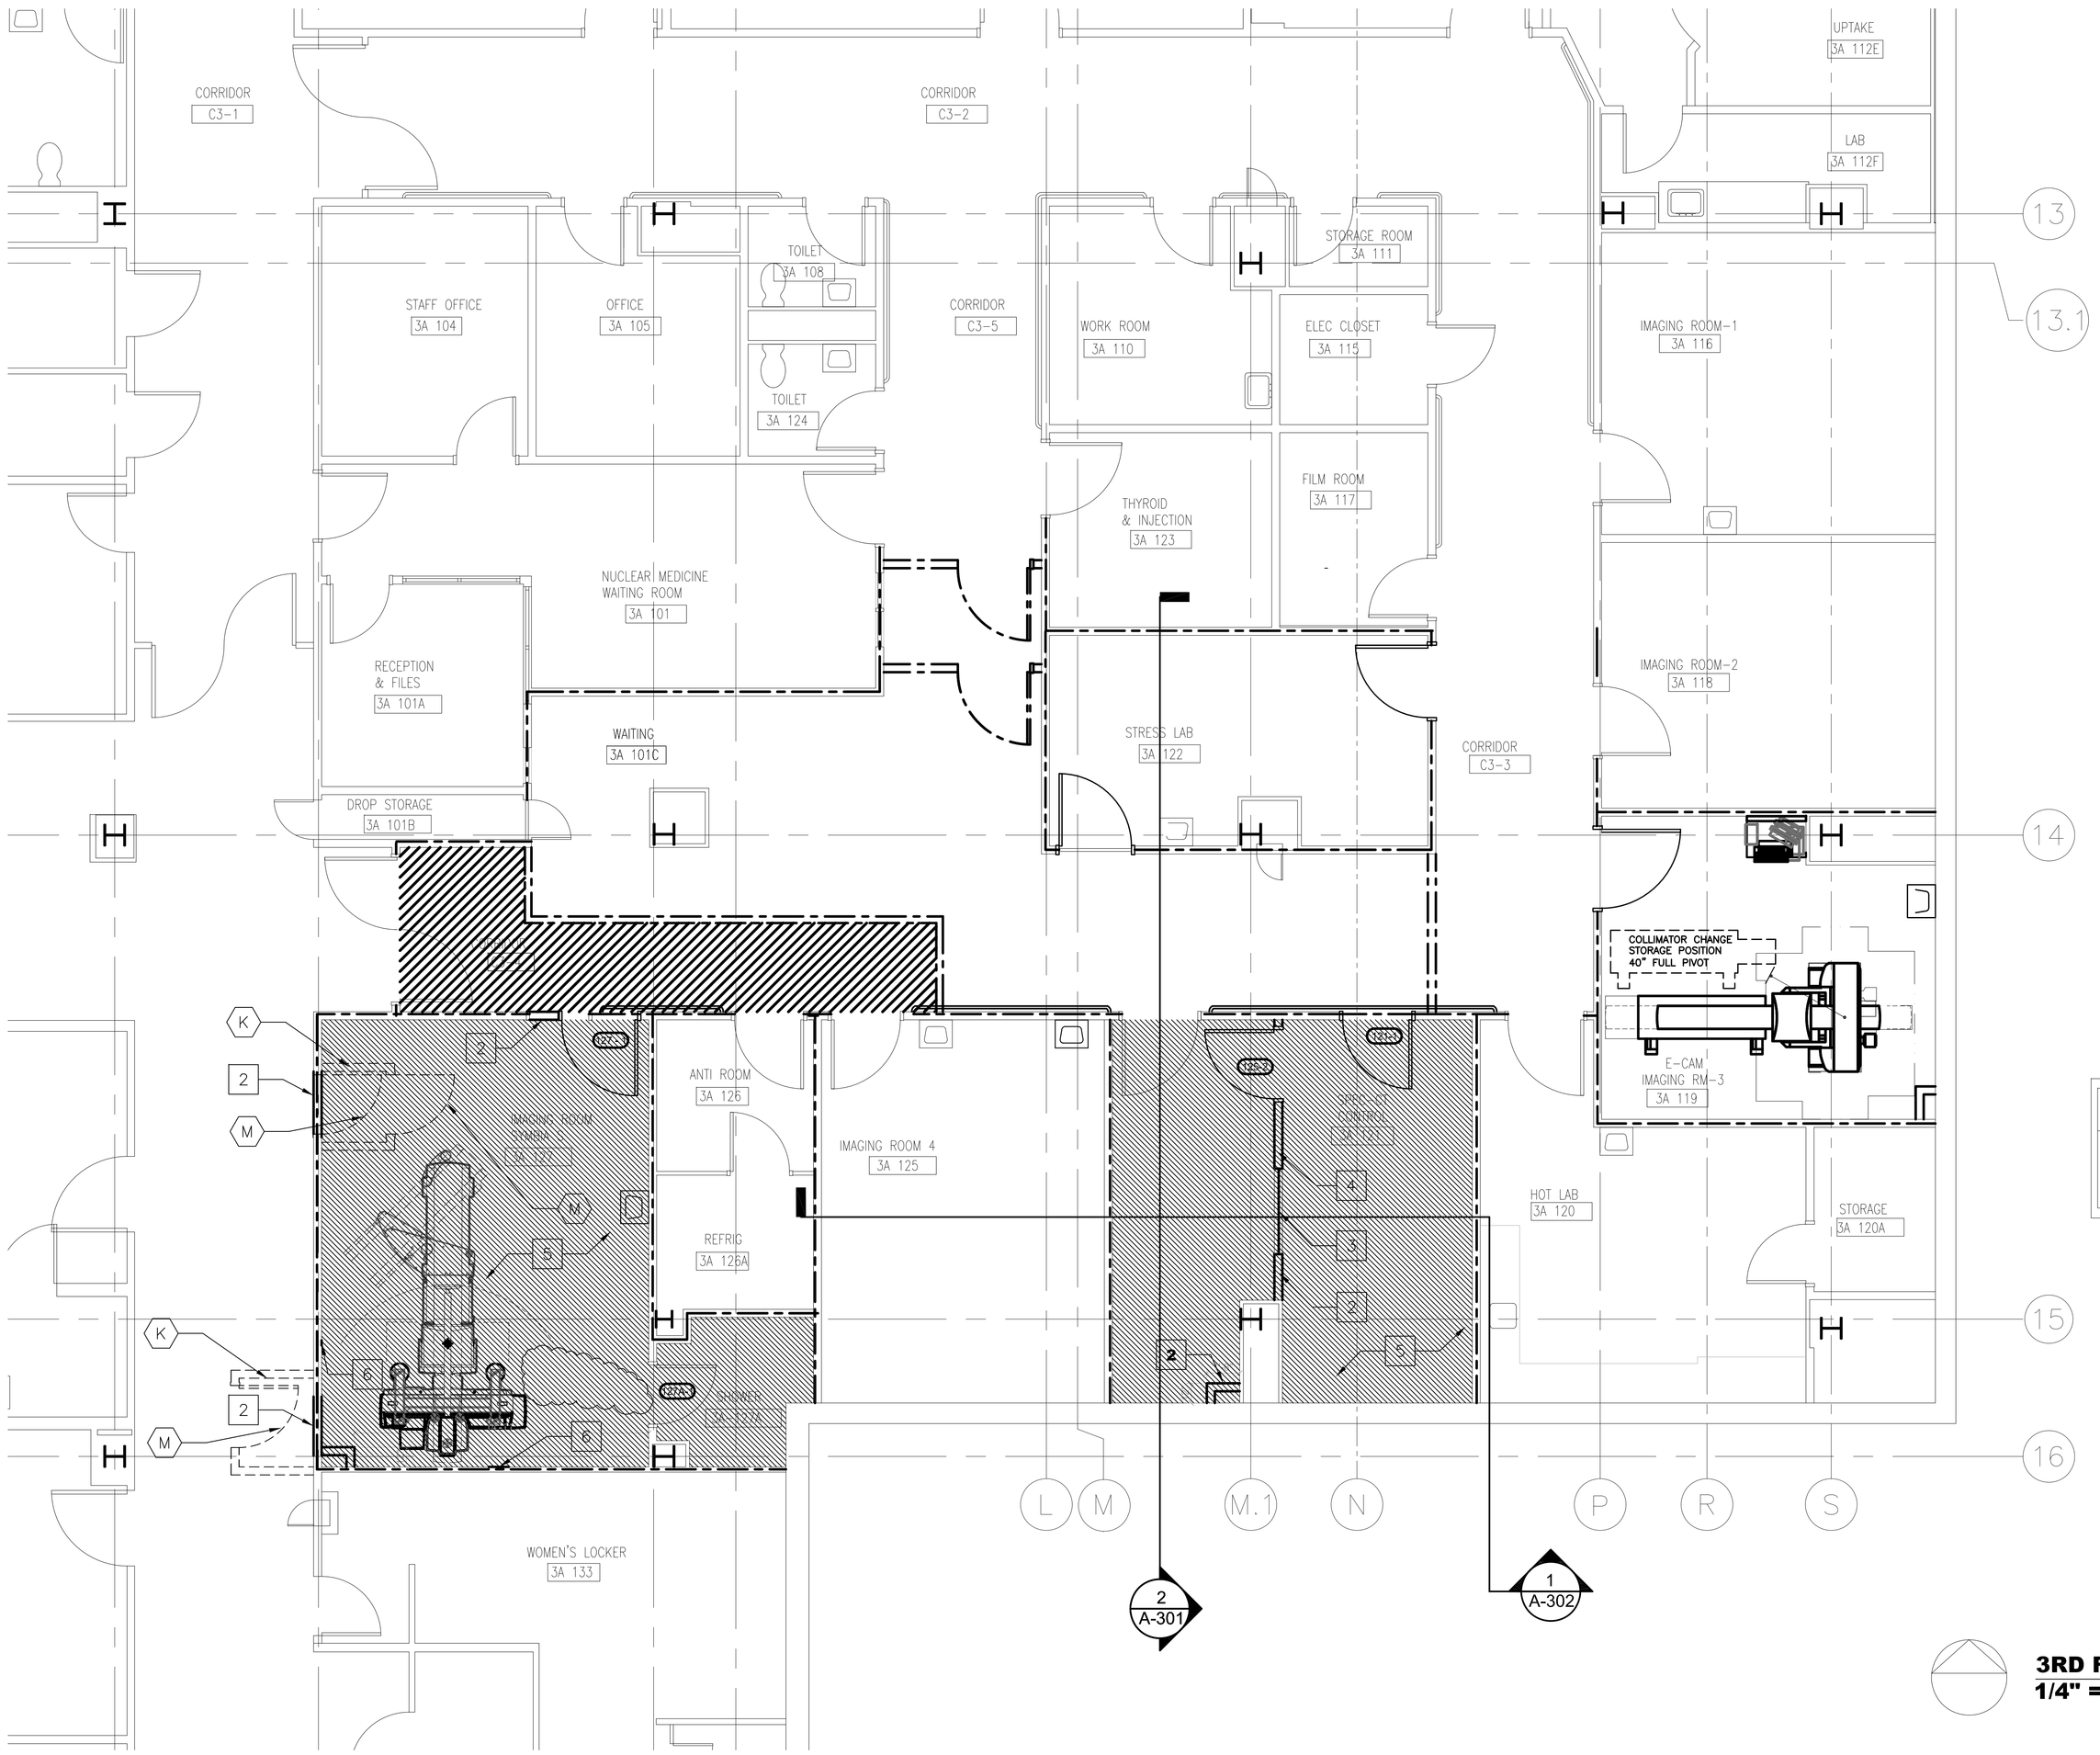

NEW WORK NOTES

1. 1 5/8 X 1 5/8" - 14 GA ELECTRO-GALVANIZED UNISTRUT CHANNELS @ 1'-6" O.C.
2. 3 5/8" METAL FRAMING AT 16" O.C. WITH ONE LAYER 5/8" FIRE RATED GWB EACH SIDE.
3. 4'-0" x 4'-0" HOLLOW METAL WINDOW FRAME WITH THE SAME ATTENUATION AS 1/16" LEAD EQUIVALENT W/ 1/16" LEAD EQUIVALENT AT 130 KEV LEAD GLASS
4. LEAD SHIELD ON 5/8" GWB IN WALL.
5. NEW 24"x24" ACOUSTICAL CEILING TILE SYSTEM.
6. PATCH WALL WITH 5/8" GWB.
7. LEAD SHIELD ON FLOOR SLAB.
8. 1/16" LEAD SHIELD ON 5/8" GWB ATTACHED TO UNISTRUT SYSTEM.
9. INSTALL PATIENT LIFT AND CEILING MOUNTED RAILS FROM ROOM 3A-125 CEILING IN ROOM 3A-127.
10. NEW FLOORING - SEE FINISH SCHEDULE
11. 3 5/8" METAL FRAMING @ 16" O.C. WITH ONE LAYER OF 5/8" FIRE RATED GW ON 3A-121 SIDE ONLY. SHIELDING GWB INSTALLED ON 3A-125 SIDE DURING PHASE 3.
12. UNSEAL DOOR AFTER CONSTRUCTION COMPLETED.
13. REWORK CEILING GRID TO ADJUST FOR MECHANICAL NEW WORK.
14. NEW HANDRAILS MEETING CURRENT PHILADELPHIA VAMC INTERIOR REQUIREMENTS SHALL BE MOUNTED TO MATCH CURRENT HANDRAIL LOCATIONS AND HEIGHTS
15. NEW 14'-6" X 2'-1" SOLID SURFACE COUNTERTOP WITH SOLID SURFACE BASE

LEGEND

- AREA OF DEMOLITION OR AREA OF NEW WORK
- NEW WALL
- EXISTING WALL TO REMAIN
- DEMO WALL OR ITEMS ABOVE OR BELOW
- WALL SHIELDING @ ROOM 3A 125

EXISTING DOOR | DEMO DOOR | NEW DOOR

3A-117 ROOM NUMBER / DOOR TAG

REVISION TAG

2 / A-301 SECTION OR WALL SECTION NUMBER

BARRIER LEGEND

- 1 HOUR RATED ICRA BARRIER SEE ICRA NOTE (A).
- 1 HOUR RATED ICRA CEILING BARRIER SEE ICRA NOTE (B).
- EXISTING WALL MODIFIED TO PROVIDE 1 HOUR RATED SMOKE-TIGHT WALL. SEE ICRA NOTE (C).
- DEMO 1 HOUR RATED ICRA BARRIER
- DEMO 1 HOUR RATED ICRA CEILING BARRIER

1 HOUR RATED ICRA DOOR | DEMO ICRA DOOR

PHASING NOTE

COMPLETE NEW WORK PHASE 2 PRIOR TO COMMENCING DEMOLITION PHASE 3

3RD FLOOR NEW WORK PLAN - PHASE 2
1/4" = 1'-0"

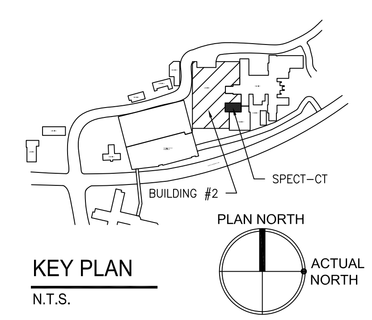

KEY PLAN
N.T.S.

CONSTRUCTION BID DOCUMENTS - BIDDER QUESTION RESPONSES
FULLY SPRINKLERED

NO.	DESCRIPTION	DATE

CONSULTANTS:

PF&A DESIGN
ARCHITECTURE, PLANNING, INTERIORS
World Trade Center
101 West Main Street, Suite 7000
Norfolk, VA 23510
Phone: 757-471-0537
Fax: 757-471-4205
www.pfa-architect.com - Project No: 2194.14A

COMMONWEALTH OF VIRGINIA
JOSEPH H. TROST
NO. 7843
ARCHITECT

ARCHITECT/ENGINEERS:

Miller-Remick *LLC*
M.E.P. & Structural Engineering
A Service Disabled Veteran Owned Small Business
1010 KINGS HIGHWAY SOUTH
CHERRY HILL, NEW JERSEY 08034
PHONE: (856)429-4000
FAX: (856)429-5002
M-R PROJECT NO: 0499-0030

SDVOSB

SKETCH Title: **THIRD FLOOR NEW WORK PLAN - PHASE 2**	Project Title: NEW SPECT-CT INSTALLATION	Project Number: 642-13-120	Office of Construction and Facilities Management
Approved: Project Director	Location: V.A.M.C. PHILADELPHIA, PA	Building Number: 2	
		SKETCH Number: **SK-A6**	
	Date: 02-02-2016 / Checked: **JSG** / Drawn: **KOR**	BID DWG Revised: **P2 A-101**	Department of Veterans Affairs

VA FORM 08-6231