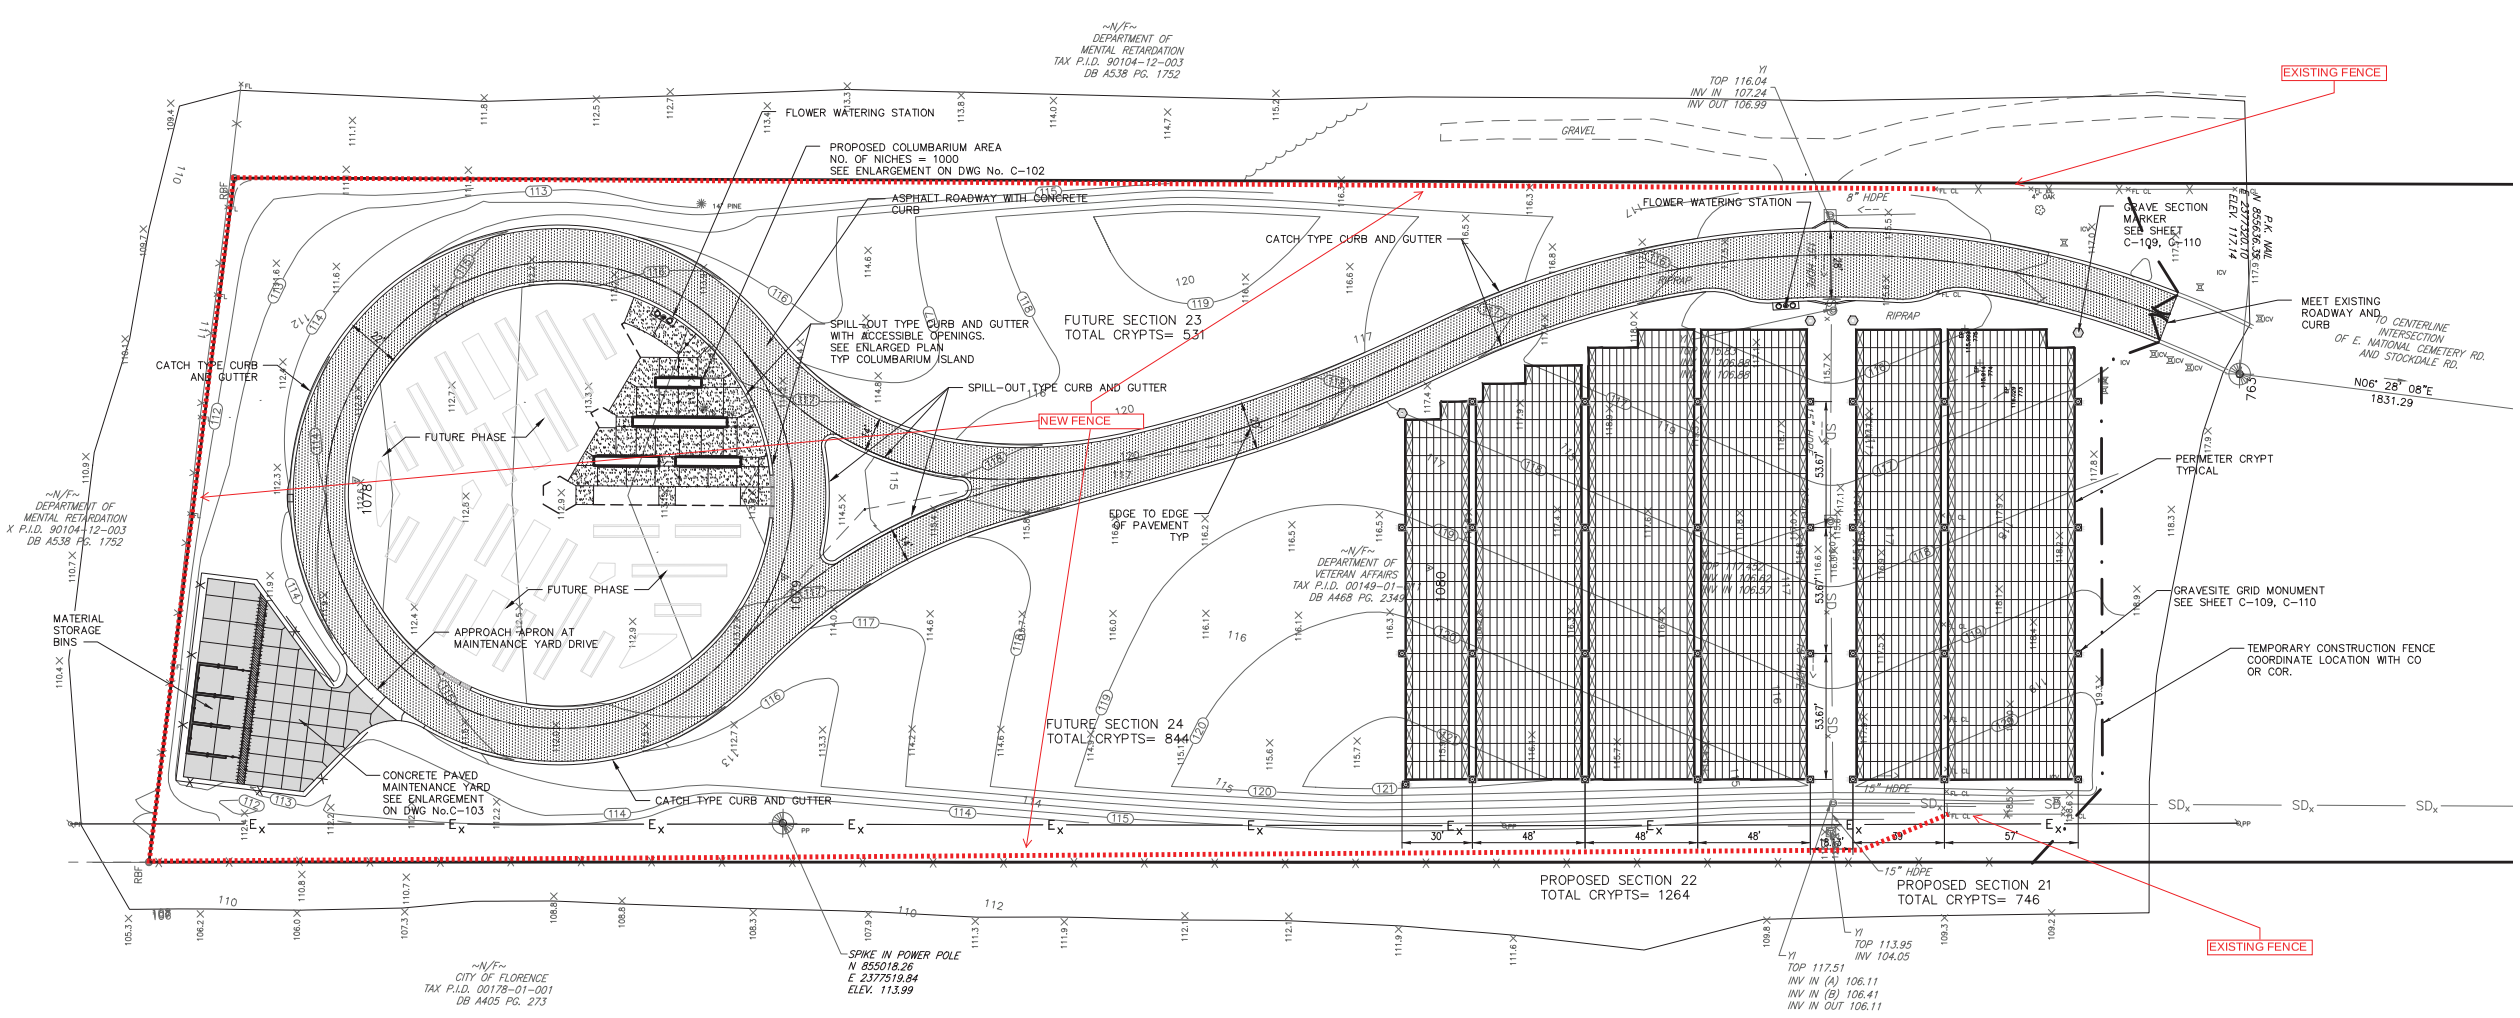

YIELD TABLE		
SECTION	TYPE	NUMBER
21	PRE-PLACED CRYPTS	746
22	PRE-PLACED CRYPTS	1264
COLUMBARIUM	NICHES	1000
TOTAL YIELD		3010

NOTES:
1. FOR GRAVE SITE NUMBERING SEE DRAWINGS C-109 AND C-110.
2. SEE DRAWING C-102 FOR COLUMBARIUM AREA ENLARGEMENT.
3. SEE DRAWING C-103 FOR MAINTENANCE YARD AREA ENLARGEMENT.

0 30' 60'
SCALE:1"= 30'

FINAL CONSTRUCTION DOCUMENTS	03/03/2015
FINAL CONSTRUCTION DOCUMENTS	05/15/2014
100% CONSTRUCTION DOCUMENTS	03/27/2014
70% DESIGN DEVELOPMENT SUBMITTAL	01/14/2014
Revisions:	Date

CONSULTANTS:

Aqua Engineering, Inc.
Innovative Water Solutions
4603 Innovation Drive
Fort Collins, Colorado 80525
Phone (970) 229-9668
FAX (970) 226-3855

ARCHITECT/ENGINEERS:

SMITHGROUP JJR
201 DEPOT STREET
SECOND FLOOR
ANN ARBOR, MI 48104
734.662.4457
www.smithgroupjjr.com

Drawing Title: OVERALL SITE PLAN

Approved Project Director:

Project Title: Florence National Cemetery Gravesite Expansion

Location: Florence, South Carolina

Date: MARCH 14, 2014 | Checked: MEL | Drawn: RKA

Project Number: 843CM3021

JJR Project Number: 50700.000

Drawing Number: C-101
Dwg 11 of 37

National Cemetery Administration

Department of Veterans Affairs

VA FORM 08-6231