REVISIONS				
LET	DESCRIPTION	PREP'D BY	DATE	APPROVED
REV. A →	AS-BUILT DRWG. NO CORRECTIONS	GREG	40CT82	MURDOCK

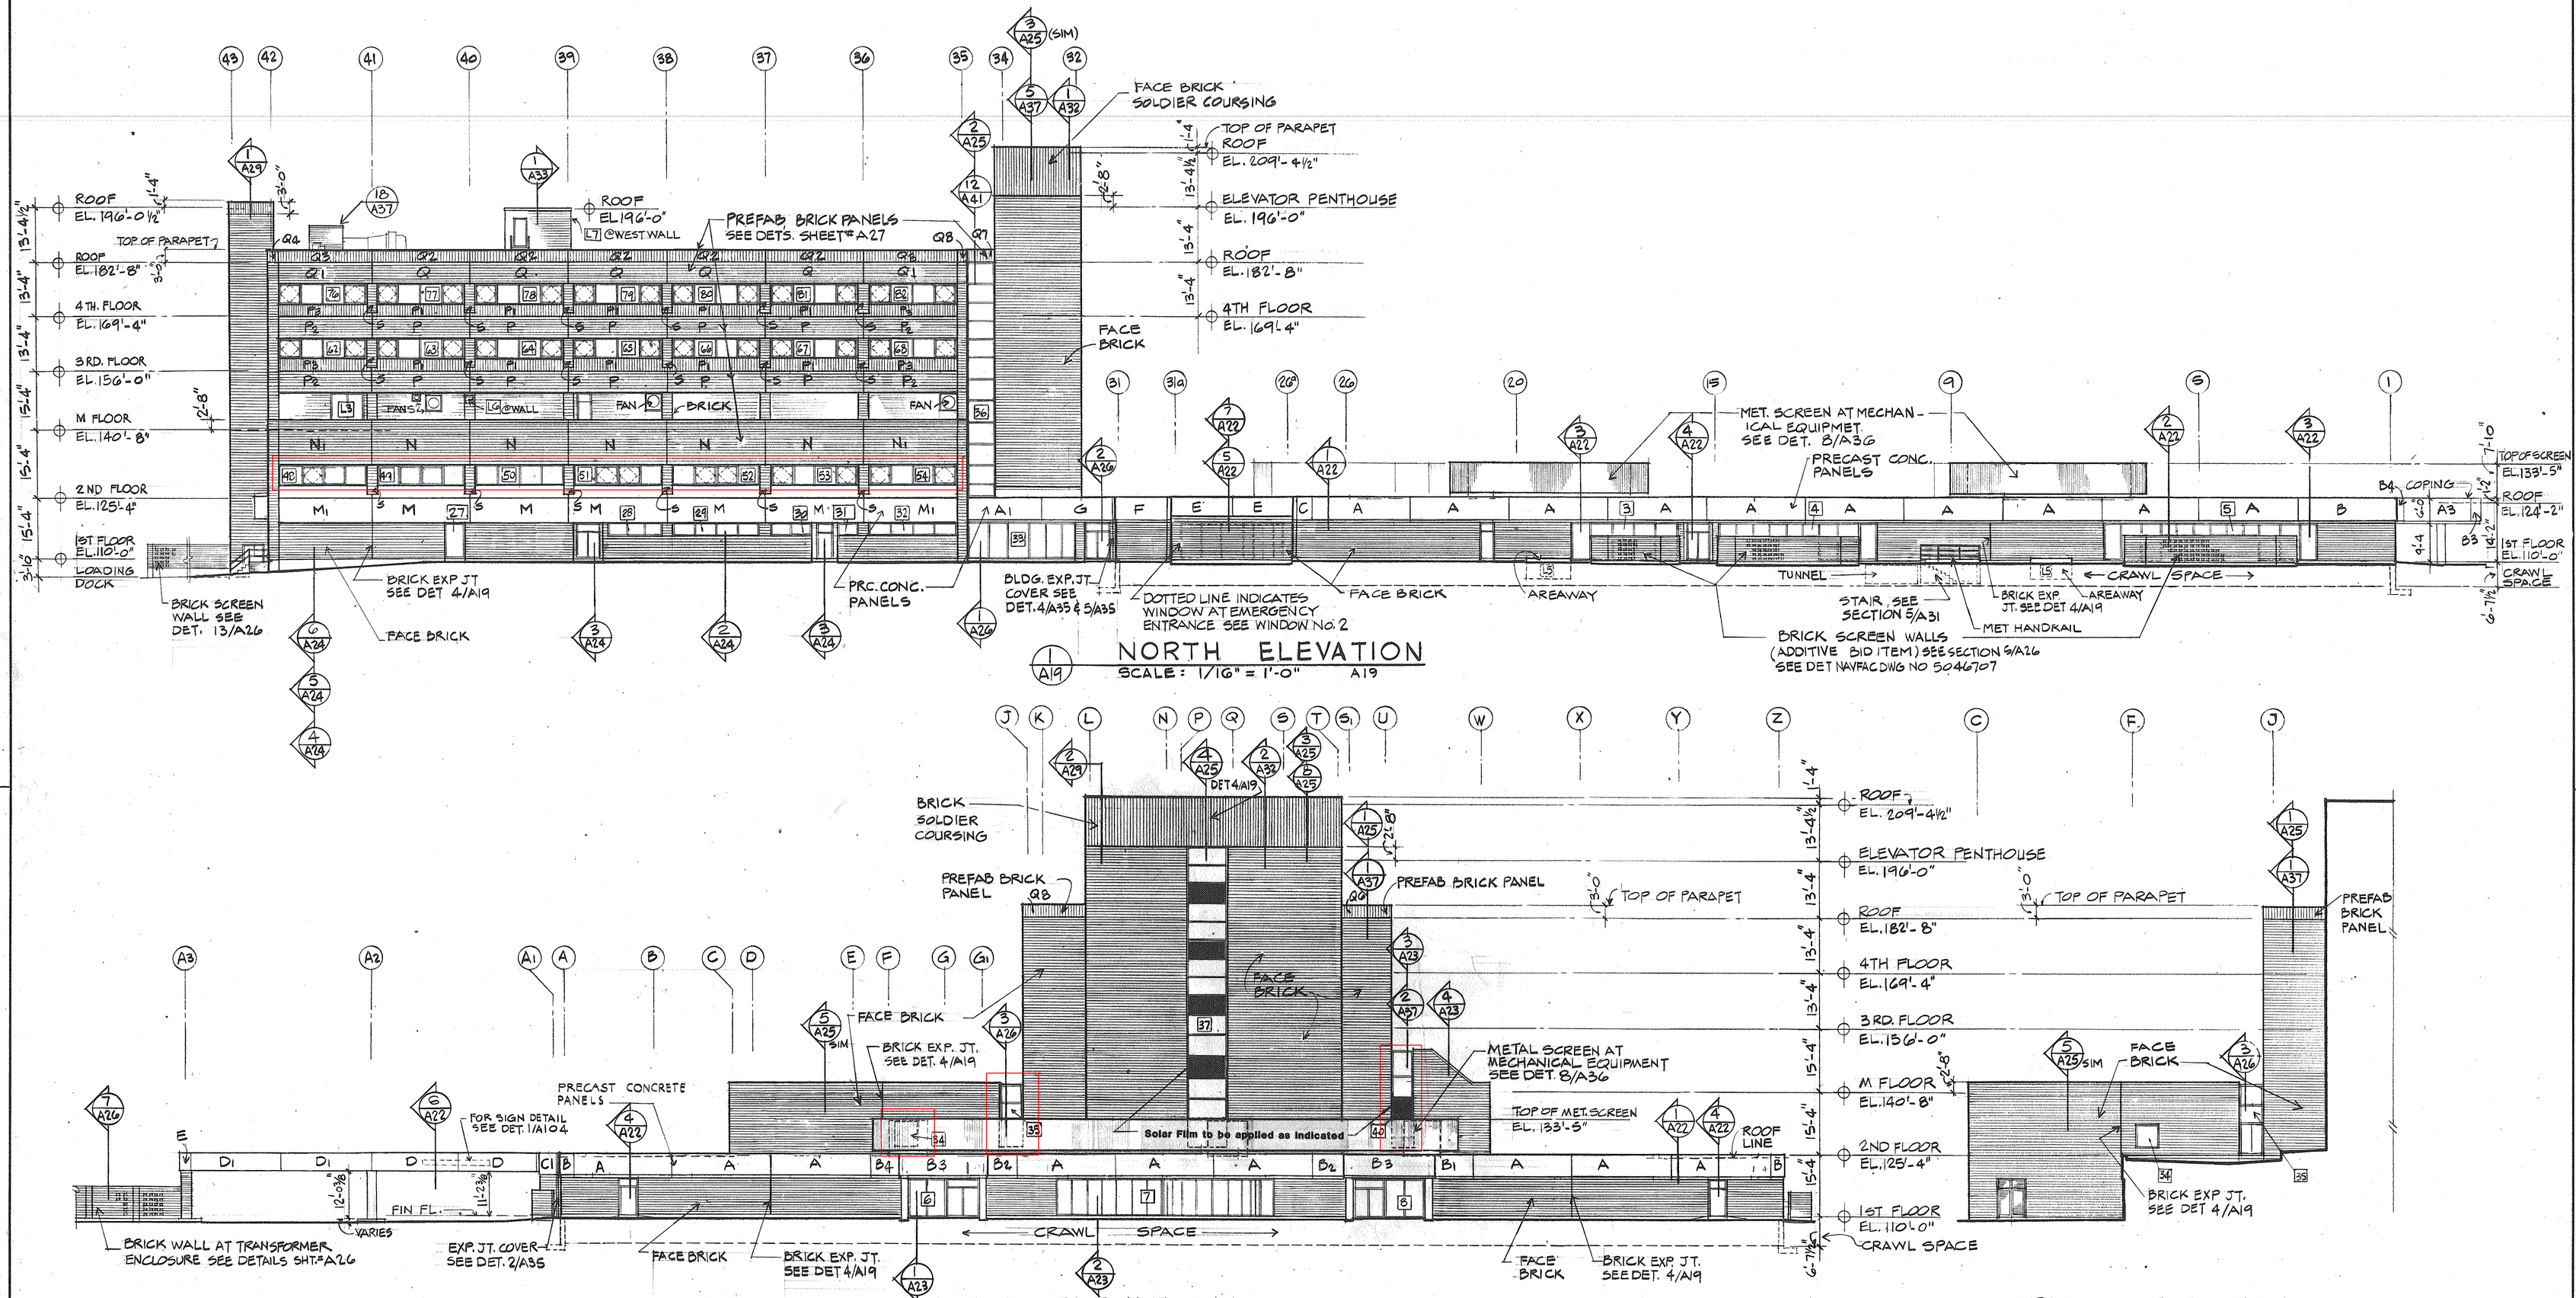

1/A19 NORTH ELEVATION
SCALE: 1/16" = 1'-0" A19

2/A19 WEST ELEVATION
SCALE: 1/16" = 1'-0" A19

3/A19 PARTIAL ELEVATION
SCALE 1/16" = 1'-0" A19

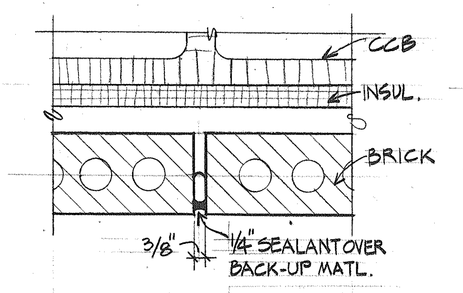

4/A19 DETAIL
SCALE 3" = 1'-0" A19, A20, A21

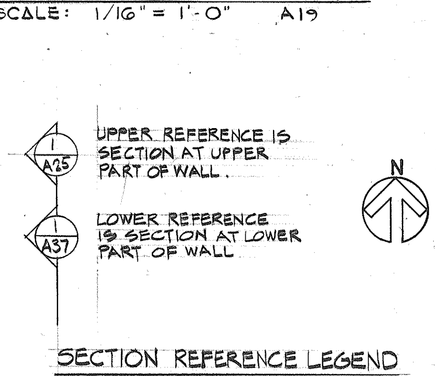

SECTION REFERENCE LEGEND

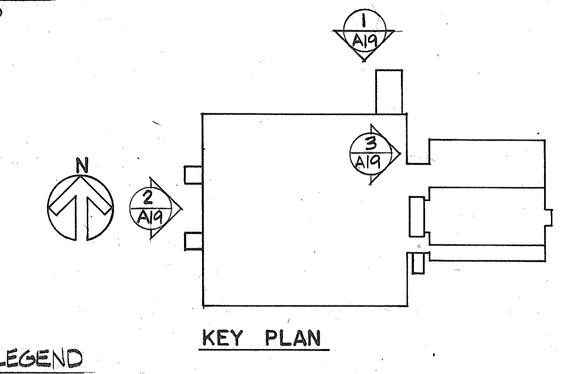

KEY PLAN

GRAPHIC SCALES
1/16" = 1'-0" 8' 0 10' 20' 30' 40'

RECORD DRAWING
DATE 11-82

NOTE:
ONLY WORK REQUIRED UNDER CONTRACT N 62467-81-C-2516, WORK ORDER NO. 11, DEC. 1981, ARE THE INDICATED SOLAR FILM FOR THE WINDOWS

ROGERS, LOVELOCK, FRITZ, ROGERS & BUTLER / LOPATKA, McQUAIG & WALL CORPORATION
ARCHITECTS - ENGINEERS - PLANNERS
WINTER PARK, FLORIDA 32789

DEPARTMENT OF THE NAVY NAVAL FACILITIES ENGINEERING COMMAND
SOUTHERN DIVISION
CHARLESTON, S. C.

DSGN JAMMAL DR JAMMAL CHK MURDOCK
SUPV MURDOCK CH ENGR MARTEN
SUBMITTED BY [signature] DATE 28 FEB 77
FIRM MEMBER / PRINCIPLE / PARTNER
SOUTHERN DIV - N DESIGN DIVISION
PDE [signature] DIR

NAVAL REGIONAL MEDICAL CENTER ORLANDO, FLORIDA

HOSPITAL REPLACEMENT

EXTERIOR ELEVATIONS SHEET 1 OF 2

APPROVED DATE
OFFICER IN CHARGE
APPROVED [signature] PE DATE
EFD FOR COMMANDER, NAVFAC

SIZE	CODE IDENT NO.	NAVFAC DRAWING NO.
F	80091	5046700

CONSTR CONTR NO. N62467-75-C-0340
SCALE 1/16" = 1'-0" SPEC 06-75-0340 | SHEET 109 OF

A19

K&E 10 1183 10-75 W3258* END-SOUTH DIV-4-11012-15 CAROLINA EAP P452