


NOTE: EXCEPT AS SPECIFICALLY STATED OR SHOWN ON THIS PLAT, THIS SURVEY DOES NOT PURPORT TO REFLECT ANY OF THE FOLLOWING WHICH MAY BE APPLICABLE TO THE SUBJECT REAL ESTATE: RIGHTS-OF-WAY, EASEMENTS, OTHER THAN POSSIBLE EASEMENTS THAT WERE VISIBLE AT THE TIME OF MAKING THIS SURVEY; BUILDING SETBACK LINES; RESTRICTIVE COVENANTS; SUBDIVISION RESTRICTIONS; ZONING OR OTHER LAND USE REGULATIONS AND ANY OTHER FACTS THAT AN ACCURATE AND CURRENT TITLE SEARCH MAY DISCLOSE. - ANY FLOOD PLAIN DATA SHOWN HEREON IS AN APPROXIMATE LOCATION GRAPHICALLY PLOTTED FROM THE REFERENCED FEMA MAP UNLESS OTHERWISE NOTED. - THIS SURVEY DOES NOT CONSTITUTE A TITLE RESEARCH, FLOOD STUDY, WETLAND DELINEATION OR ENVIRONMENTAL INSPECTION BY SURVEYOR. - THIS SURVEY, AND ALL COPIES THEREOF, ARE INVALID WITHOUT THE ORIGINAL SIGNATURE, DATE, AND EMBOSSED SEAL OF ROBERT C. HOOKS, SOUTH CAROLINA PROFESSIONAL SURVEYOR No. 26598. THE WORD "CERTIFY" OR "CERTIFICATE" IS AN EXPRESSION OF PROFESSIONAL OPINION REGARDING THE FACTS OF THE SURVEY AND DOES NOT CONSTITUTE A WARRANT OR GUARANTEE, EXPRESSED OR IMPLIED.

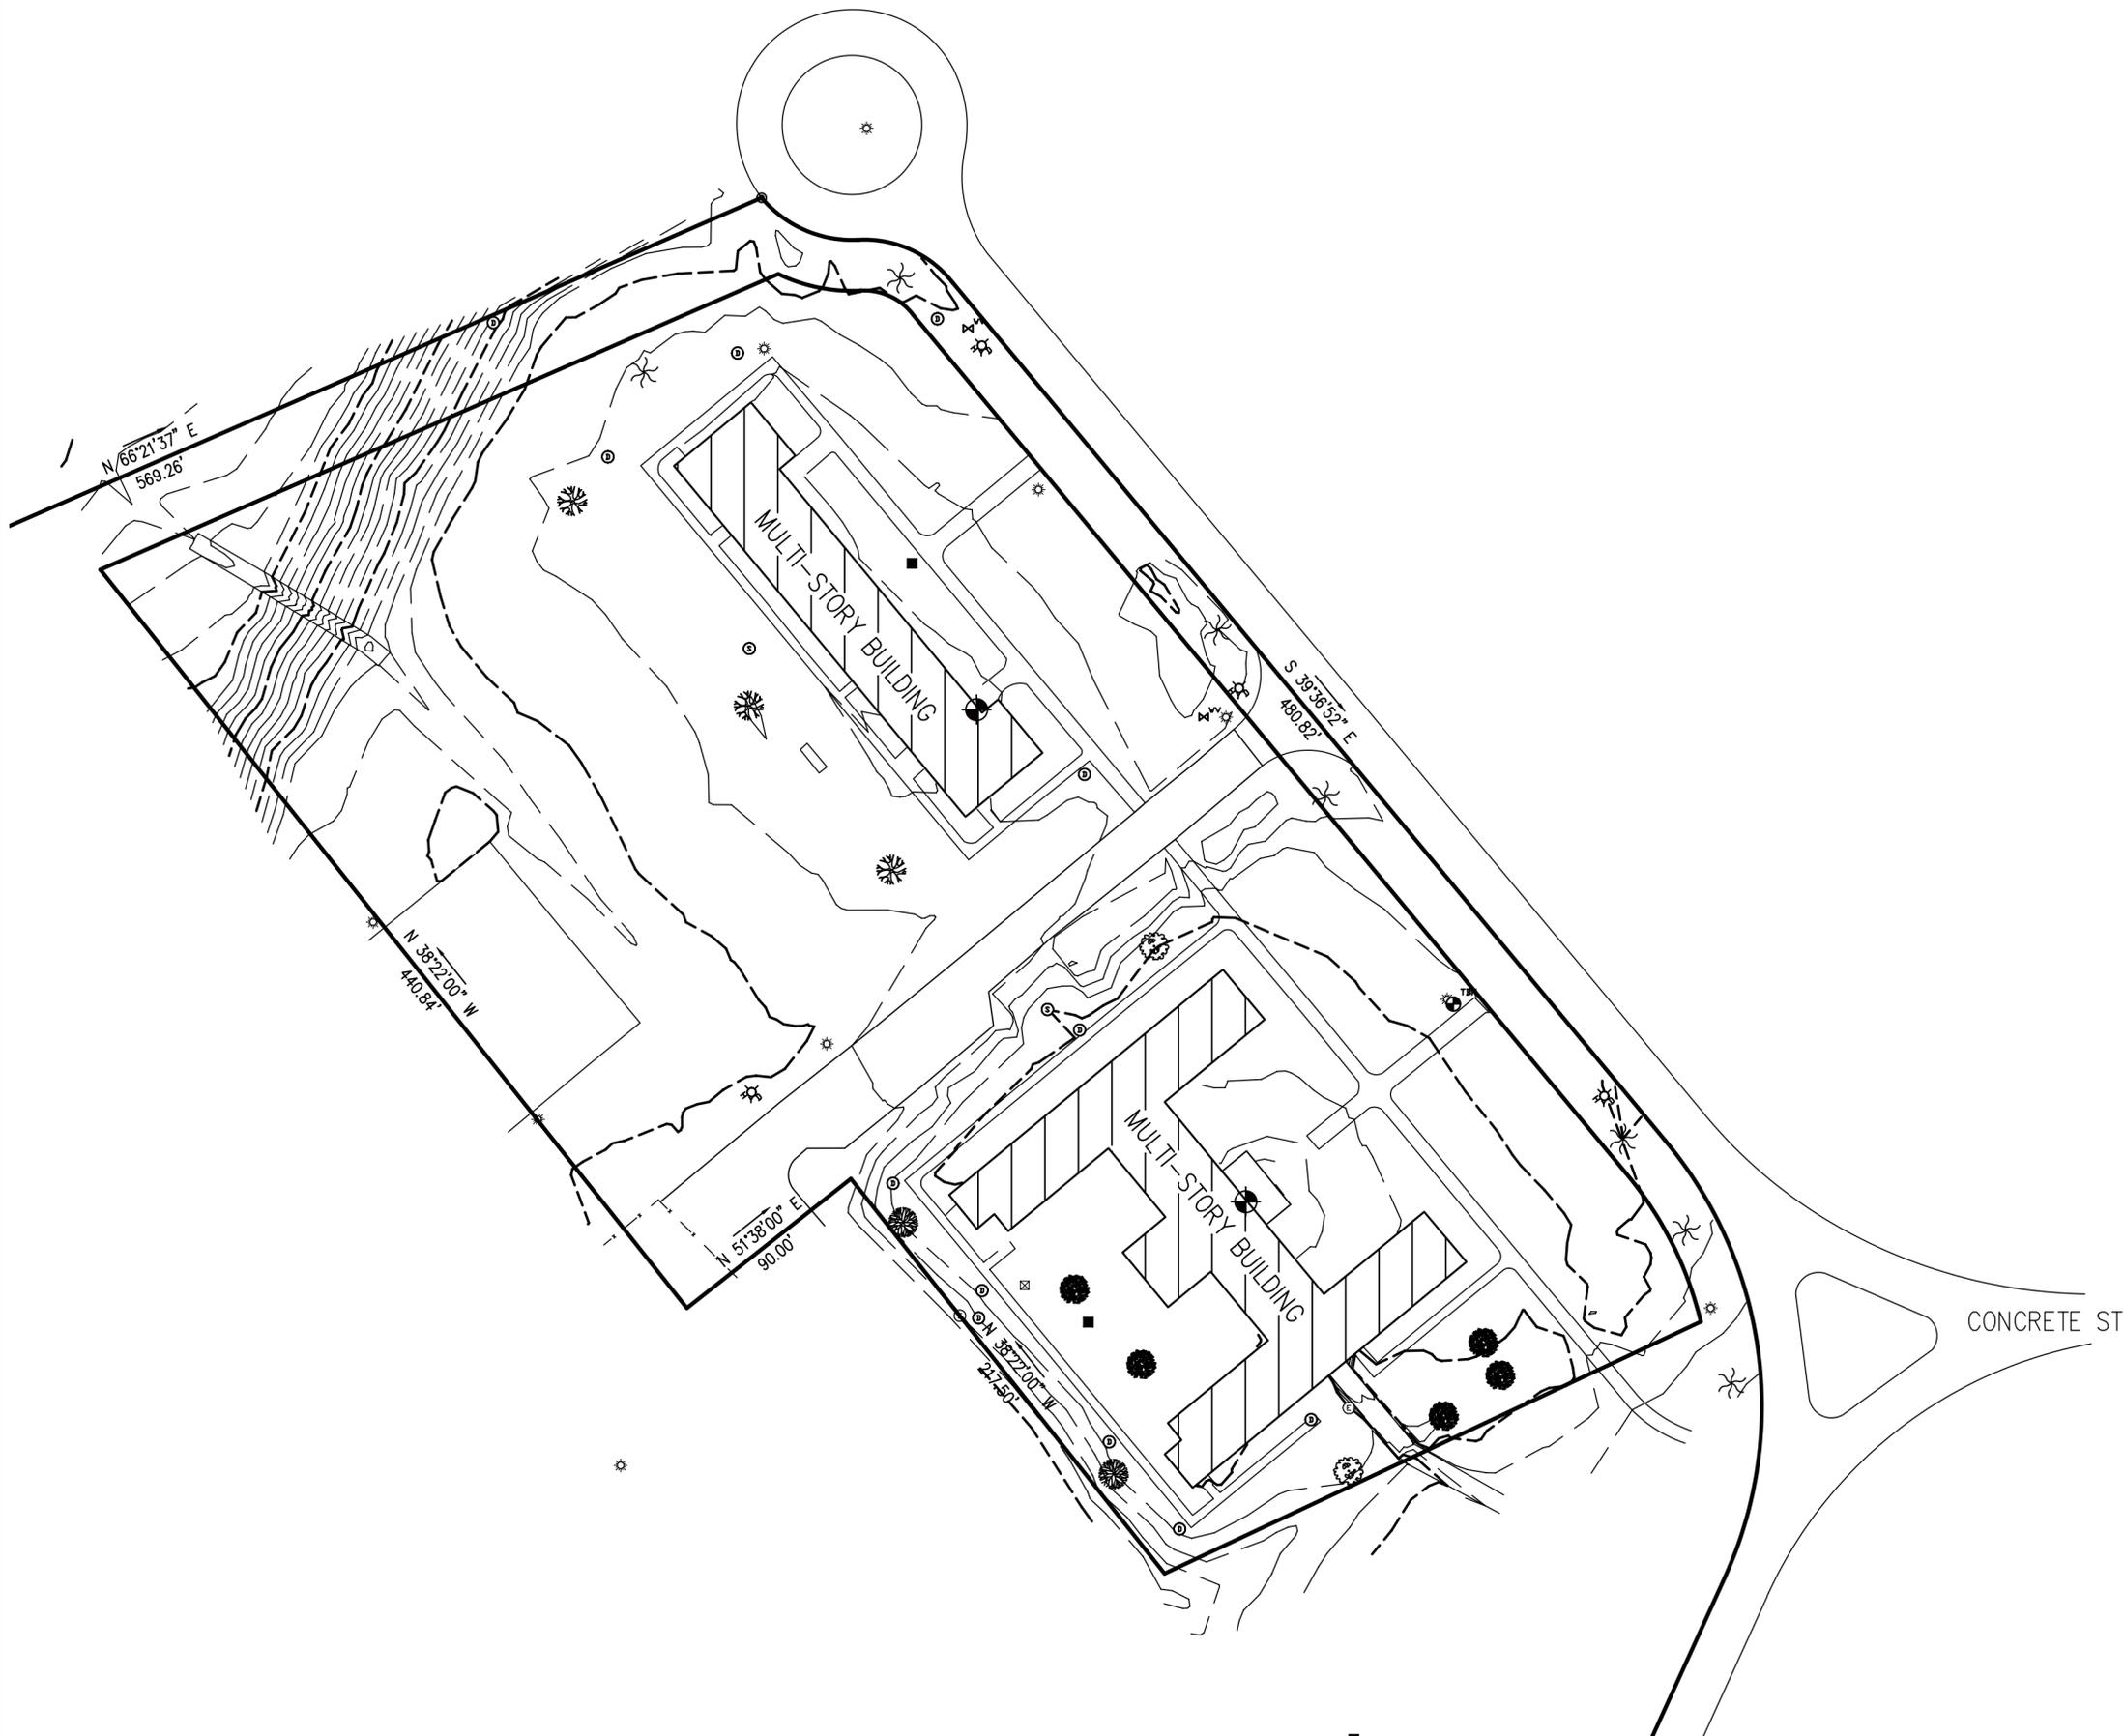

ARROW NORTH SURVEYING, LLC

LAND SURVEYORS & MAPPERS
509 PIMLICO ROAD
GREENVILLE, SC 29607
PH: (864) 449-1289
www.ArrowNorthSurveying.com

SURVEY FOR V.A. HOSPITAL DUBLIN, GEORGIA

PROPERTY ADDRESS
XXXXXXXXXXXXXXXXXX

50 0 50 100 SCALE
1" = 50'


TAX PIN
XXXXXX

DATE 4/30/2015 FIELD CREW RCH / JC DRAWN BY RCH

LOCATION MAP NOT TO SCALE

| LEGEND | | |
|-----------------------|------------------------|-----------------|
| BL BUILDING LINE | TC/BC TOP/BOTTOM CURB | CB CATCH BASIN |
| CT CRIMP TOP | TW/BW TOP/BOTTOM WALL | DI DROP INLET |
| DE DRAINAGE EASEMENT | EM ELECTRIC METER | ET ELEC TRANS |
| EP EDGE OF PAVEMENT | WM WATER METER | EL ELEVATION |
| IPO IRON PIN OLD | WV WATER VALVE | FH FIRE HYDRANT |
| IPS IRON PIN SET | CTV CABLE TV | GM GAS METER |
| N&C NAIL & CAP | FENCE LINE | GV GAS VALVE |
| OT OPEN TOP | FOC FIBER OPTIC CABLE | LP LIGHT POLE |
| RB REBAR | GAS GAS LINE | PP POWER POLE |
| R/W RIGHT OF WAY | OHP OVERHEAD POWER | GP GUY ANCHOR |
| SD STORM DRAIN | OHT OVERHEAD TEL | |
| SS SANITARY SEWER | SD STORM DRAIN | |
| SSE SS EASEMENT | SS SANITARY SEWER | |
| SDMH SD MANHOLE | UGP UNDERGROUND POWER | |
| SSMH SS MANHOLE | UGT UNDERGROUND TEL | |
| CO CLEAN OUT | W WATER LINE | |
| TMH TELEPHONE MANHOLE | TEL TELEPHONE PEDESTAL | |

SURVEYOR'S NOTES

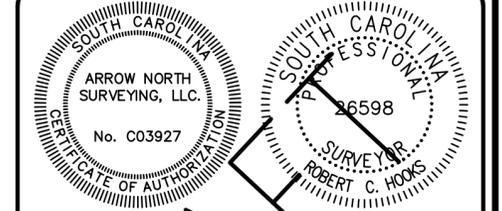

THIS SURVEY, AND ALL COPIES THEREOF, ARE INVALID WITHOUT THE ORIGINAL SIGNATURE, DATE, AND EMBOSSED SEAL OF ROBERT C. HOOKS

I HEREBY STATE TO THE BEST OF MY KNOWLEDGE, INFORMATION, AND BELIEF, THE SURVEY SHOWN HEREON WAS MADE IN ACCORDANCE WITH THE REQUIREMENTS OF THE MINIMUM STANDARDS MANUAL FOR THE PRACTICE OF LAND SURVEYING IN SOUTH CAROLINA, AND MEETS OR EXCEEDS THE REQUIREMENTS FOR A CLASS "B" SURVEY AS SPECIFIED THEREIN, ALSO THERE ARE NO KNOWN VISIBLE ENCROACHMENTS OR PROJECTIONS AFFECTING THE PROPERTY OTHER THAN THOSE SHOWN.

ROBERT C. HOOKS, P.S. DATE
S.C. REG. NO. 26598